
S.W.S. 266


PROJECT NO. 468-76-245-81369-000-000-001

TO SERVE LOT 1, SECURITY STORAGE PROPERTIES ADDITION

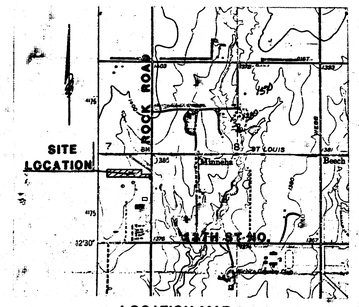

LOCATION MAP

N

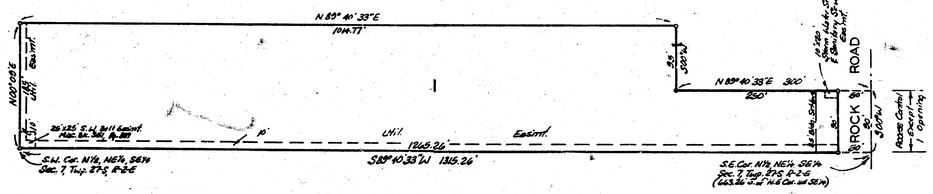

BENEFIT DISTRICT

As Built Plans
7-17-85
M.C. Greene

GENERAL NOTES

The contractor shall coordinate the construction of this project with the construction and contractor of Lateral 33, Main 22, W.I.S. which also is to serve this property.

The contractor shall contact the necessary utility companies in order to have any underground utilities located in the field prior to proceeding with construction of this project.

The ditch at the outfall section of the discharge pipe shall be excavated to provide the best flo possible from the pipe. The engineer shall determine the amount of excavation to be performed at this location. The cost of the ditch excavation shall be considered as incidental to the cost of the pipe.

CITY OF WICHITA, KANSAS

MICHAEL E. LINDEBAK

CITY ENGINEER


R. KENT DOOLEY LICENSED PROFESSIONAL ENGINEER 6470 KANSAS

MARCH 1985

BAUGHMAN COMPANY, P.A.
SURVEYING & ENGINEERING
315 262-7271 · 330 LAURA · WICHITA, KANSAS 67211


1/2

BENCH MARK: CITY DISC @ ROCK ROAD & 17TH ST. NORTH, 28' E OF ℄ ROCK ROAD & 51' NORTH OF ℄ R.R. TRACKS
ELEV. = 1301.70 CITY DATUM

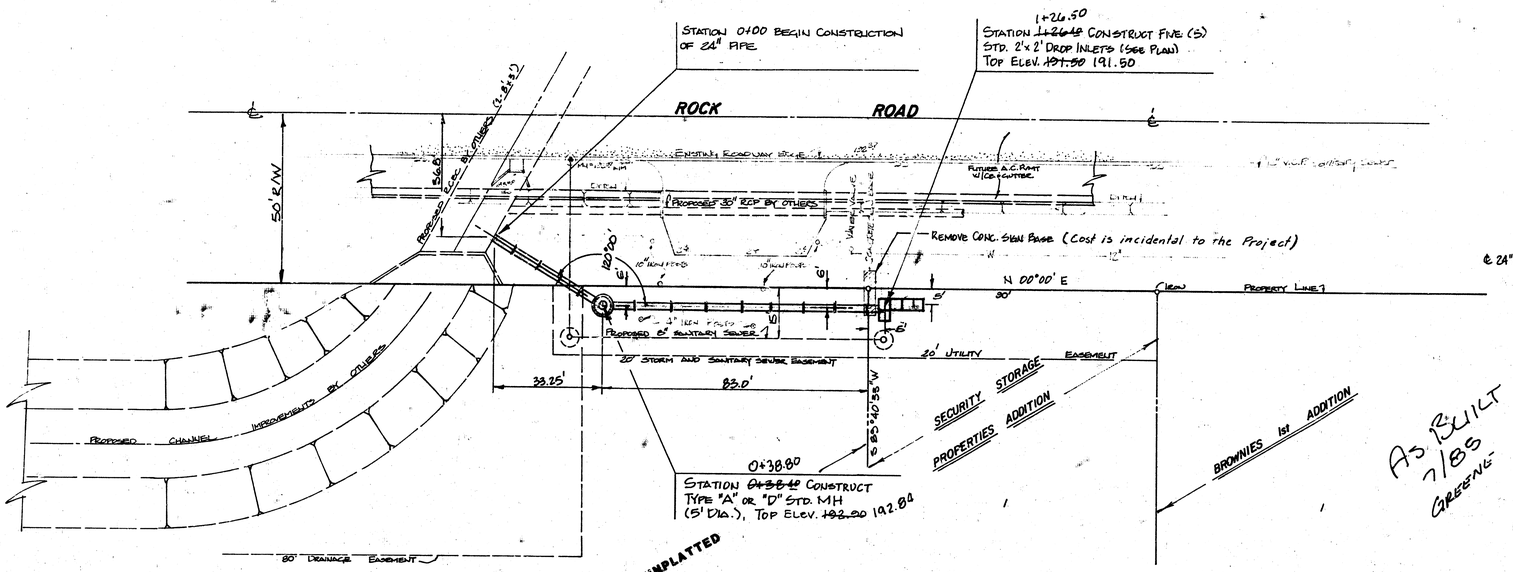


N

SCALE: 1" = 20' PLAN
1" = 5' PROFILE

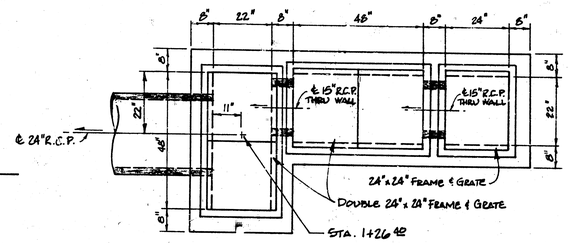

NOTE: INLET CONSTRUCTION PER CITY OF WICHITA STANDARD DROP INLET DETAILS.

INLET PLAN

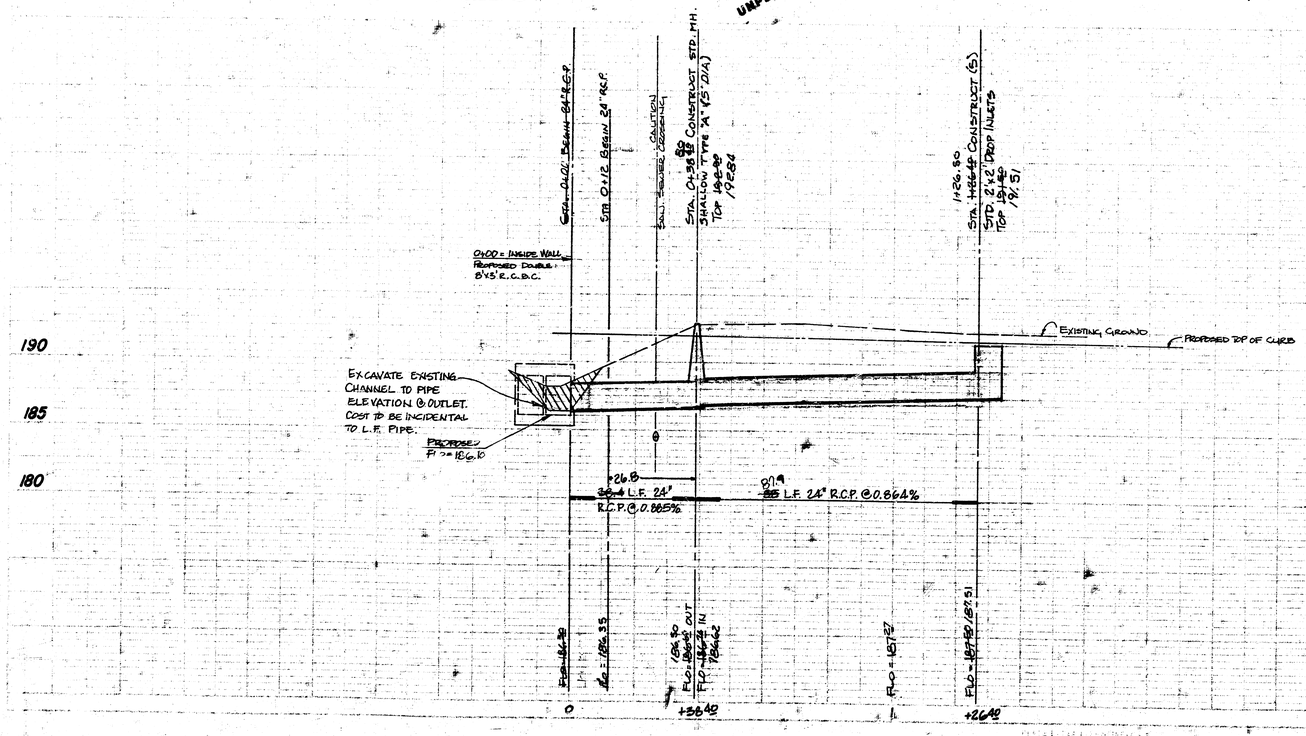

AS BUILT 7/85 GREENE

S.W.S. No. 266
STORM WATER SEWER TO SERVE LOT 1 SECURITY STORAGE PROPERTIES ADDITION
PROJECT NO. 468-76-246-81389-000-000-001
CITY OF WICHITA, KS
BAUGHMAN COMPANY, P.A. SURVEYING & ENGINEERING 316/262-7271 • 330 LAURA • WICHITA, KANSAS 67211

AT 10 3 8½