


E.L. Cabinda to W.L. Bladby

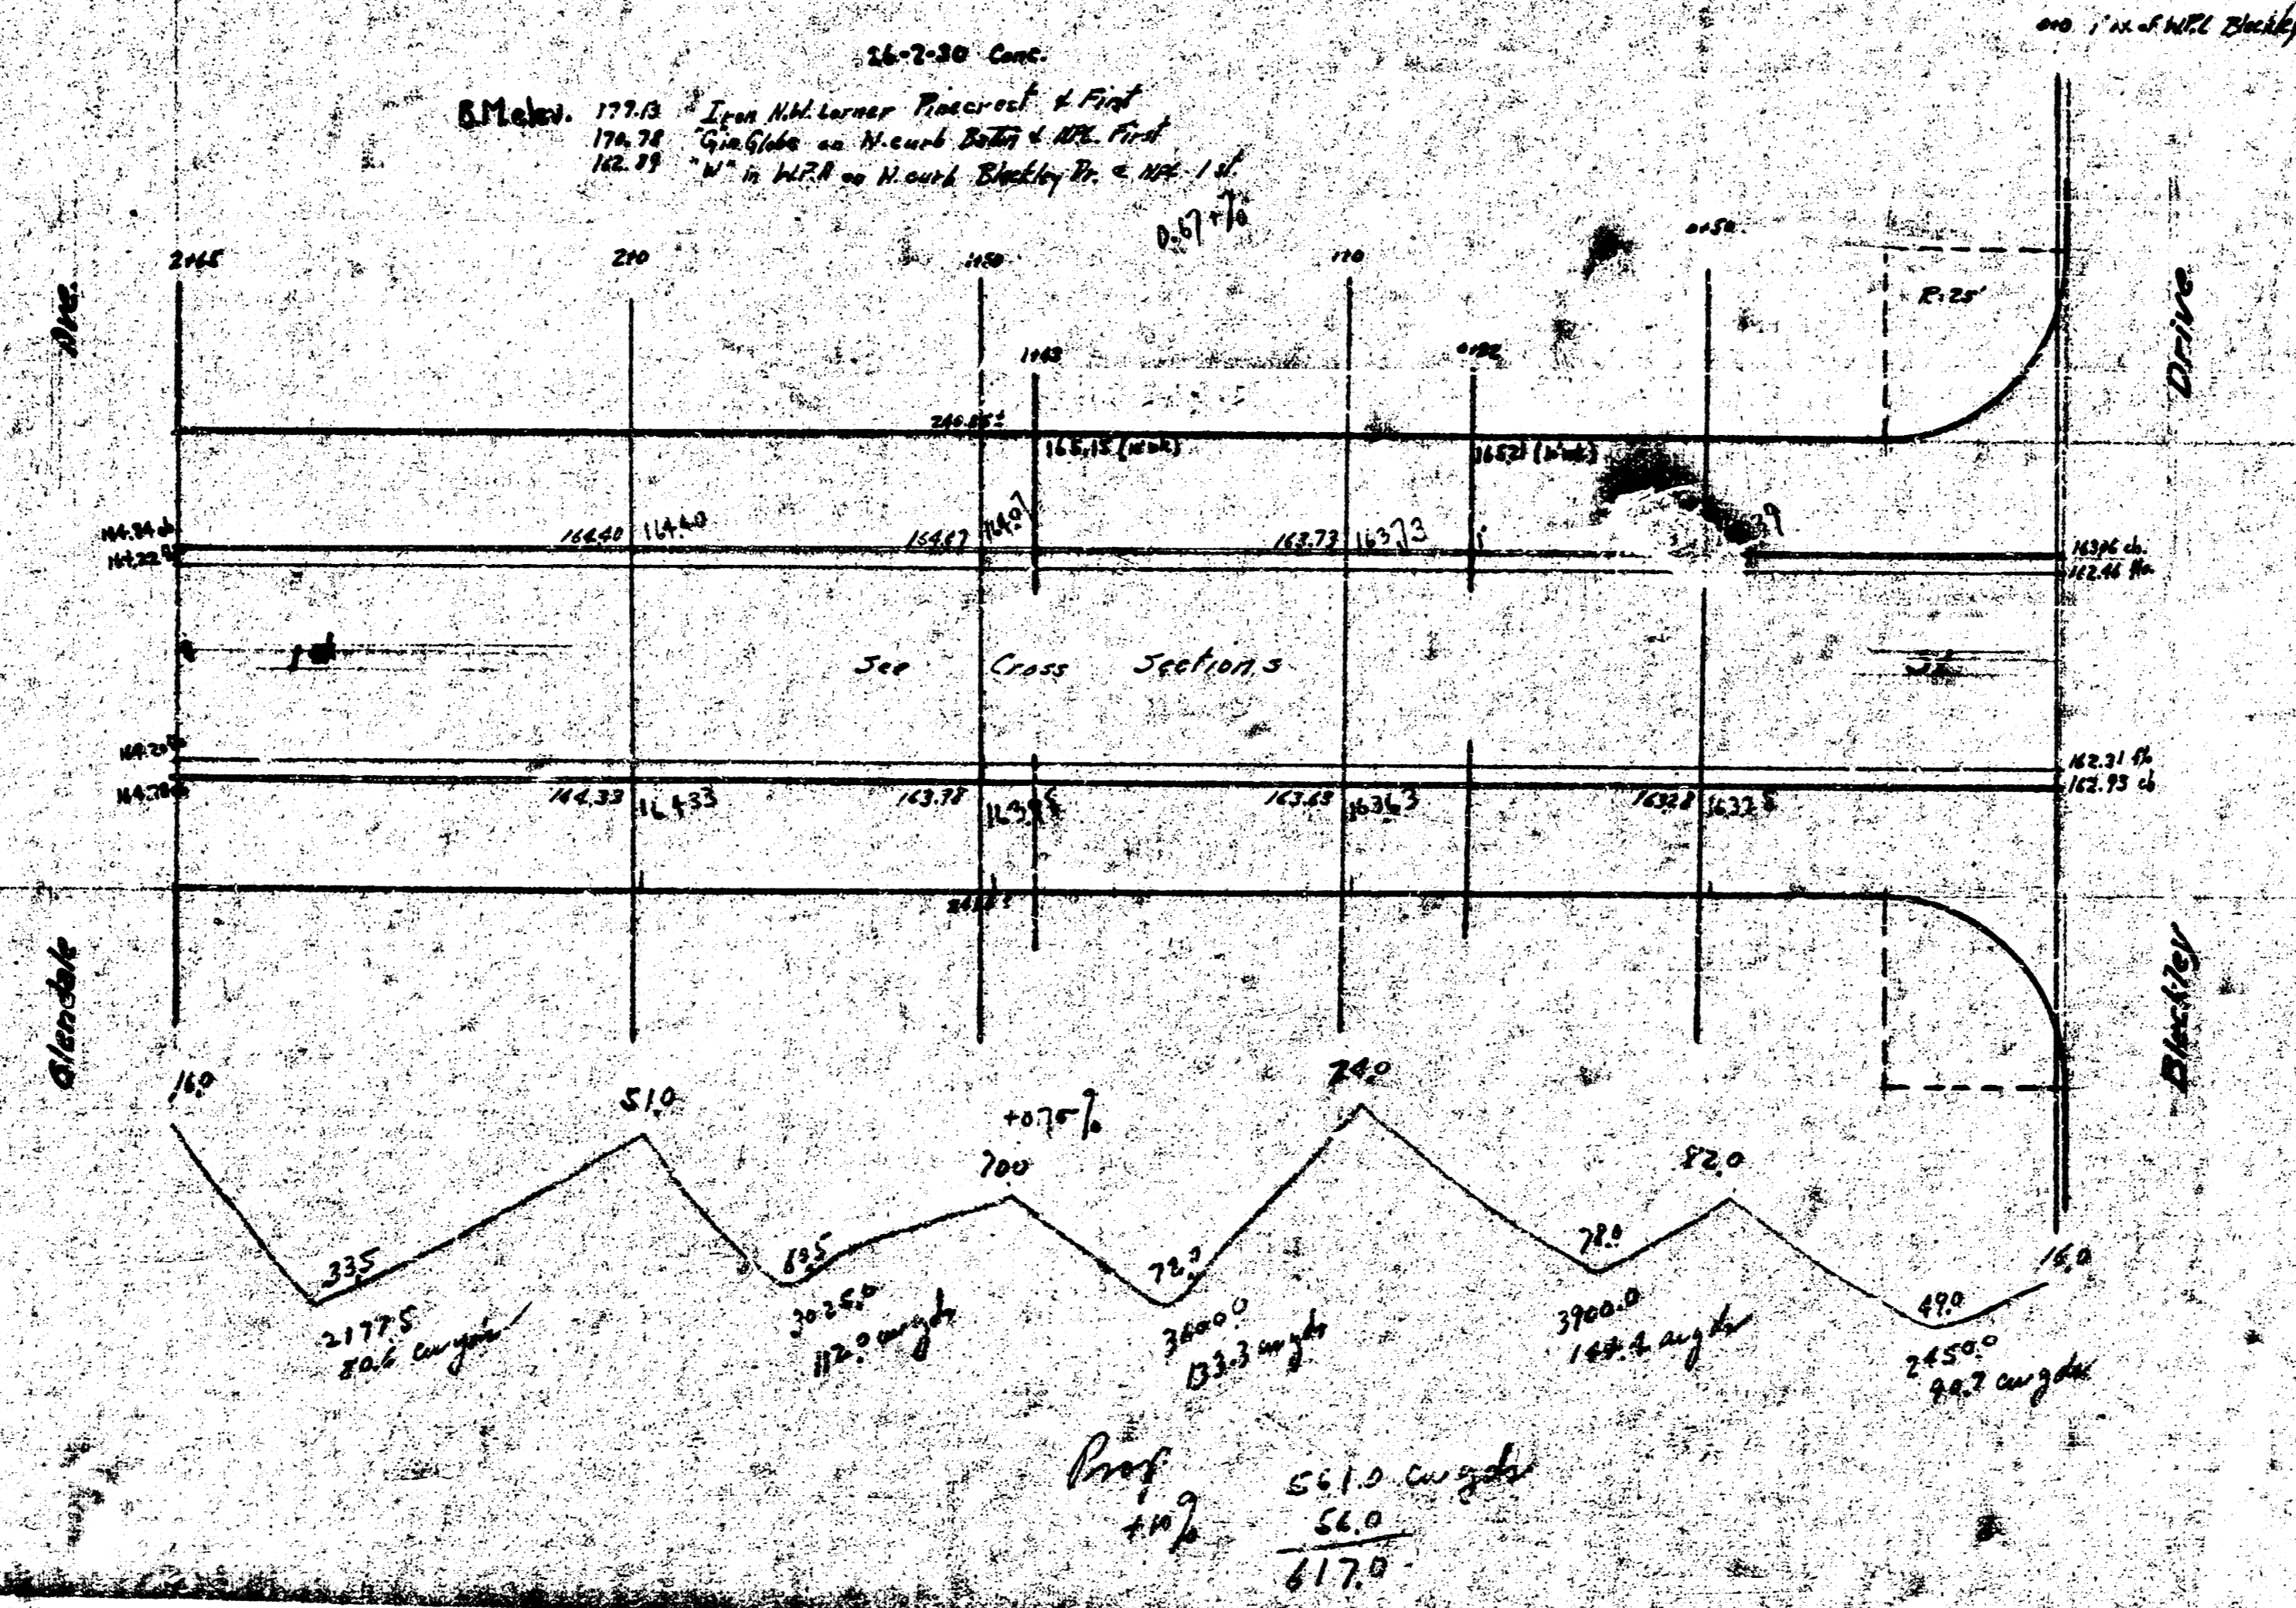

26-7-30 Cont.  
 B. Make 177.0  
 178.24  
 182.78

no. 1 in NW Bladby

Prof  
 661.0 Length  
 44.0  
 617.0