1941

FIRST ST - E.L. RIDGEWOOD - W.L. EDGEMOOR
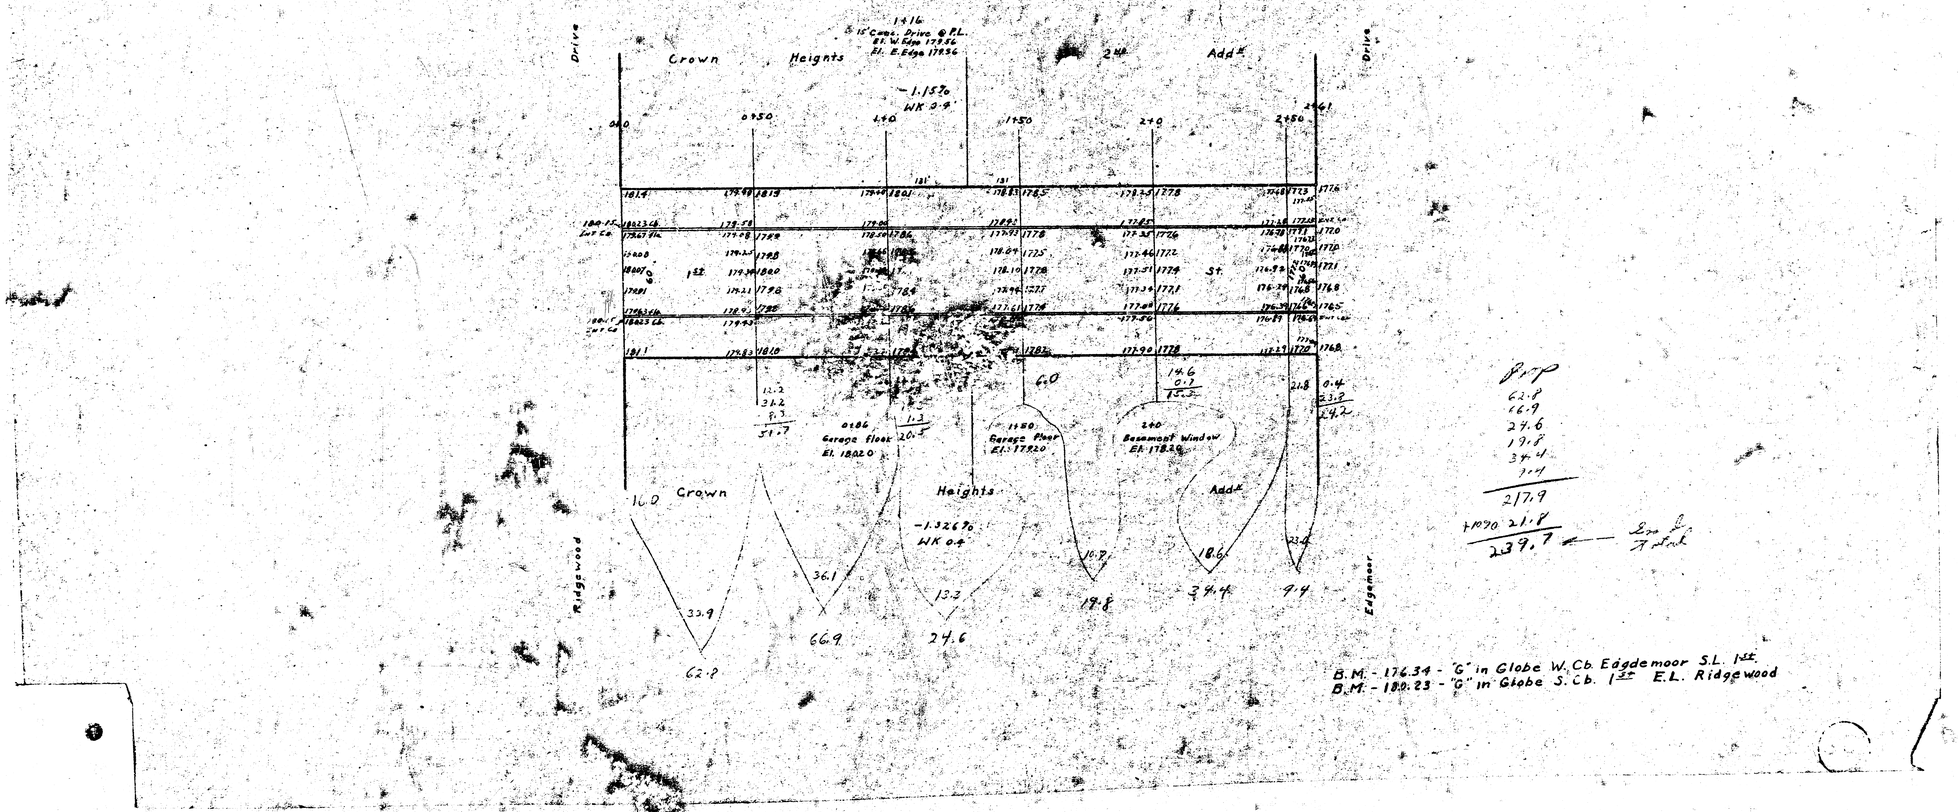
30' CONC - INT. CURB