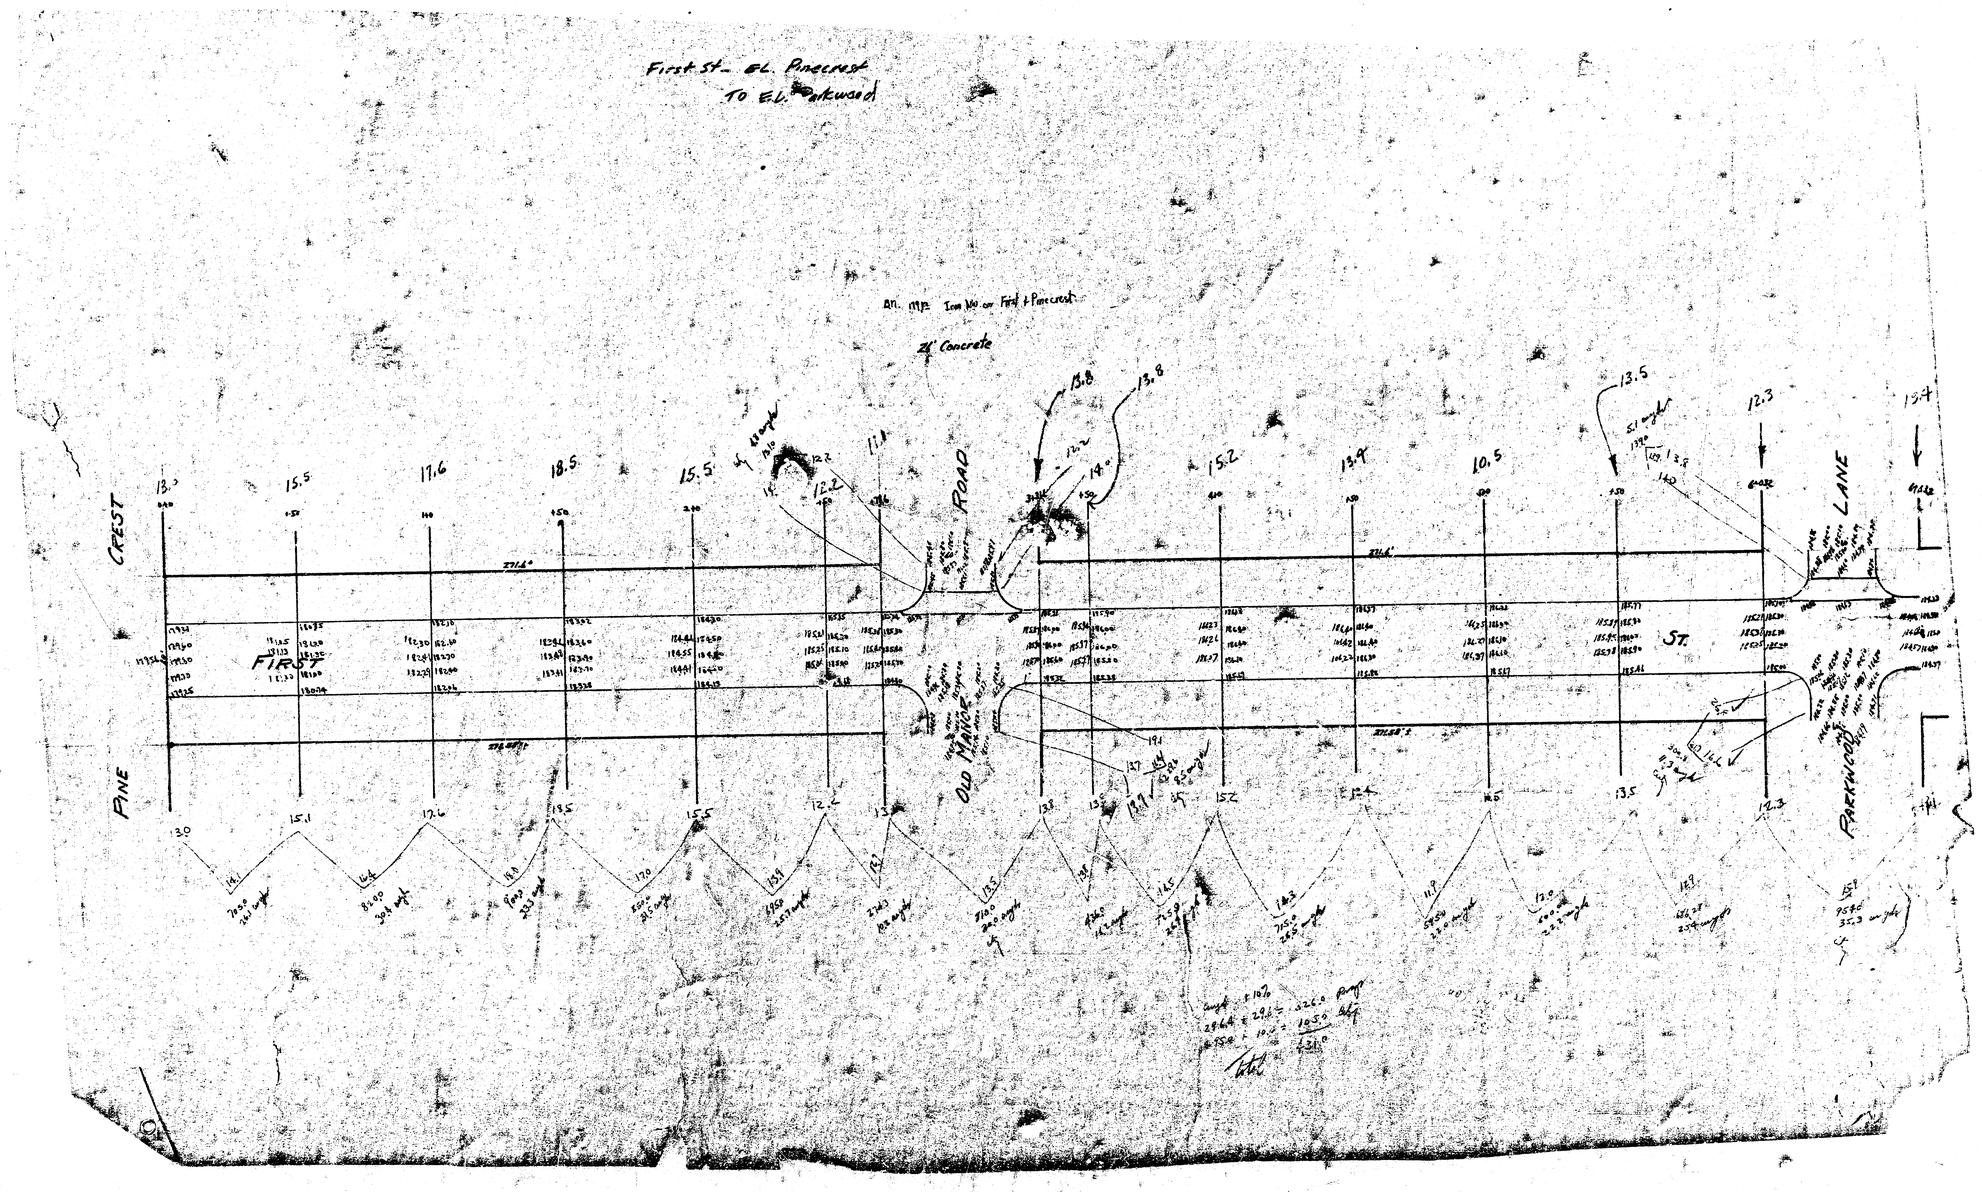
First St. EL. Pinecrest
To E.L. Parkwood
Concrete
PINE CREST
FIRST
ROAD
OLD MANOR
ST.
PARKWOOD
LANE