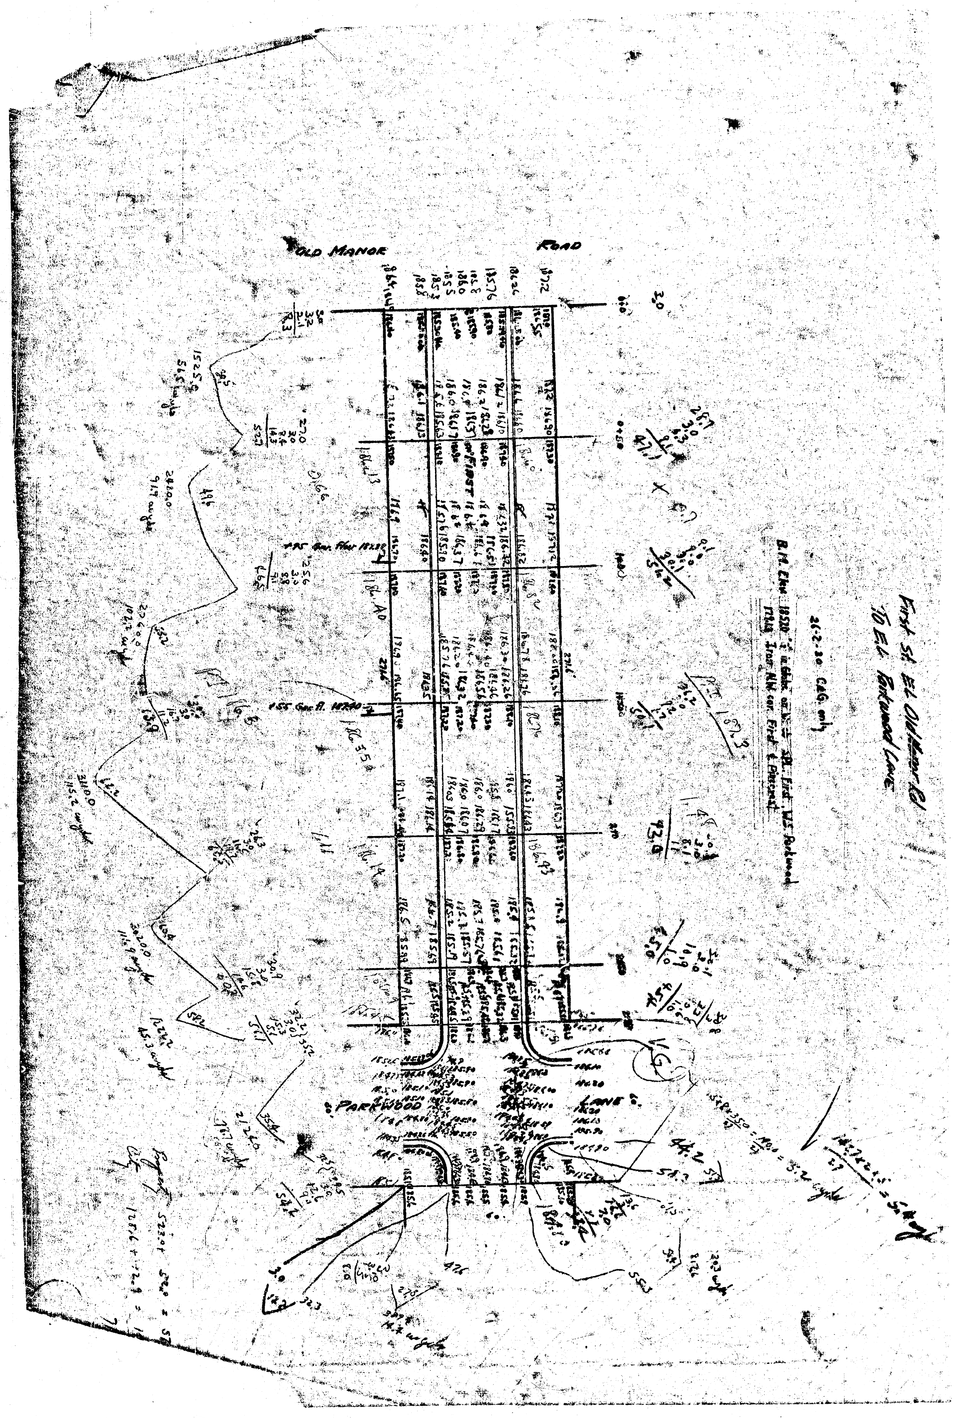
OLD MANOR
ROAD
PARKWOOD
LANE