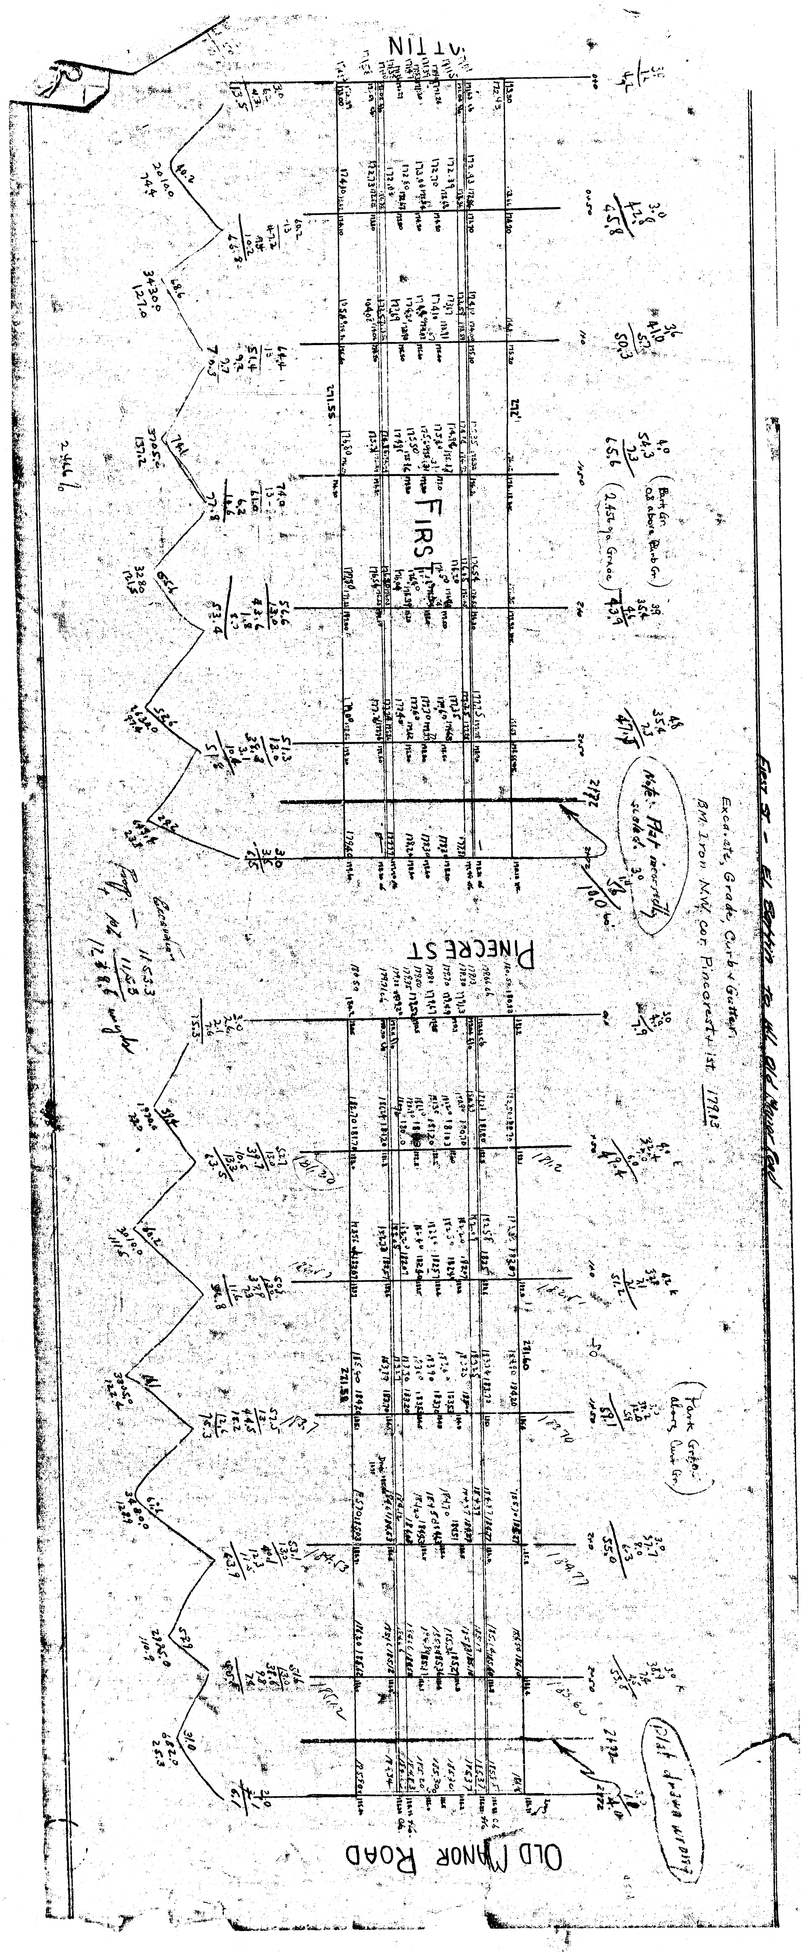
FIRST ST - EL BETTER TO ALL OLD MANOR ROAD
Excavate, Grade, Curb & Gutter
BM Iron Nail Cor Pinecrest 1st 17913
PINECREST ST
FIRS
OLD MANOR ROAD