
BM 11666 SE Cor. Conc. Step S. Side No. 201 N. Richmond

Sta on E.

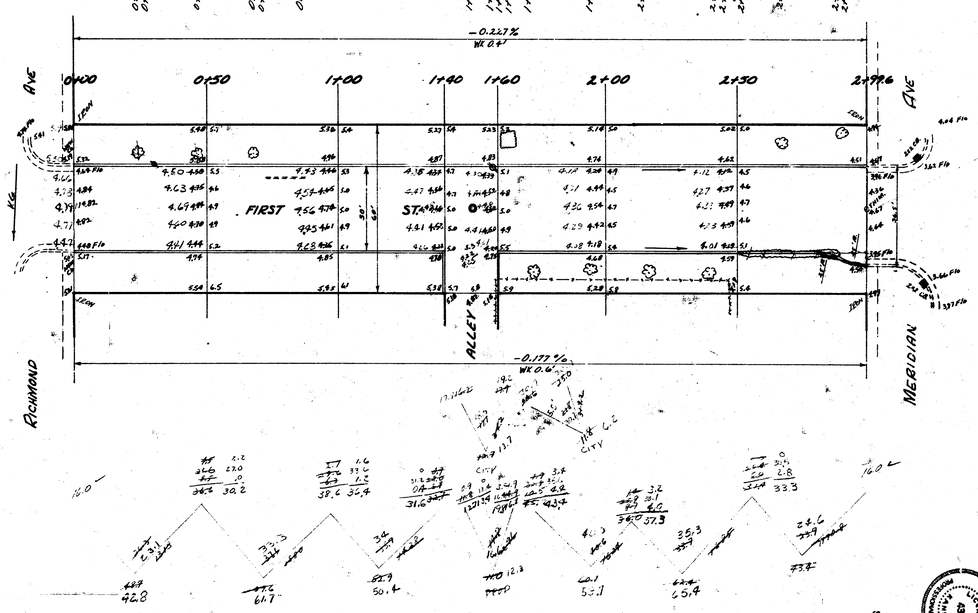

Surv. Asbuilt Bk. W-8
Plan 4/D
Elev.
Checked

1ST ST.
EL. RICHMOND TO W.L. MERIDIAN
30' CONC. & CB

CITY OF WICHITA, KANSAS
B.E. SMITH CITY ENGINEER
FEB. 8, 1953 PROJ. No. CR-260

1"=20'