# E. SECOND PAVING PLAN

East Line Pinecrest to East Line Old Manor Road

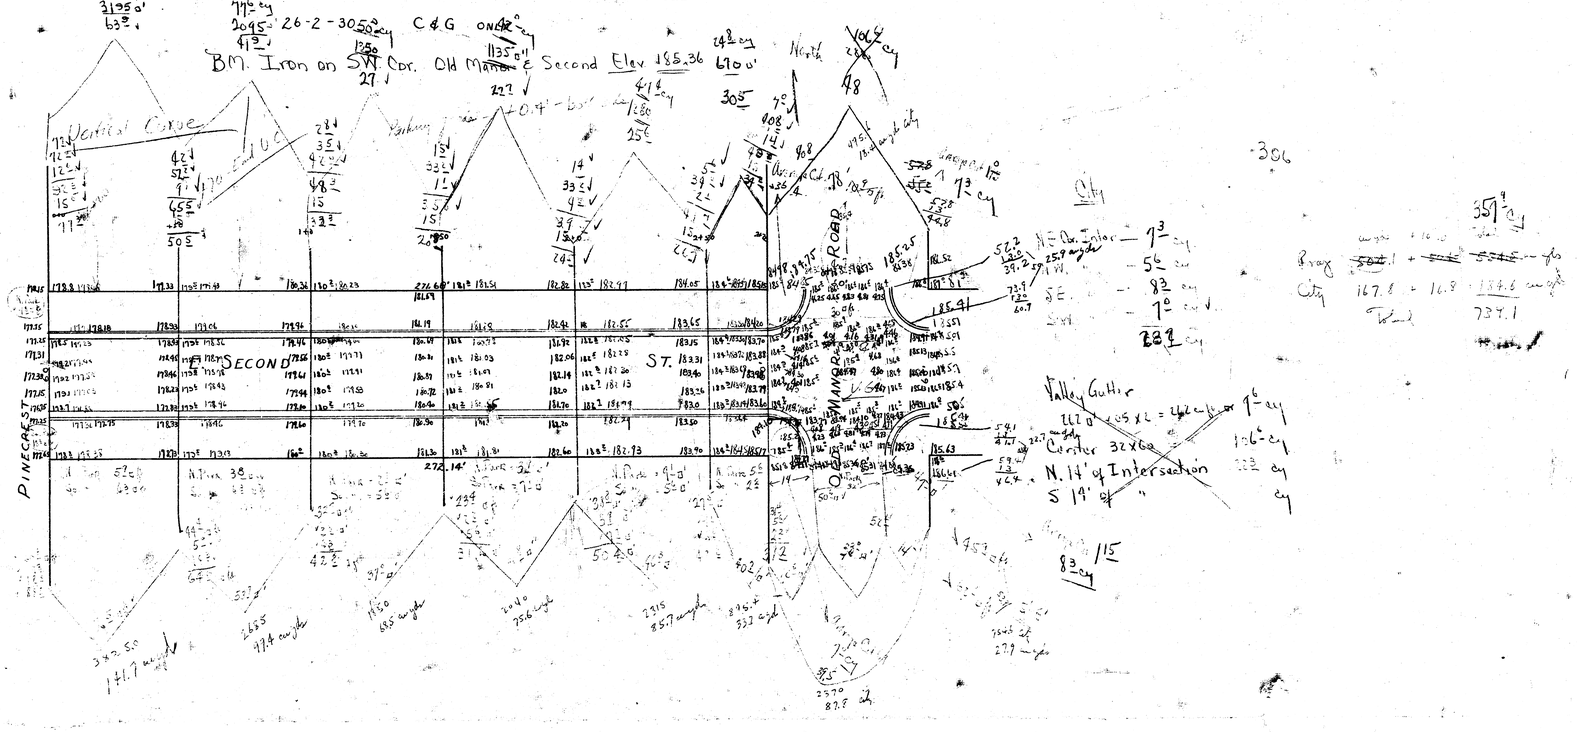

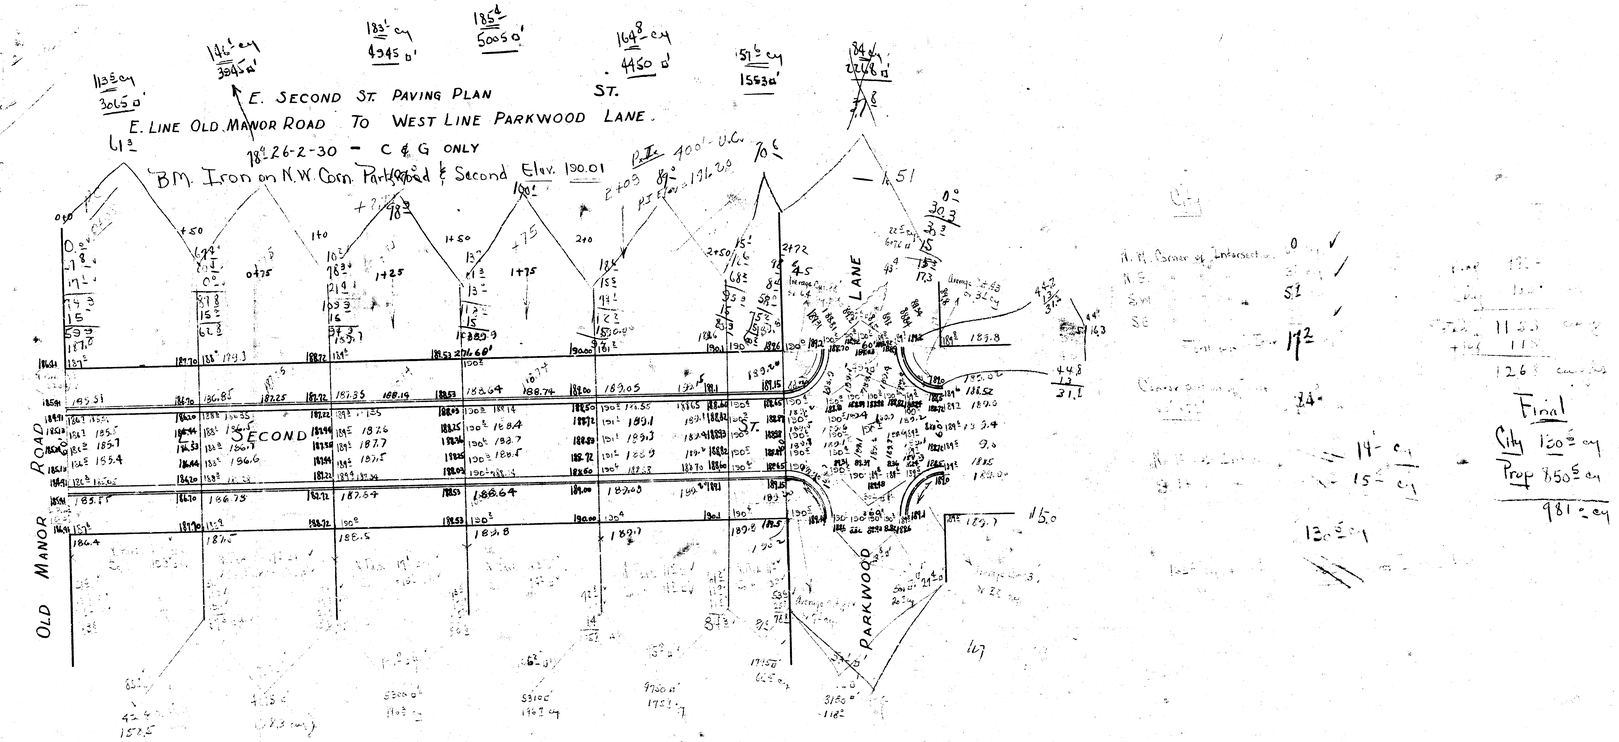


Per Plan 1939
2nd St
E. Forrest
to
E. Parkwood