
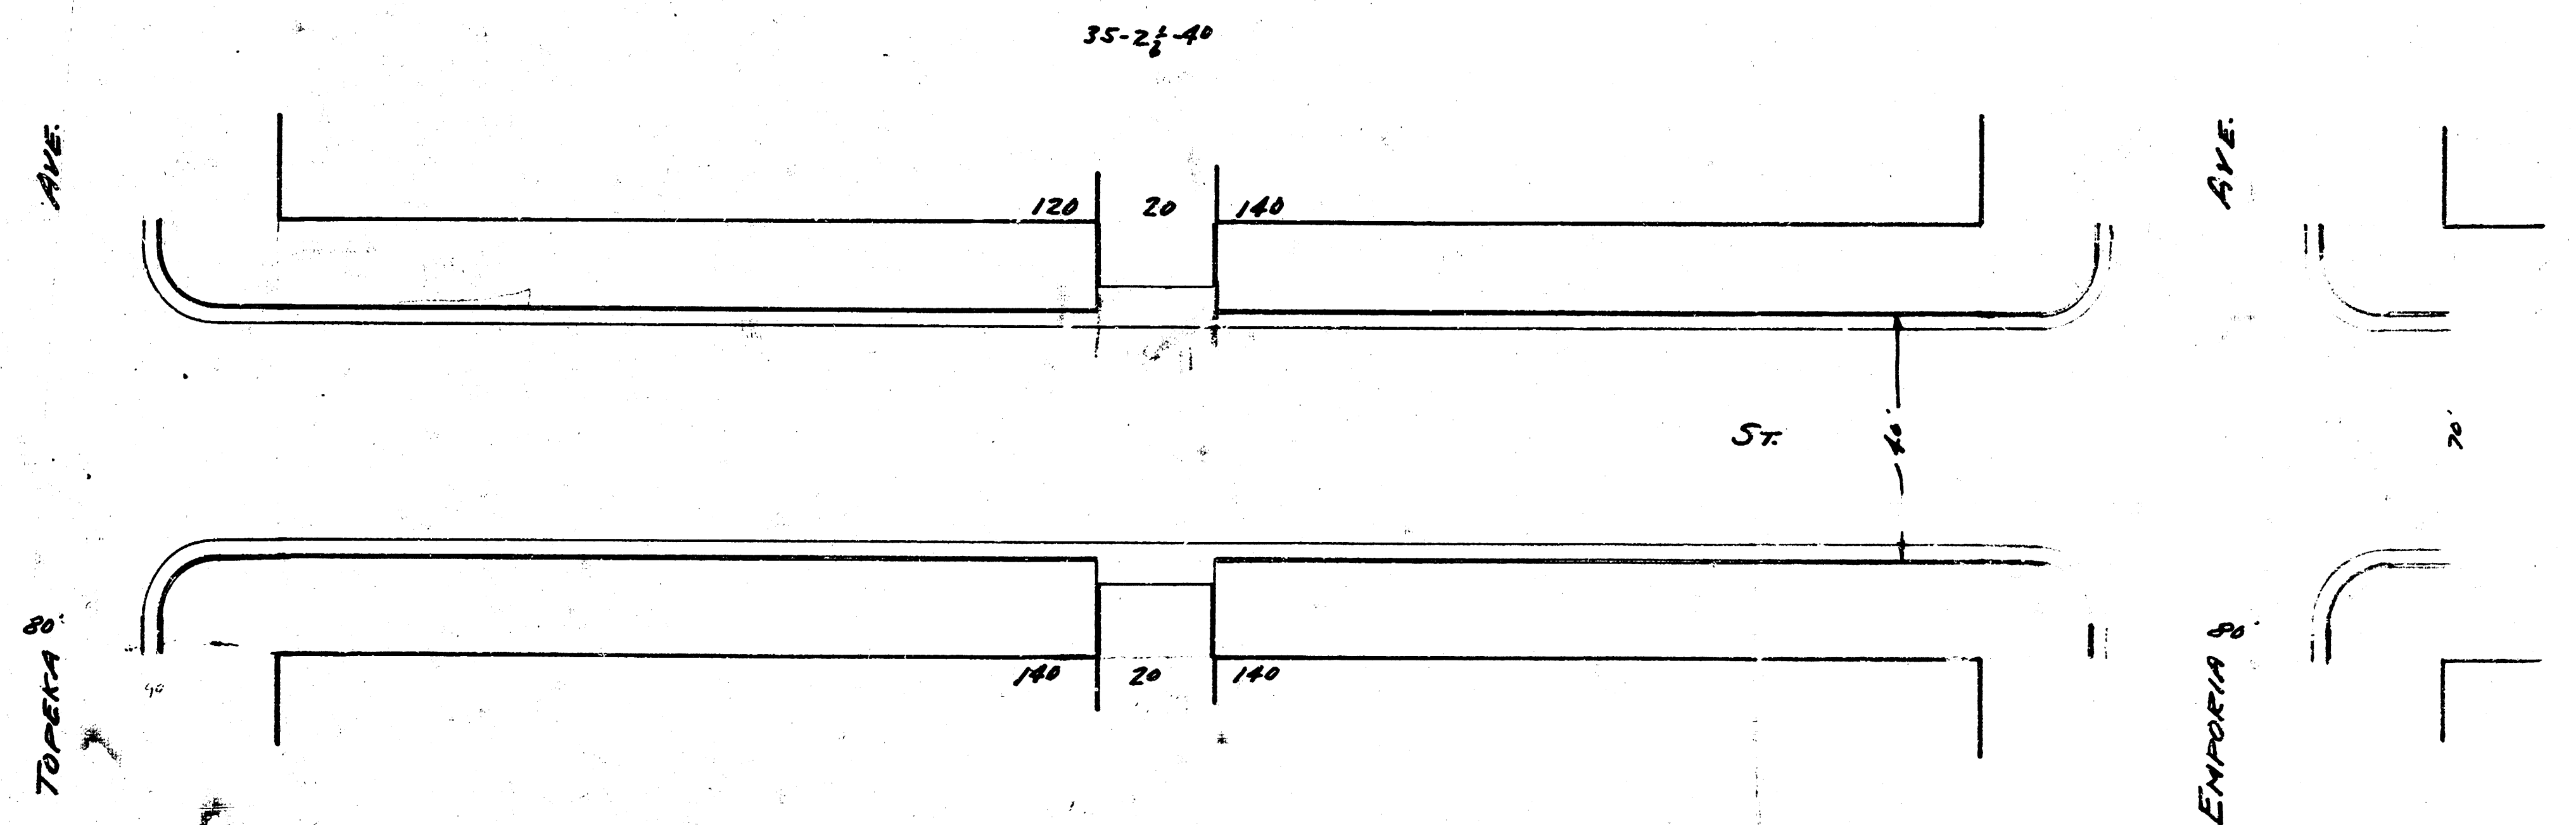
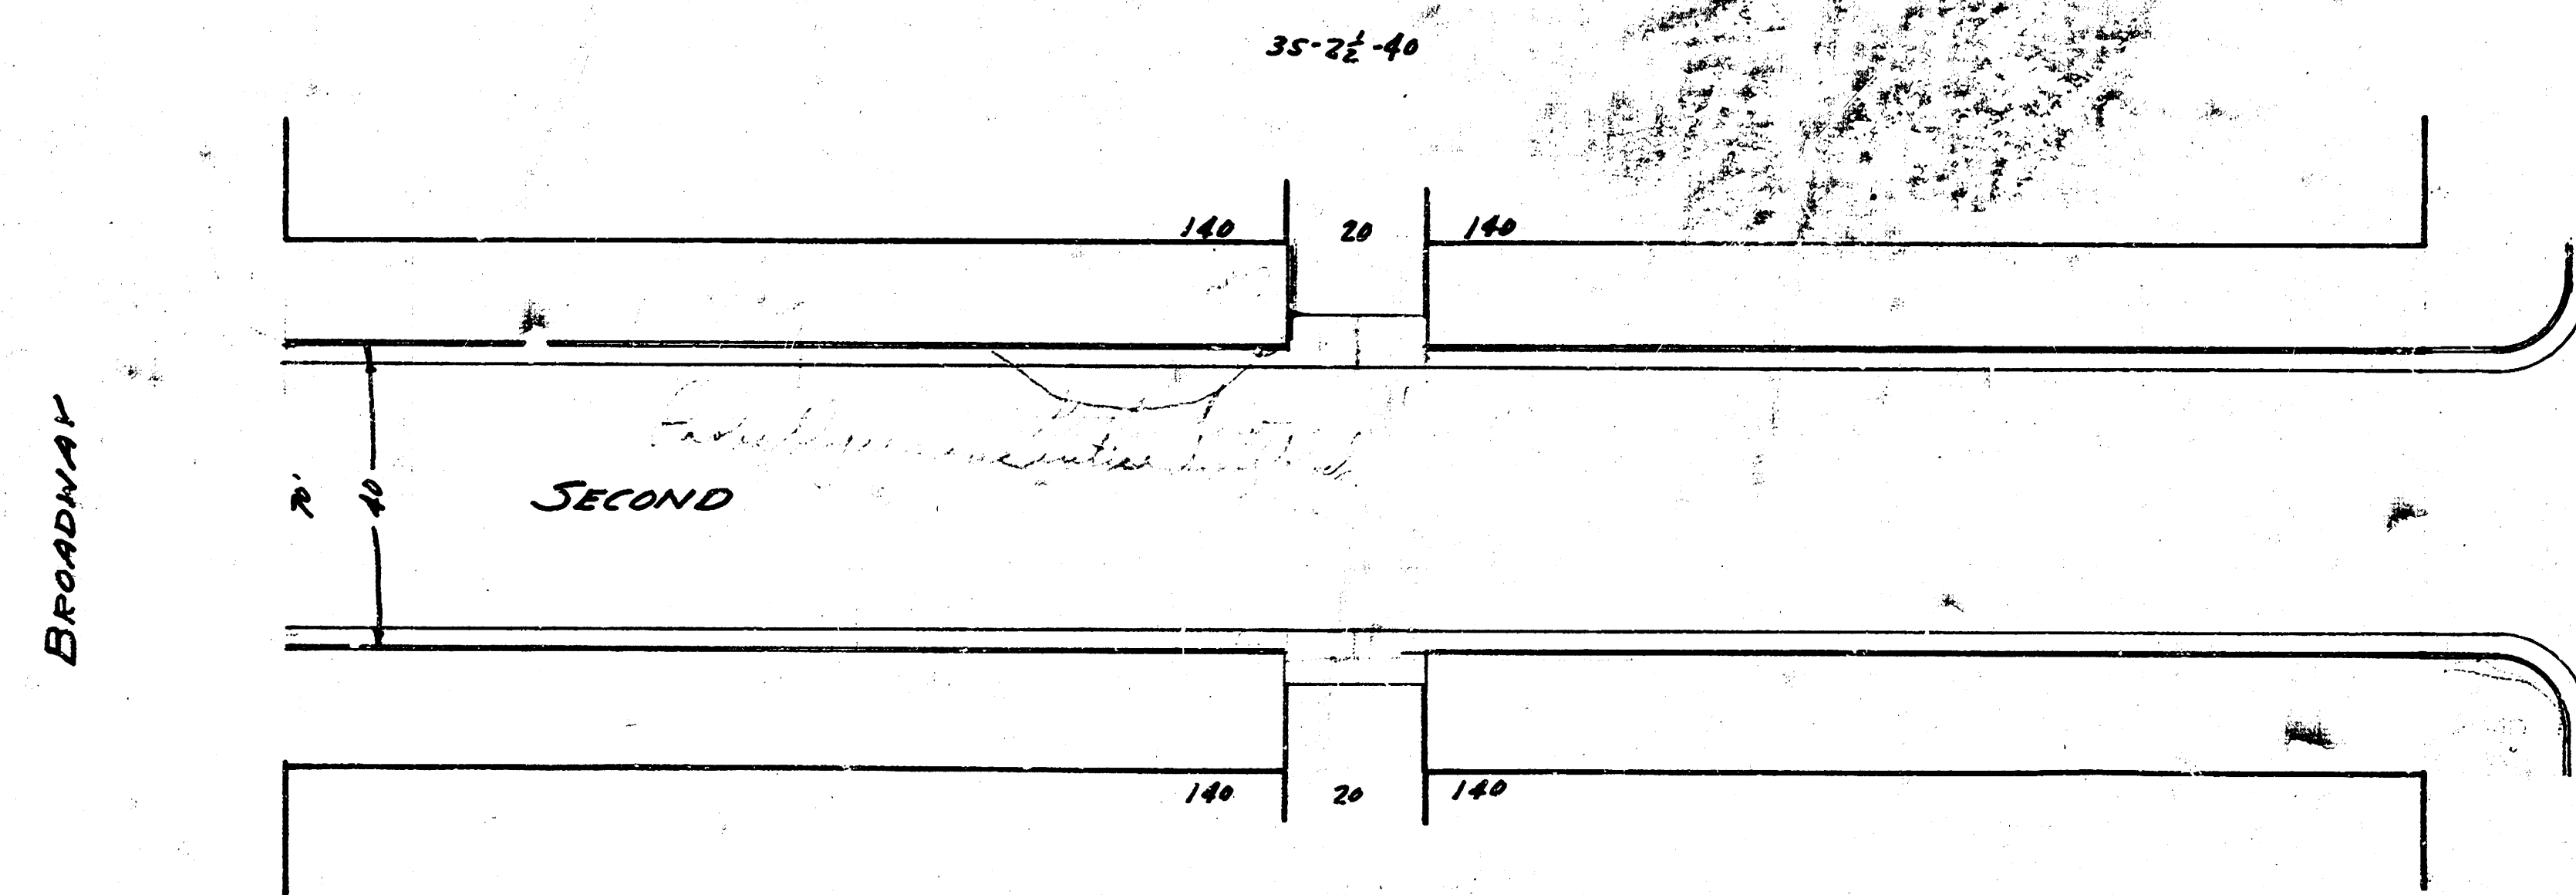
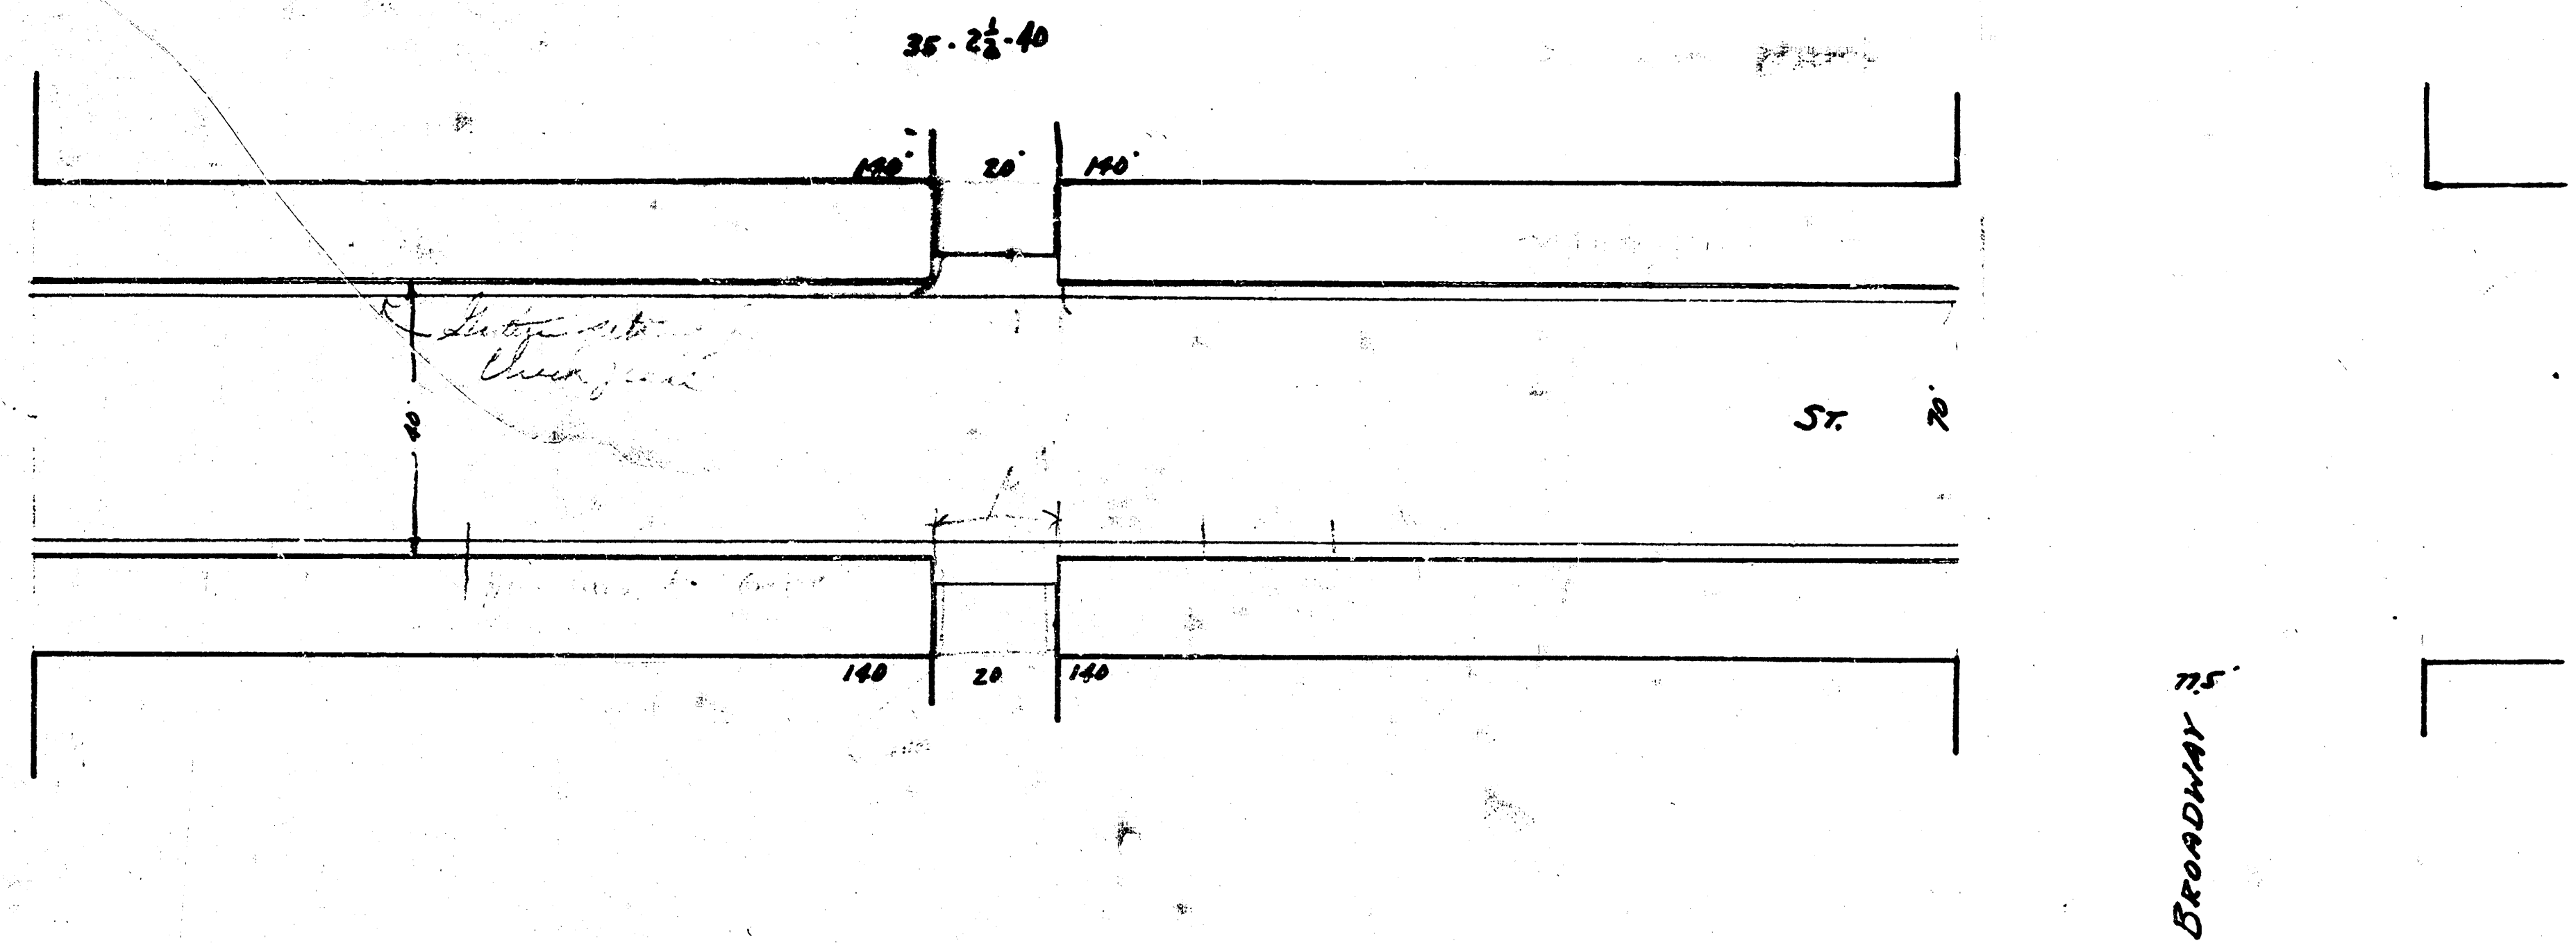


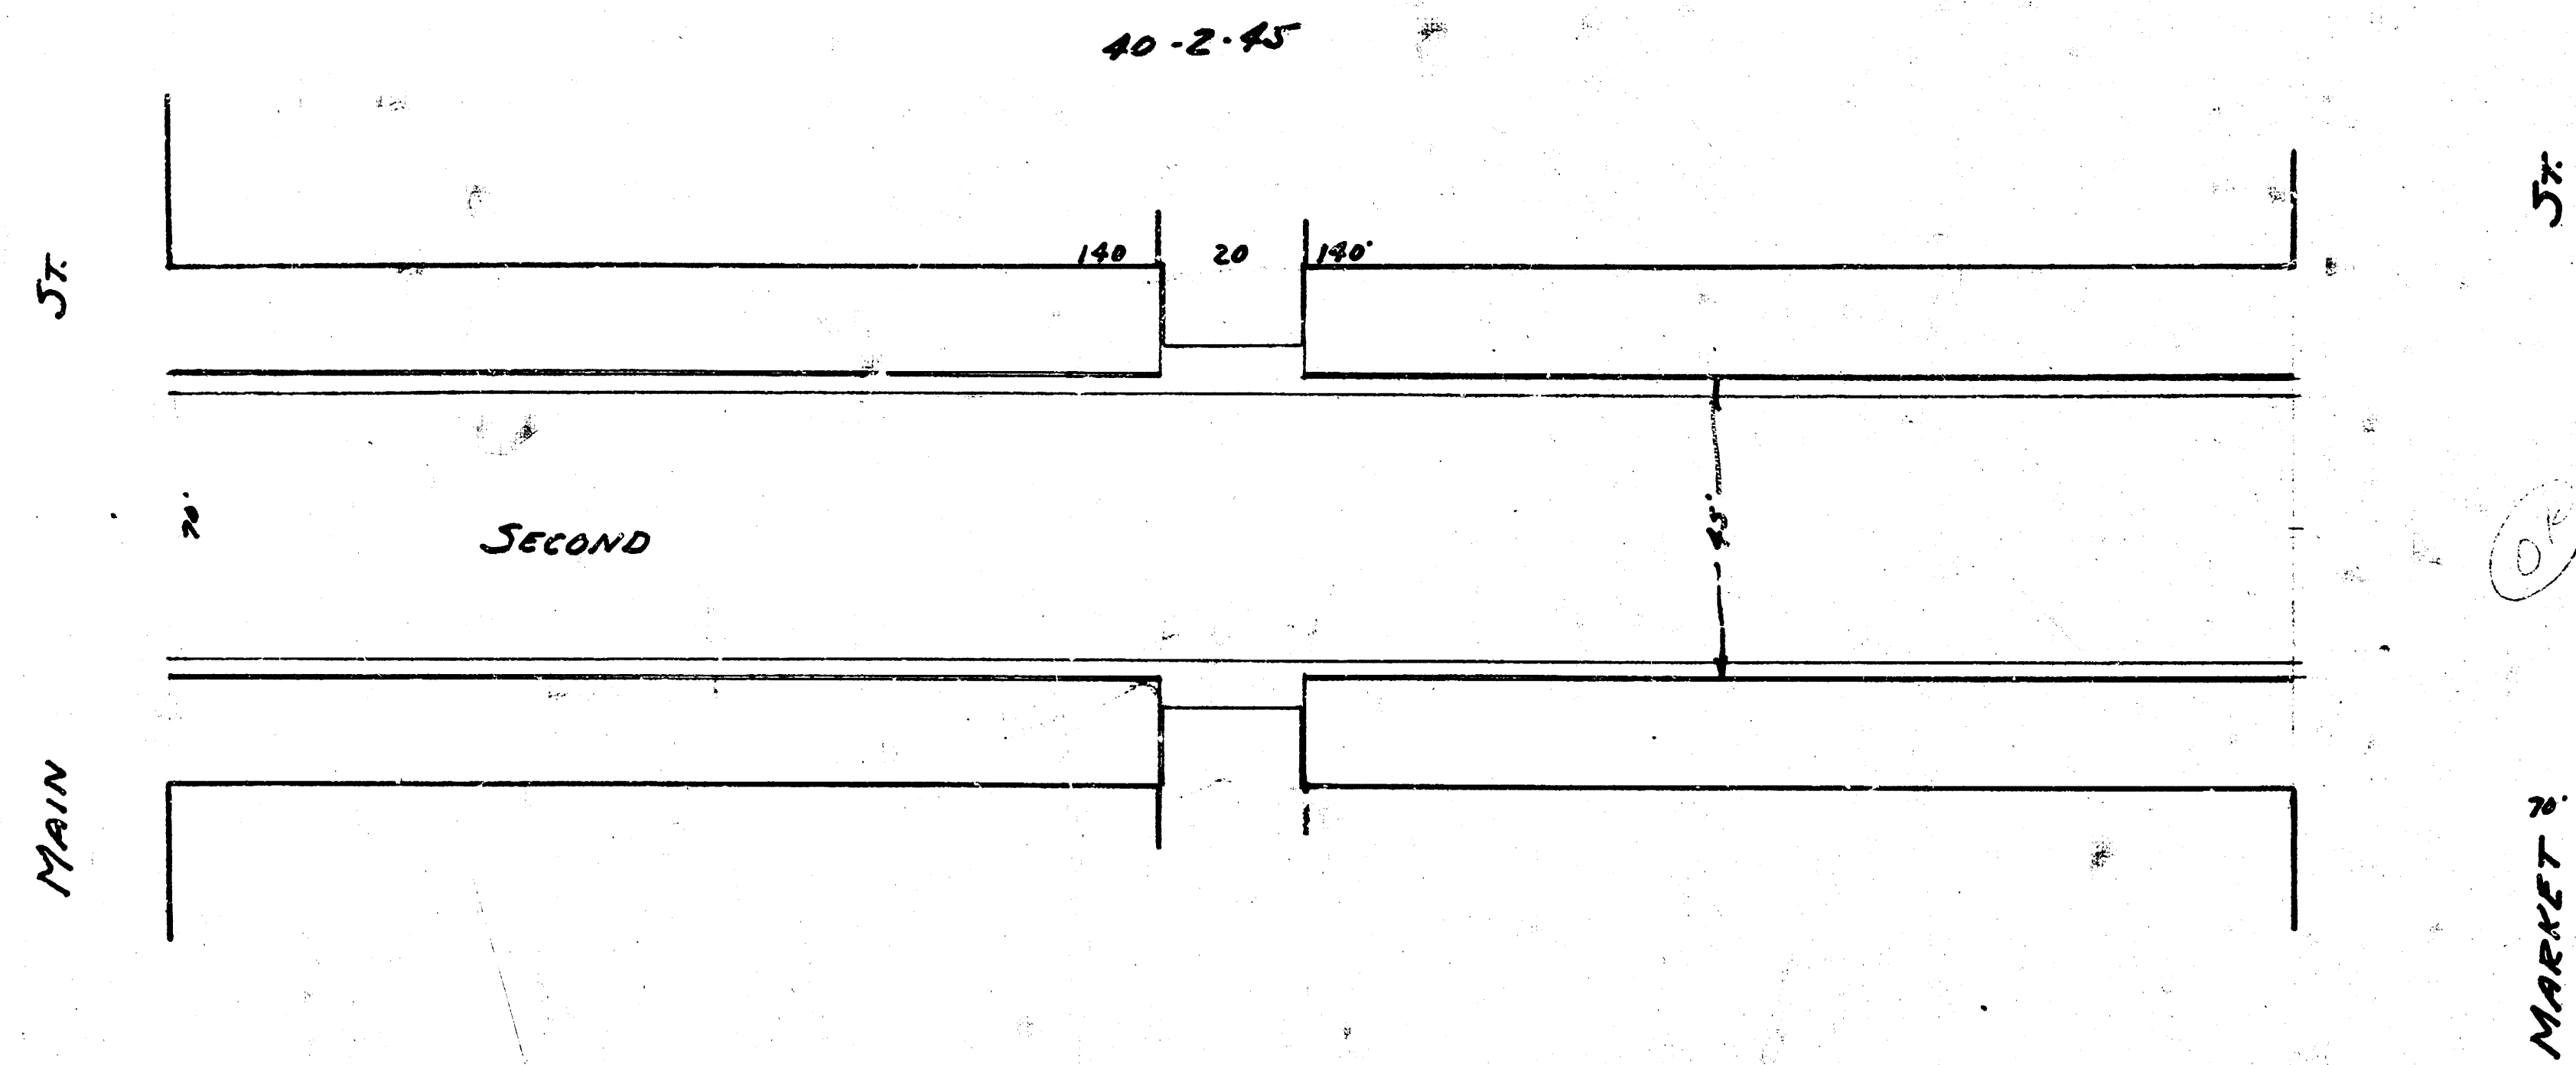

See Plan
128
Second St
El. 1100
St. Emporia