


2nd E.L. Old Manor W.L. Parkwood
26' Concr.

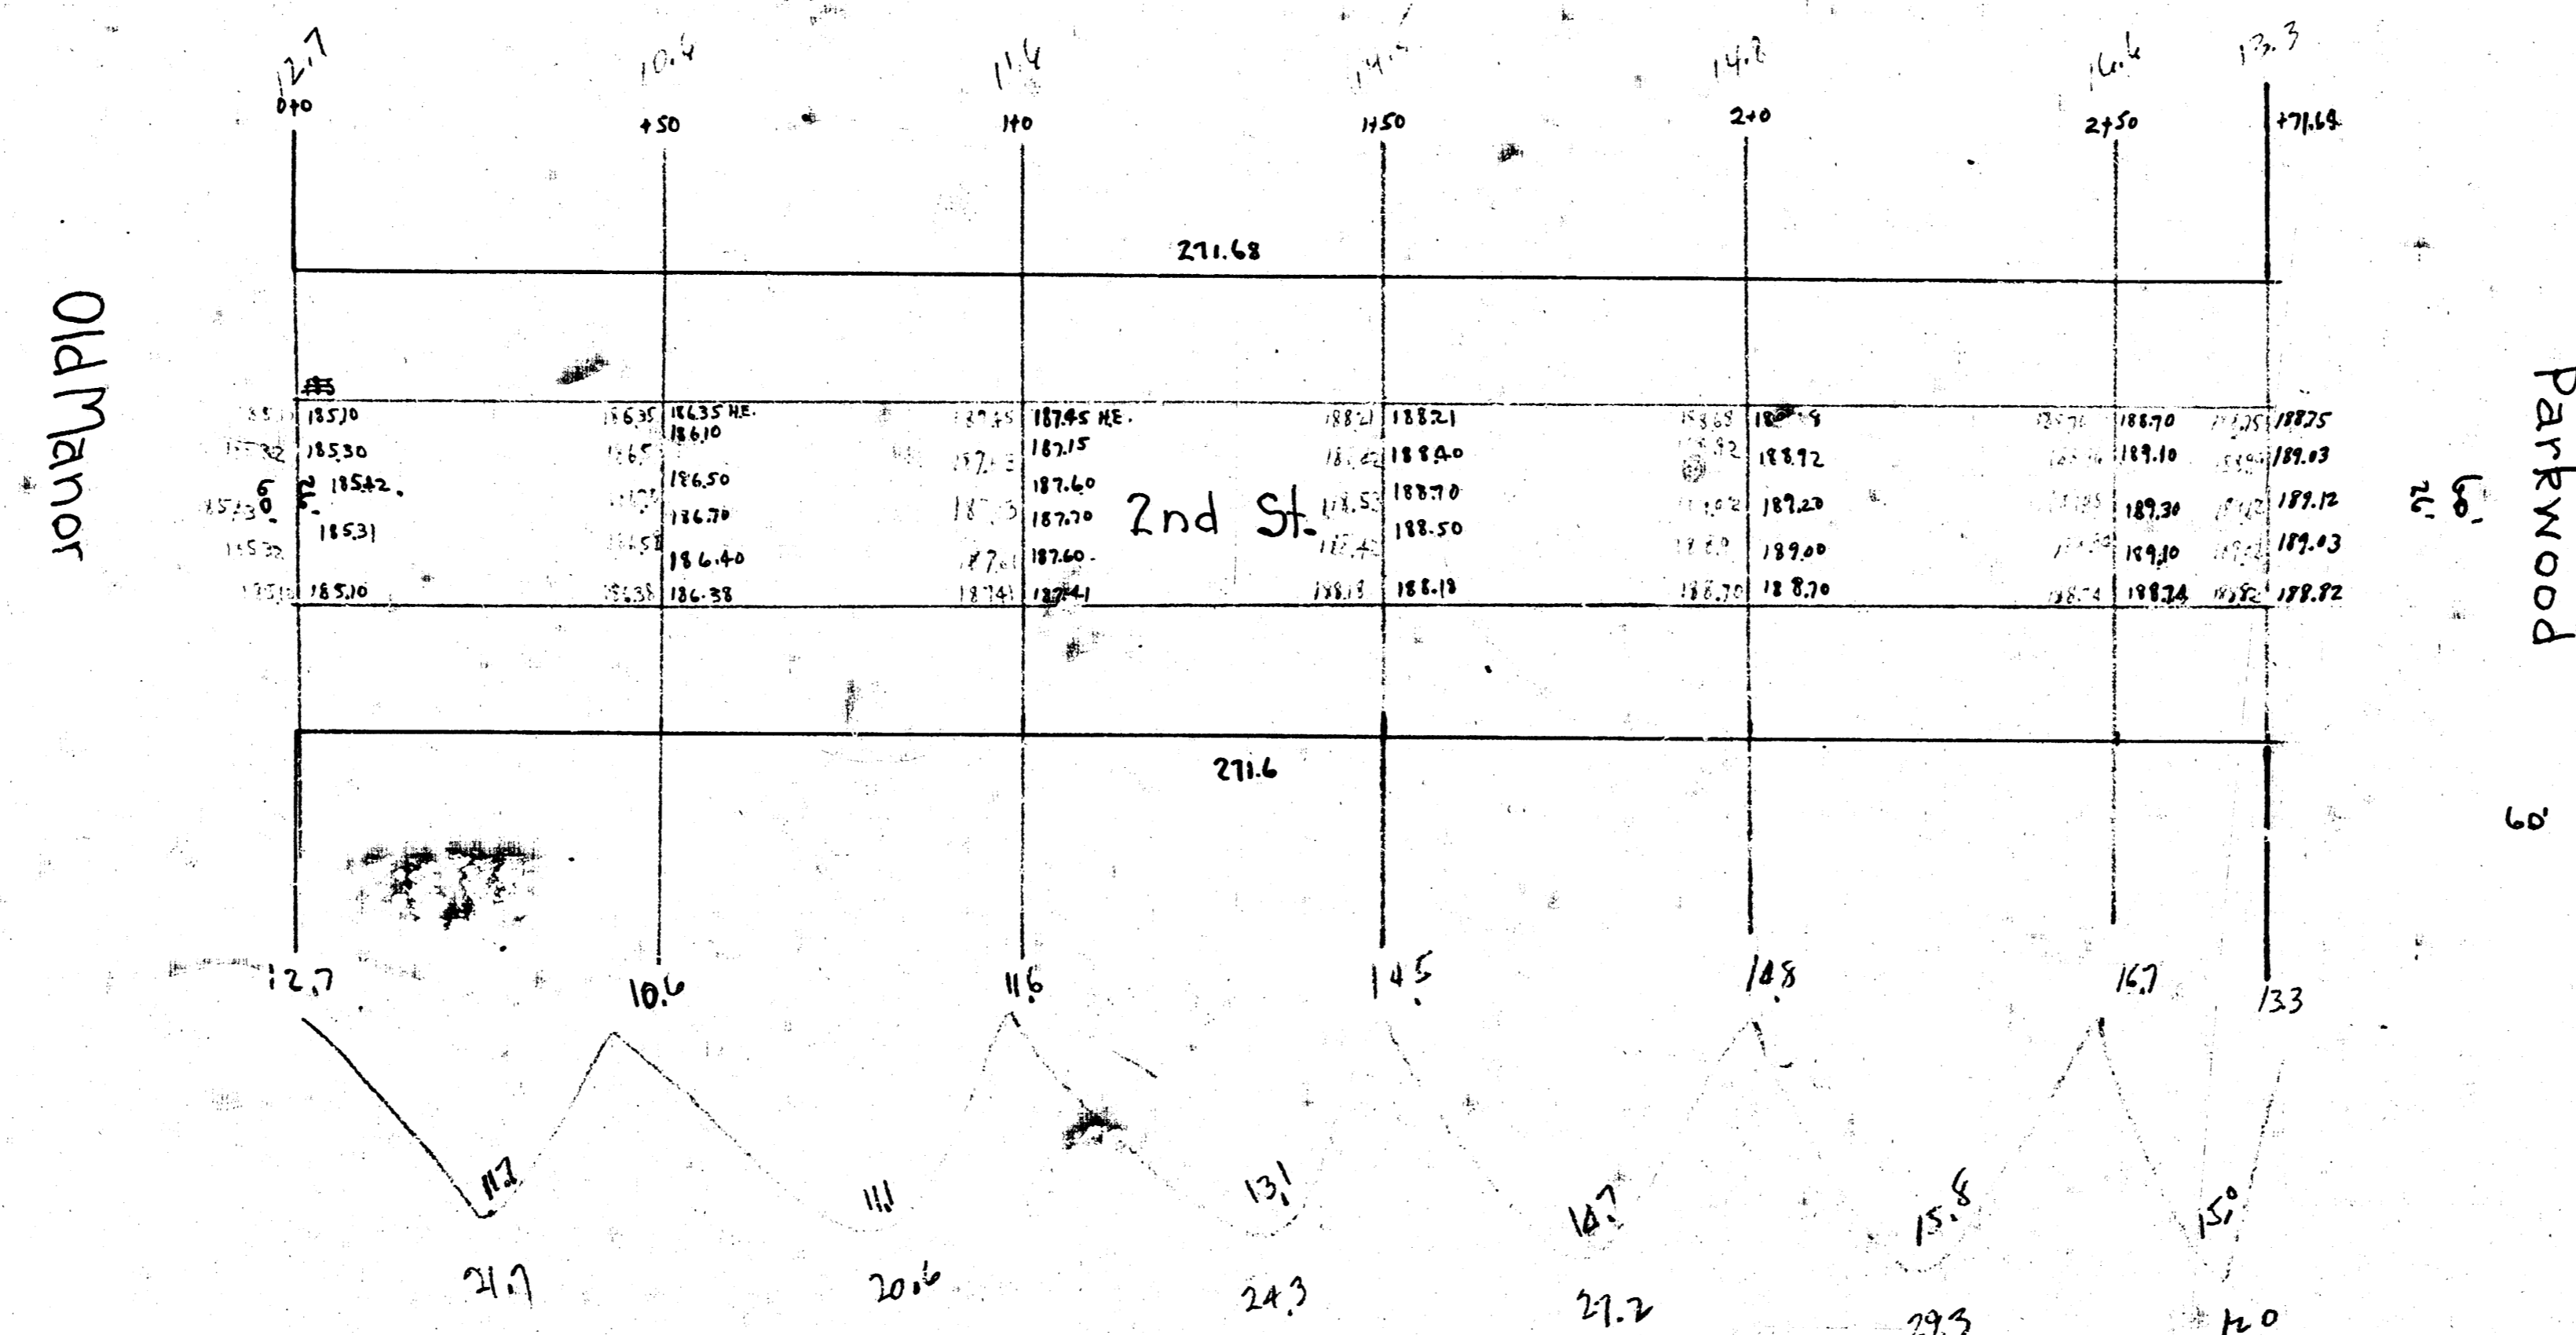

Prop 135.1
+ 18.7 13.5
148.6

Prop Elev. 117.4 "B" in Elev. W. of Parkwood 7th St.

Paving Plan
2nd
E.L. Old Manor
W.L. Parkwood
1940