


Parent  
 B.M. 17913 Iron Riv. cor Pinecrest + 1st  
 176.86 Wood 2nd W. Pinecrest

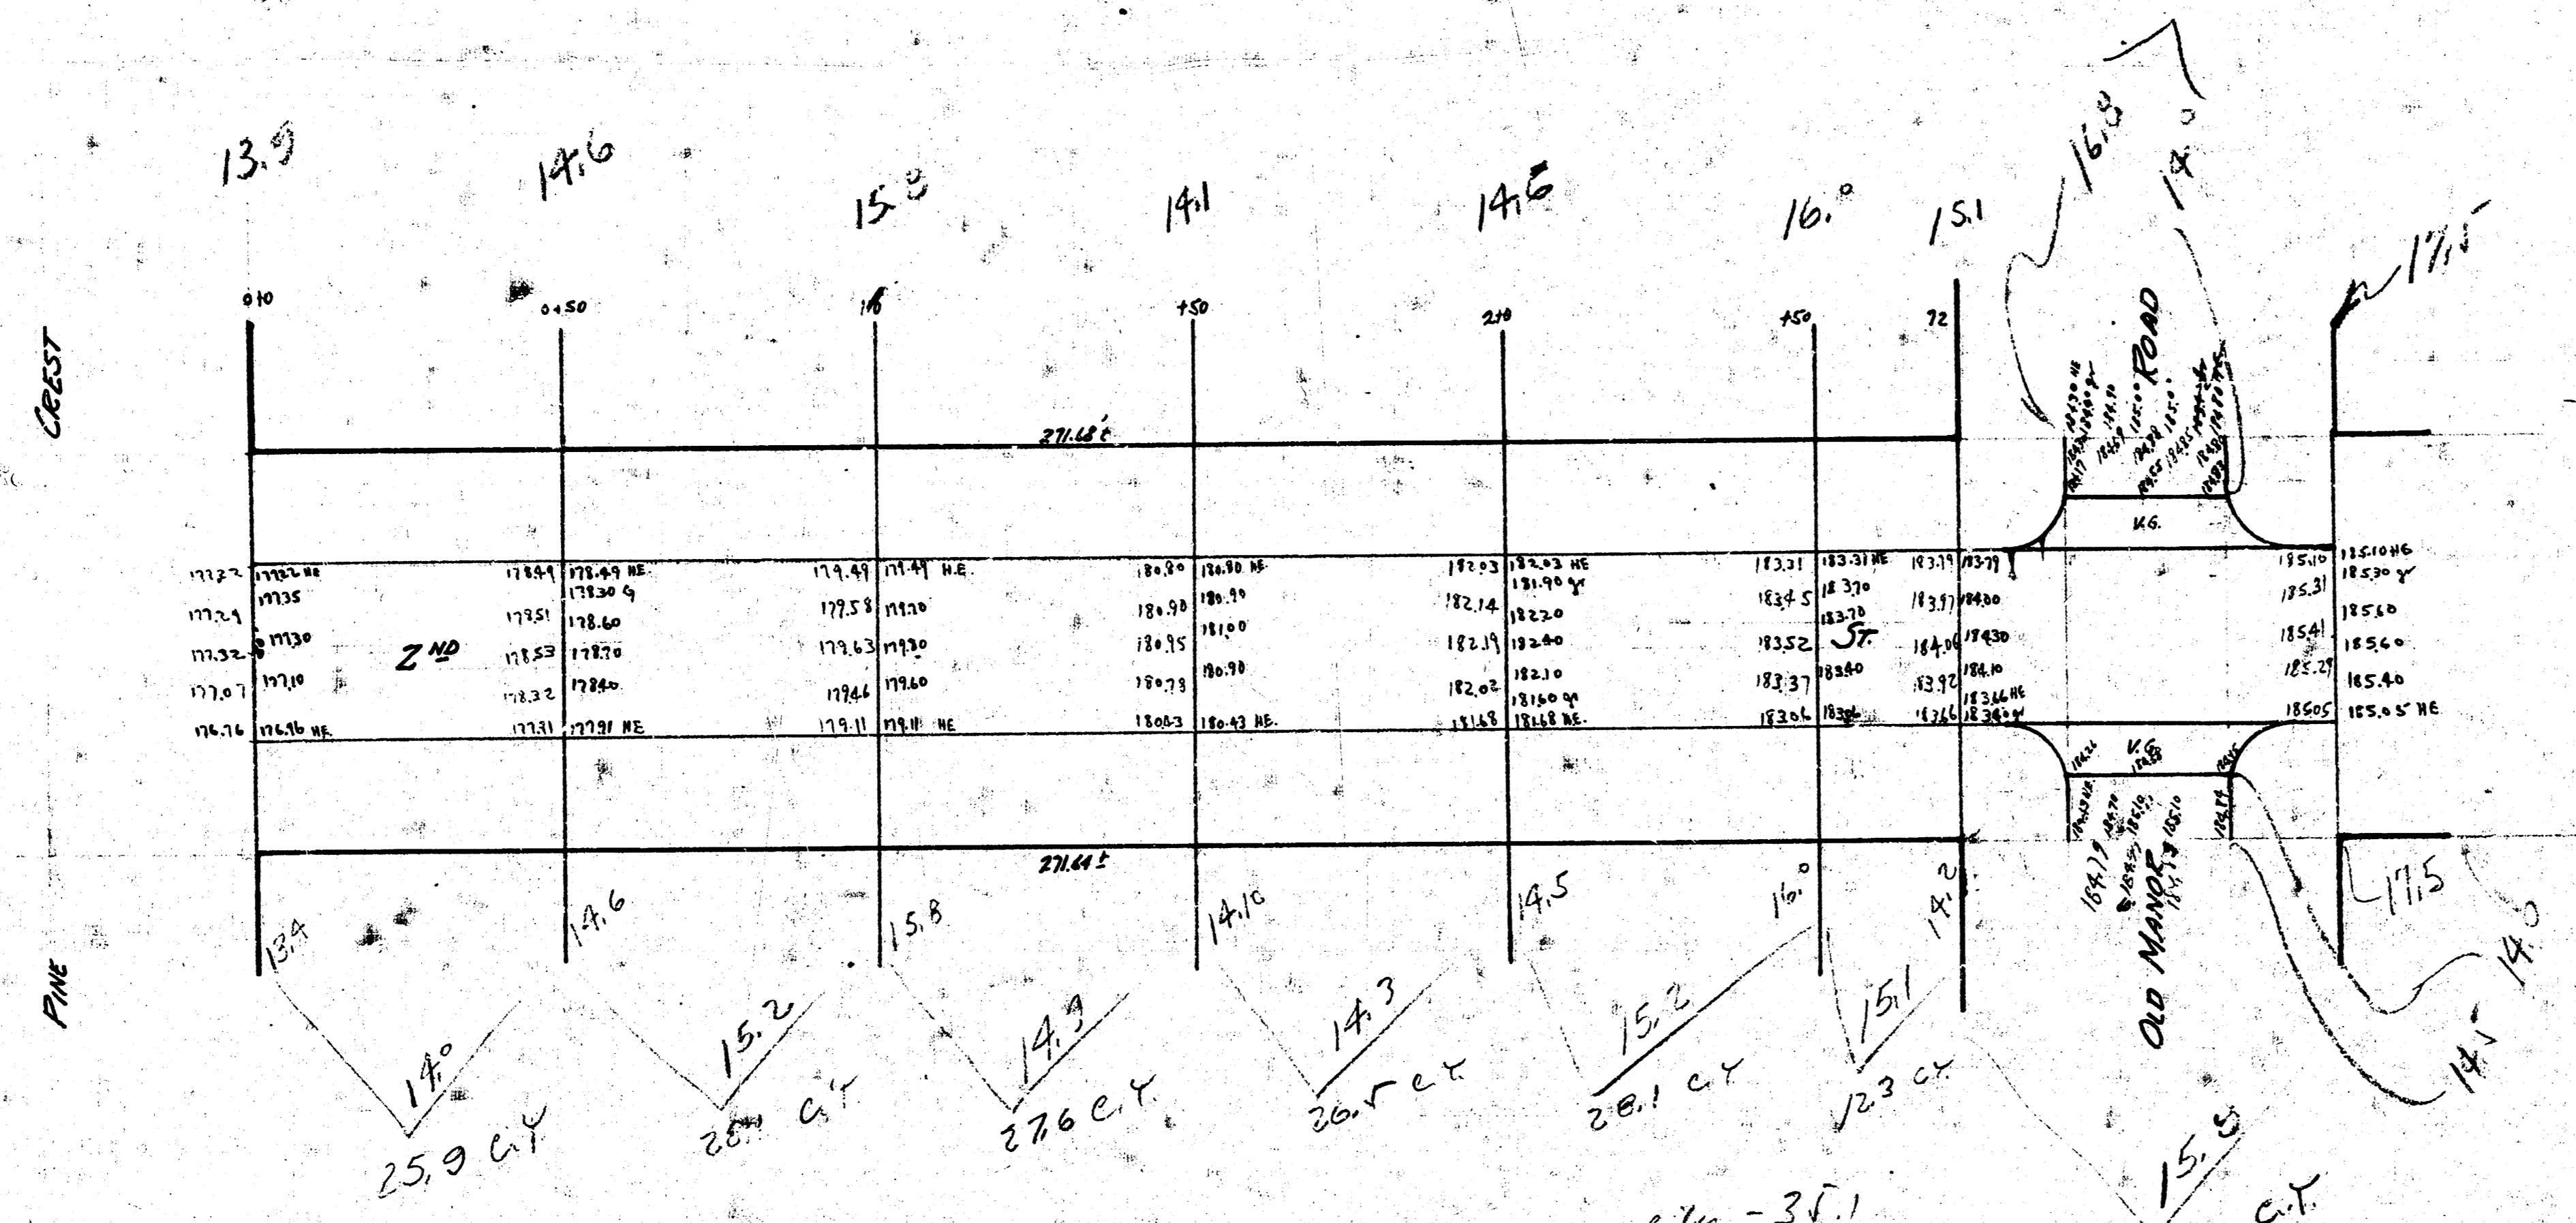

Prof - 178.5 C.Y.  
 +10.0 19.8 - C.Y.  
 163.3

cut - 35.1  
 +1.0 3.5  
 38.6

Plan  
 1917  
 2nd St.  
 El. Pinecrest  
 G. C. Collins