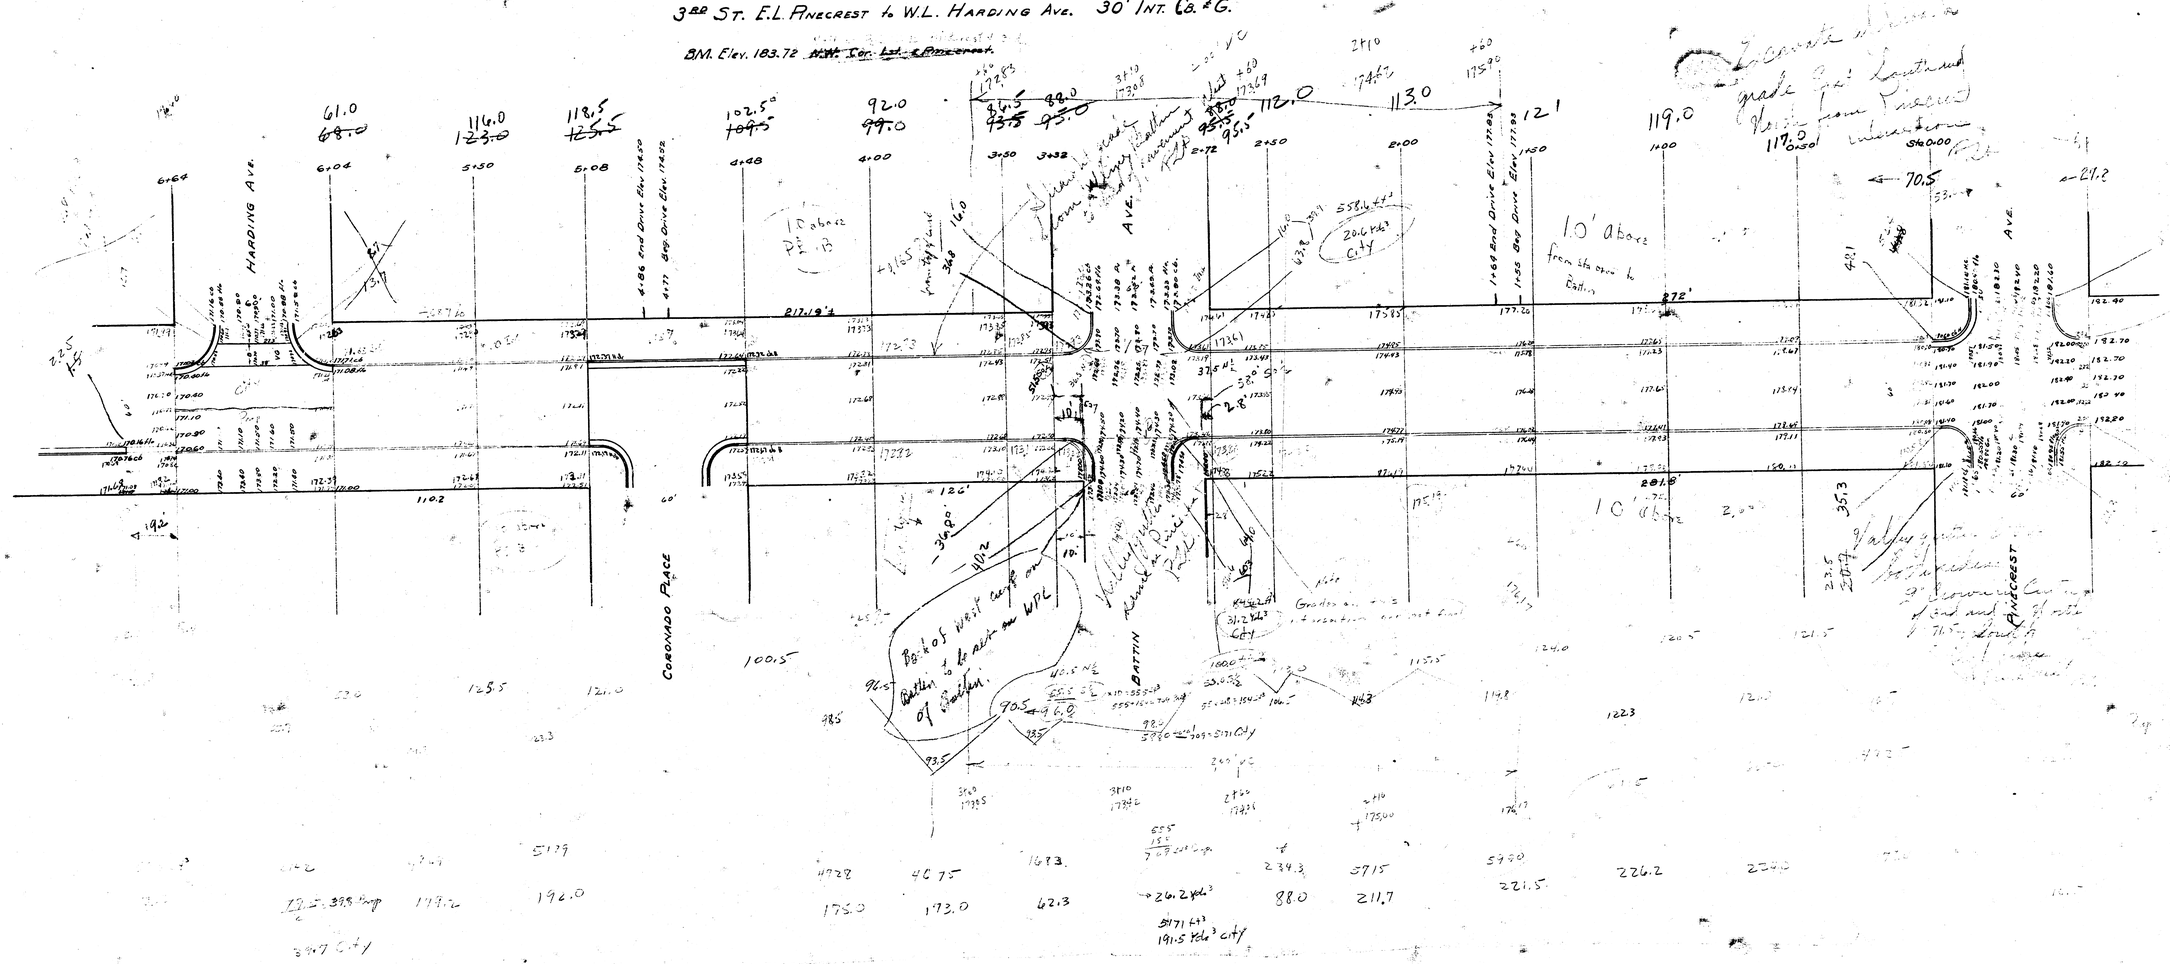
3RD ST. E.L. PINECREST to W.L. HARDING AVE. 30' INT. CO. & G.

BM. Elev. 183.72 ~~A.W. Ior. Ld. Pinecrest.~~


HARDING AVE.
CORONADO PLACE
BATTIN
AVE.
PINECREST
AVE.
Locate at least 1' above grade for Southward flow from Pinecrest Intersection
1.0' above from the grade to Battin
10' above P.I. 13
Bk of west curb on WPL Battin to be at same elev. of Pinecrest.
