3RD ST. E.L. PINECREST to W.L. HARDING AVE. 30' PAV. INT. C.G. & G.
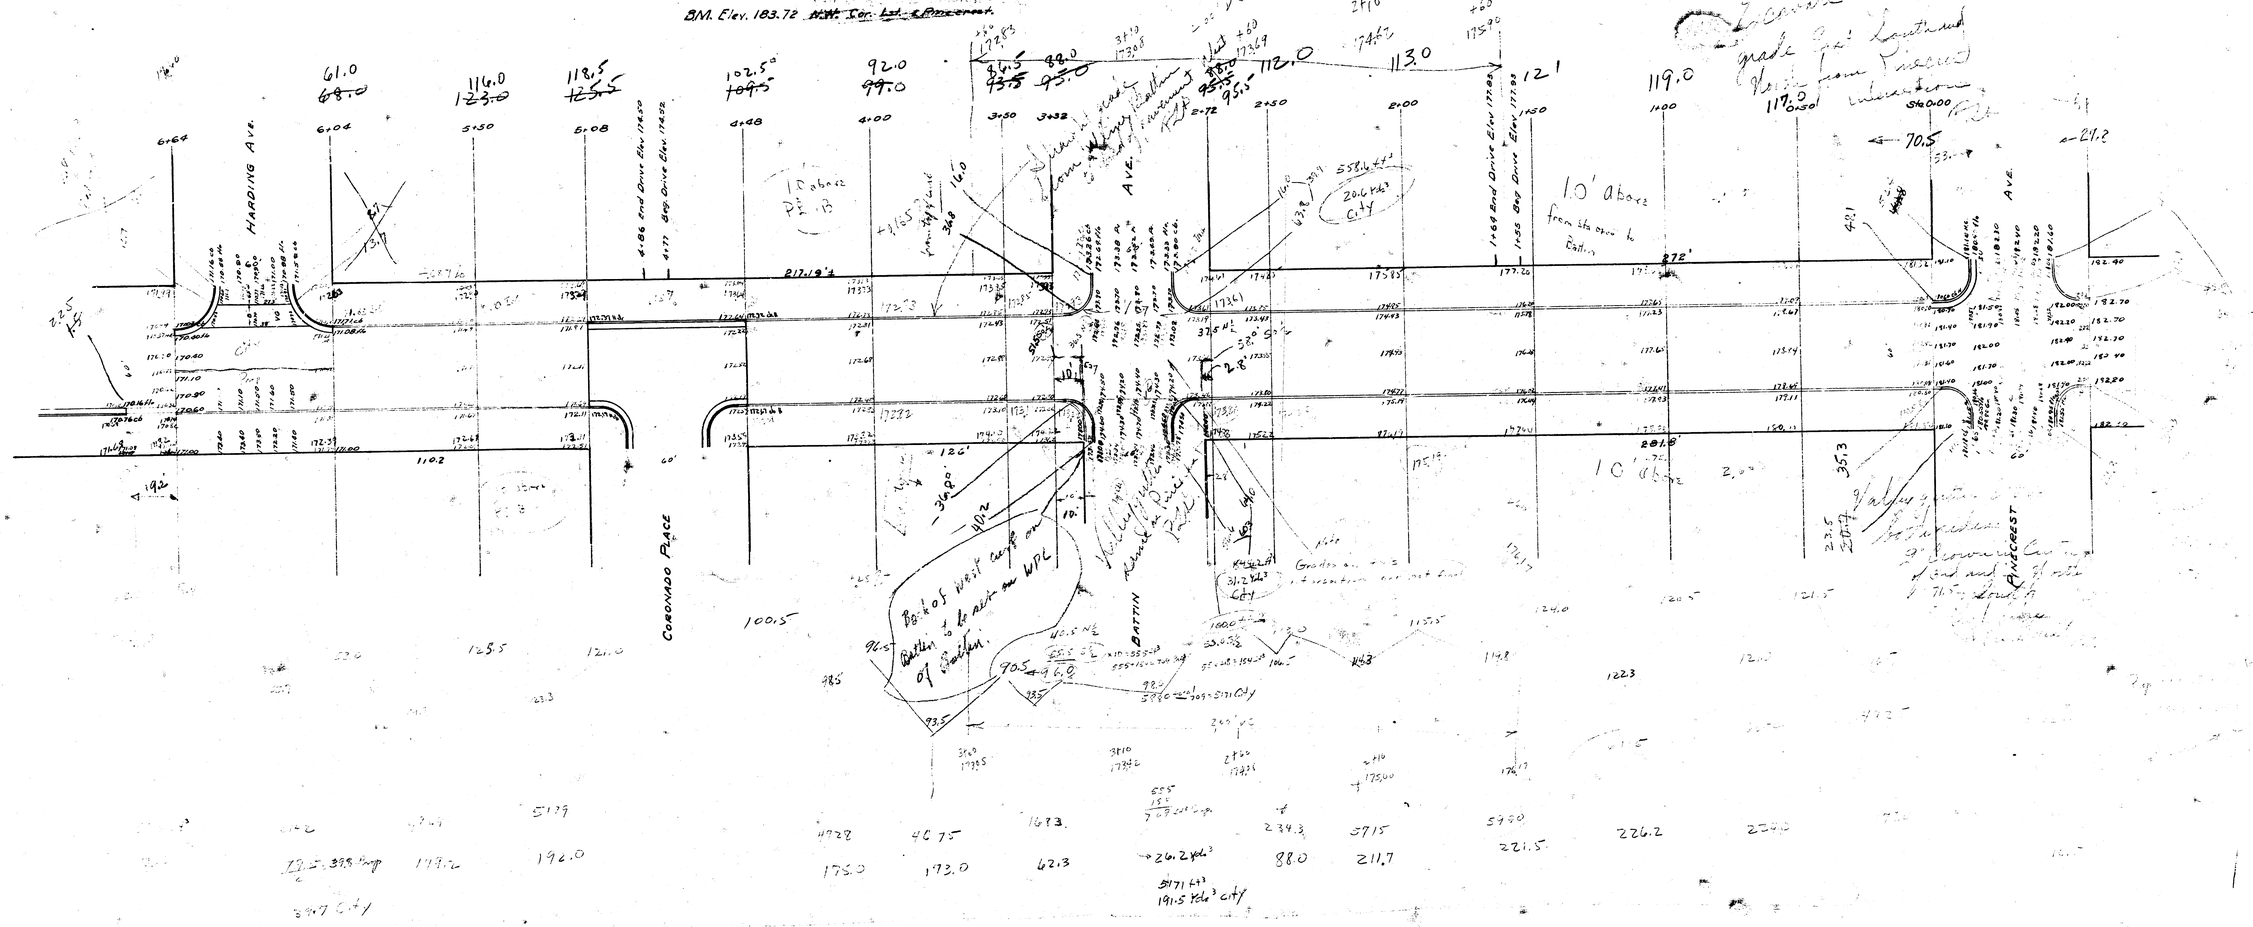
B.M. Elev. 183.72 ~~N.W. Cor. Lot 1 Pinecrest~~