
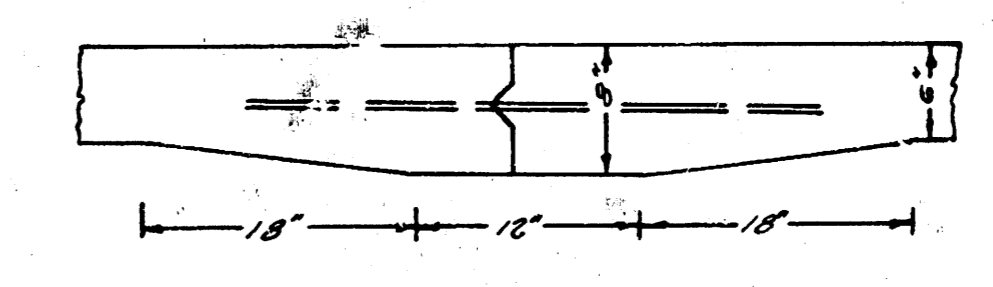



B.M. 198.18 Spike W.S. Power Pole N.S. Murock & W.S. Woodlawn
 B.M. 201.37 R.R. Spike in W.S. R.R. South of South Line of 8th E. of W.L. of Woodlawn
 Chaining From W. to E. on N.E.

| Excav. | | Grand Total Excav. | |
|--------------|---------------|--------------------|---------------|
| Prop. | City | Prop. | City |
| 1317.2 | 0 | 1317.2 | 0 |
| 1308.5 | | 1308.5 | |
| 2505.6 | | 2505.6 | |
| +107.0 | | +107.0 | |
| Total | 2754.2 | Total | 2754.2 |

Survey Approved
 By: W.L.W. & B.
 Exc. D.E.C.
 Checked: J.T.

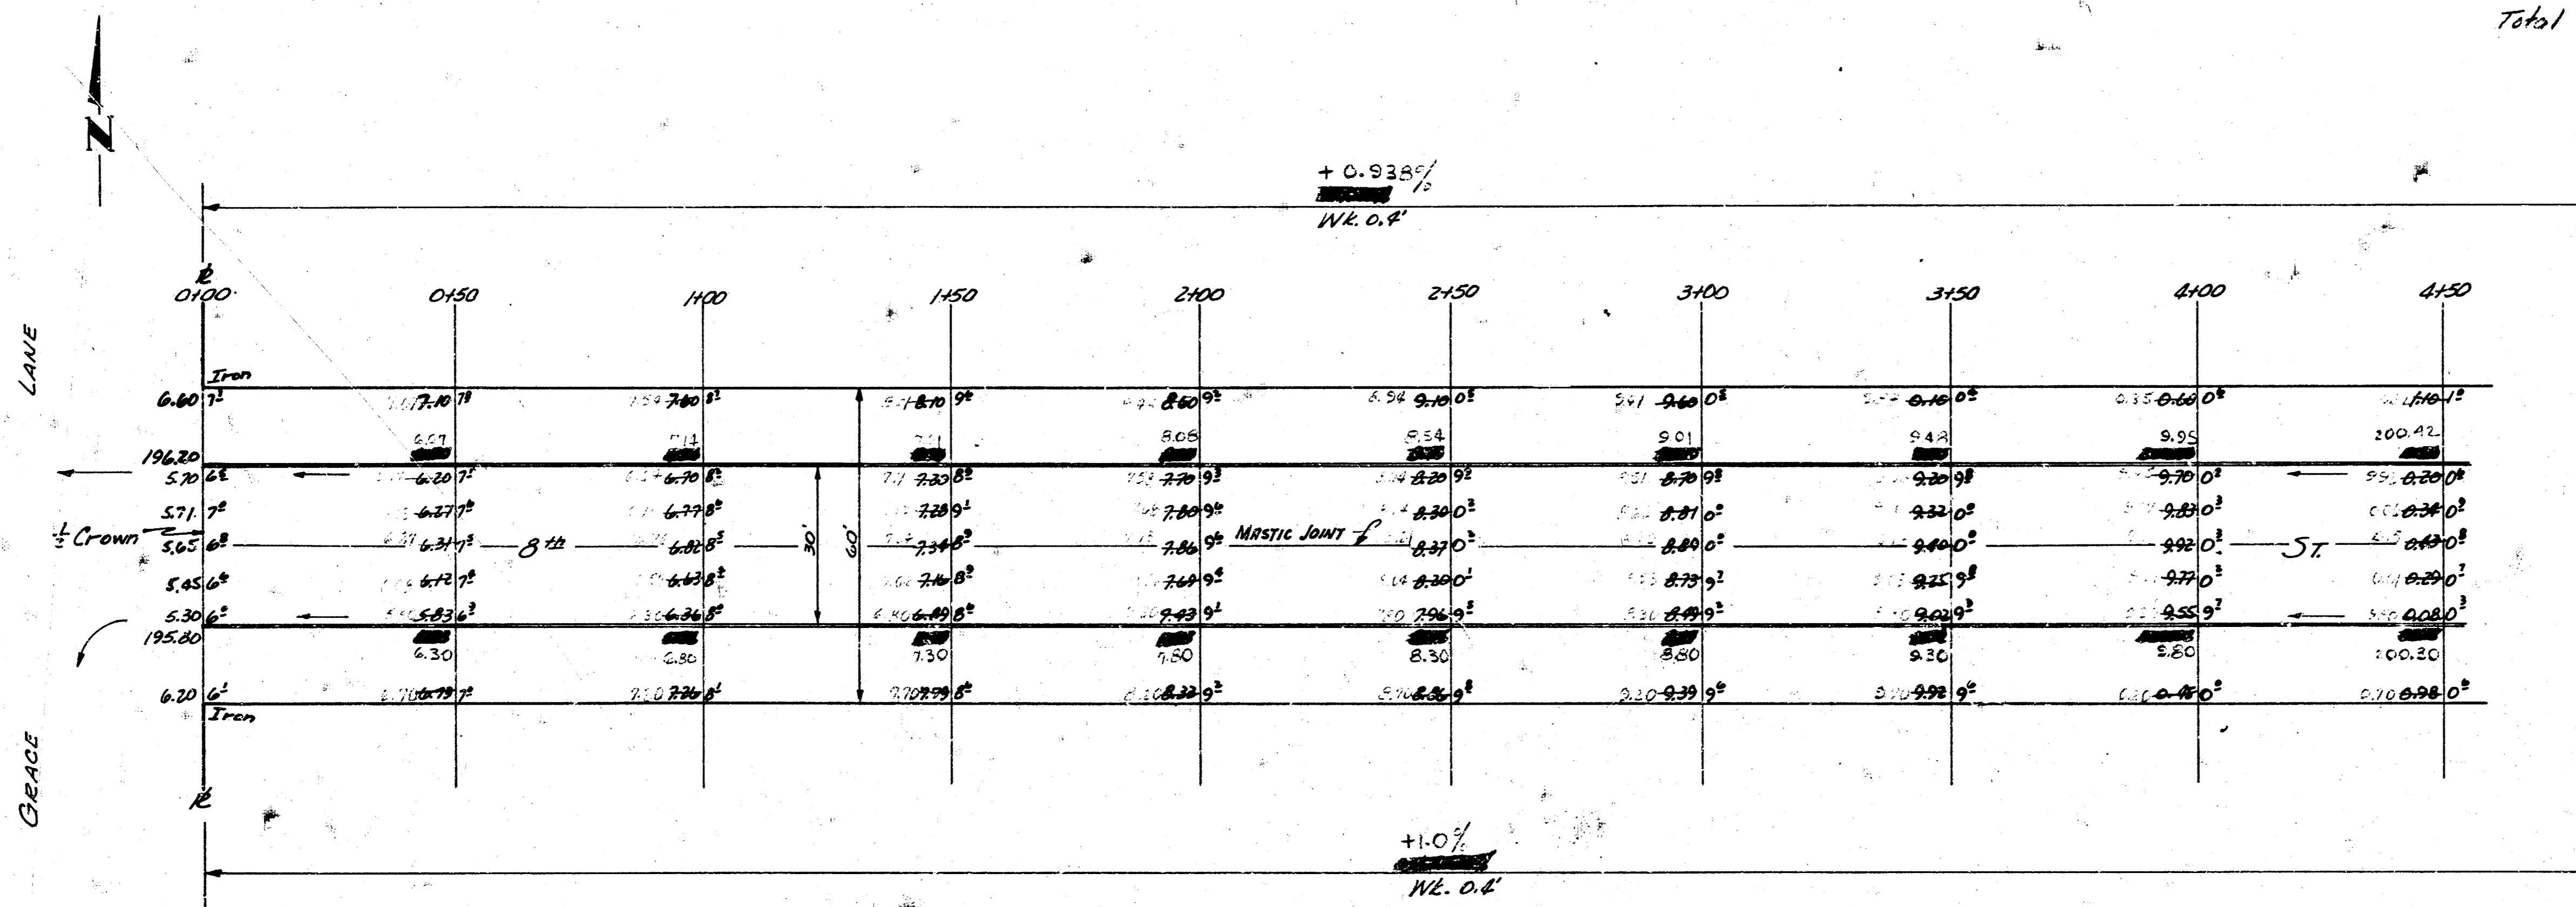

Use 1/2" bars, 3' long on 2'-6" centers
 DETAIL OF MASTIC JOINT

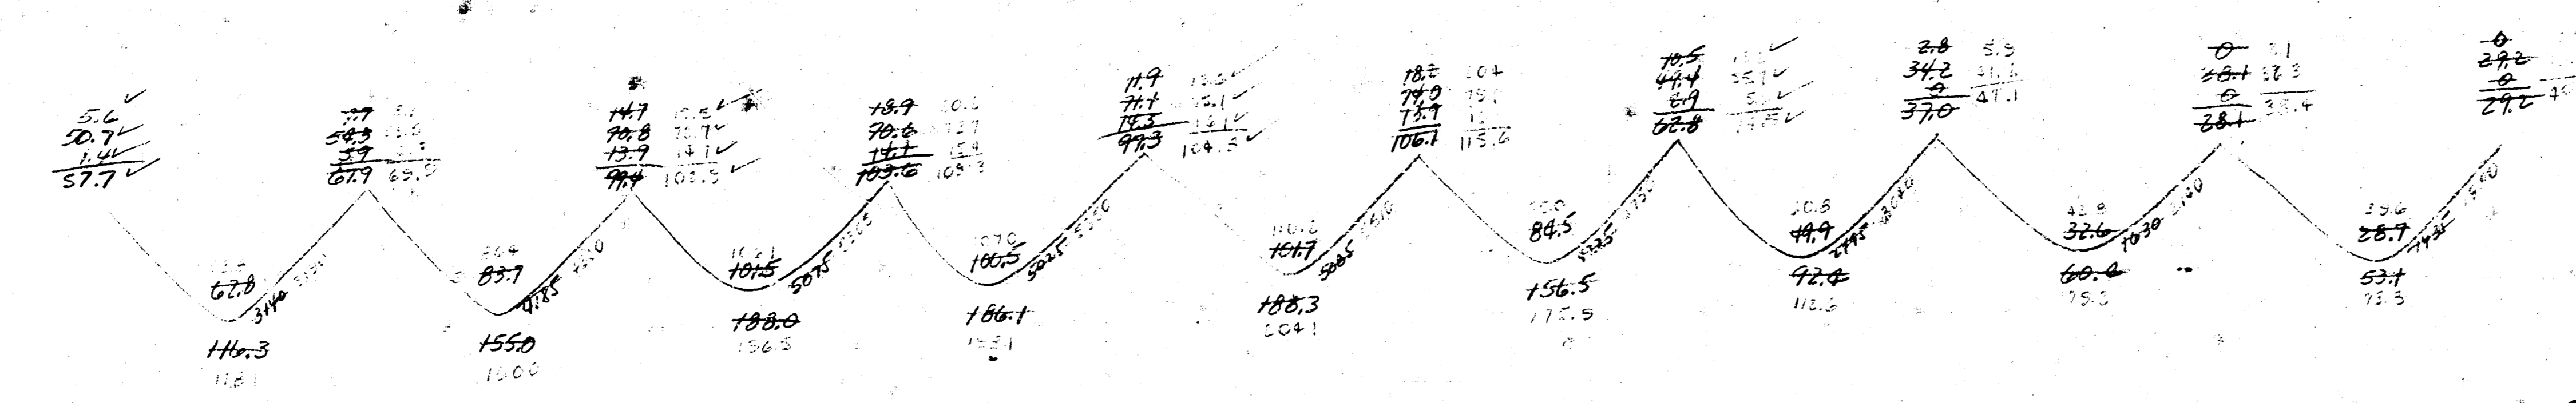

1
2



8th St.
 E.L. Grace Lane To W.L. Woodlawn
 30' Conc. & Co.
 CITY OF WICHITA, KANSAS
 B.E. SMITH CITY ENGINEER
 MAY 1934 PERM. NO. C14-56

