


46 y

E.M-19110 - S.W. CORNER PORCH HO. NE. CORNER GLENDALE & 8th SOUTH PORCH.

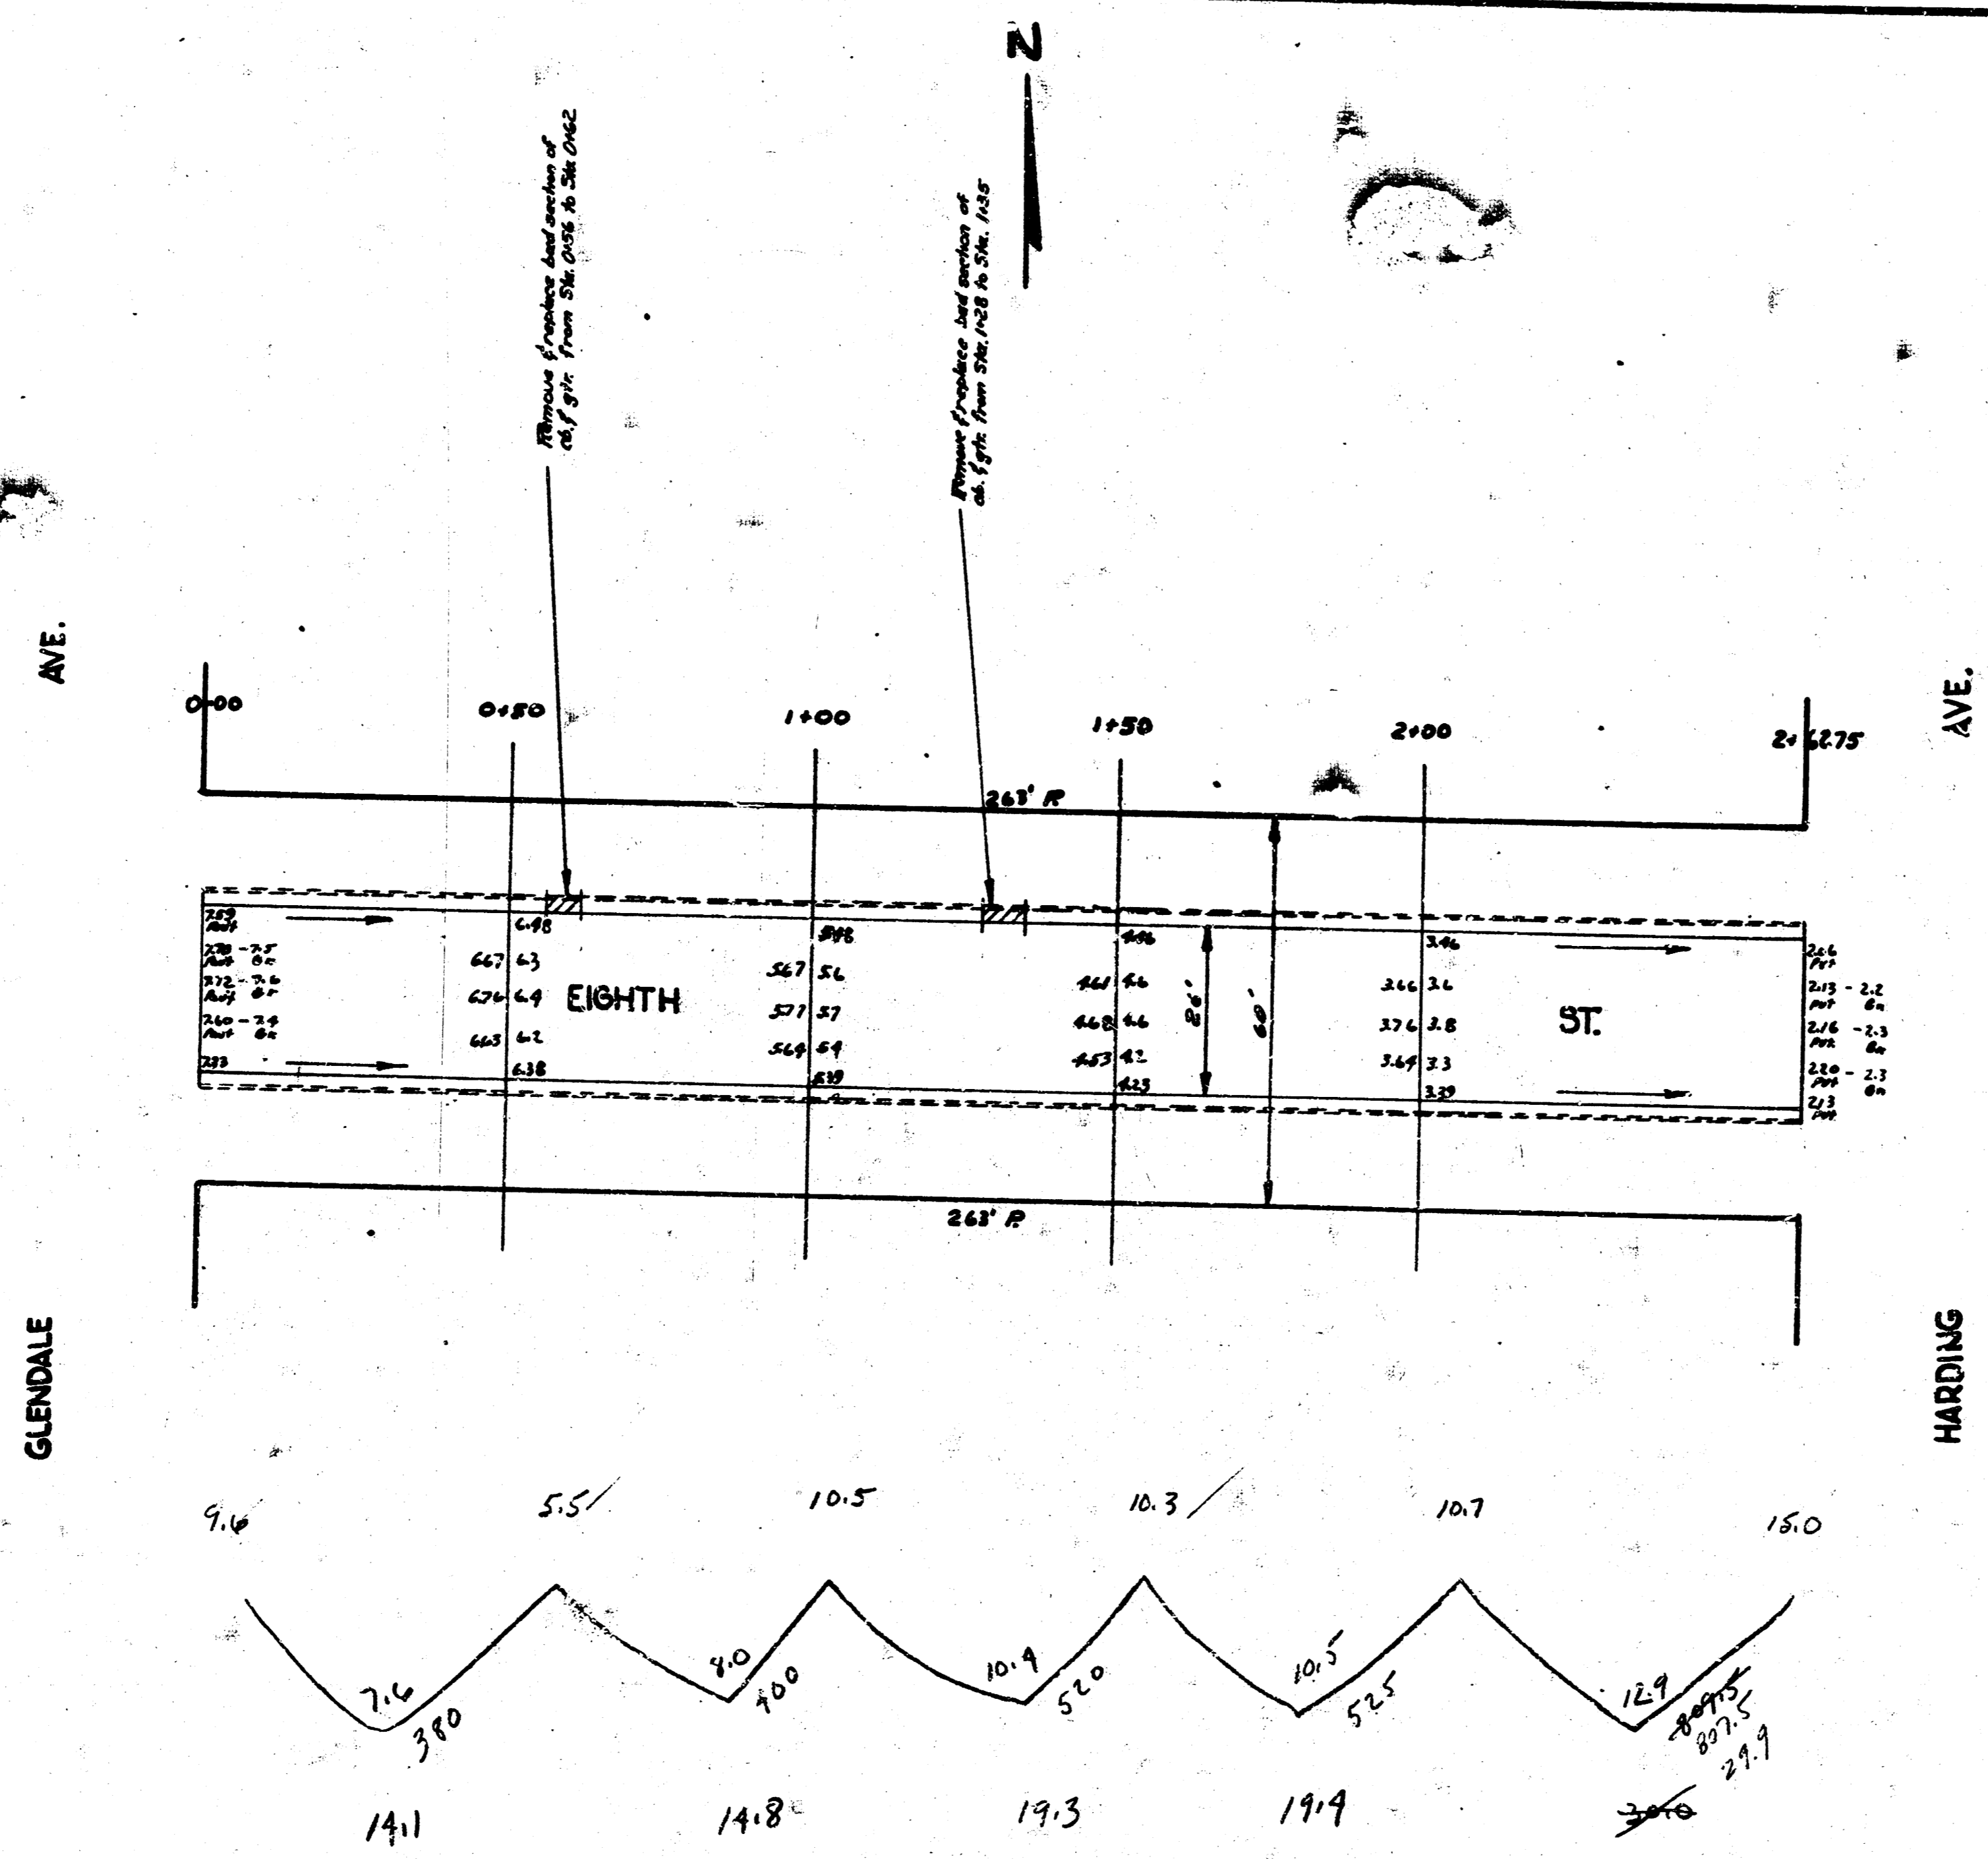

Property	City
14.1	
14.8	0
15.3	
19.4	
31.0	
97.6	
+10%	
107.4	low pds.

EIGHTH STREET
 E.L. GLENDALE to W.L. HARDING
 26' Conc.
 CITY OF WICHITA, KANS.
 L.K. WHITE CITY ENGINEER
 SEPT. 1950, PROJ. NO. C10-123

4 e s (51)