
46 y

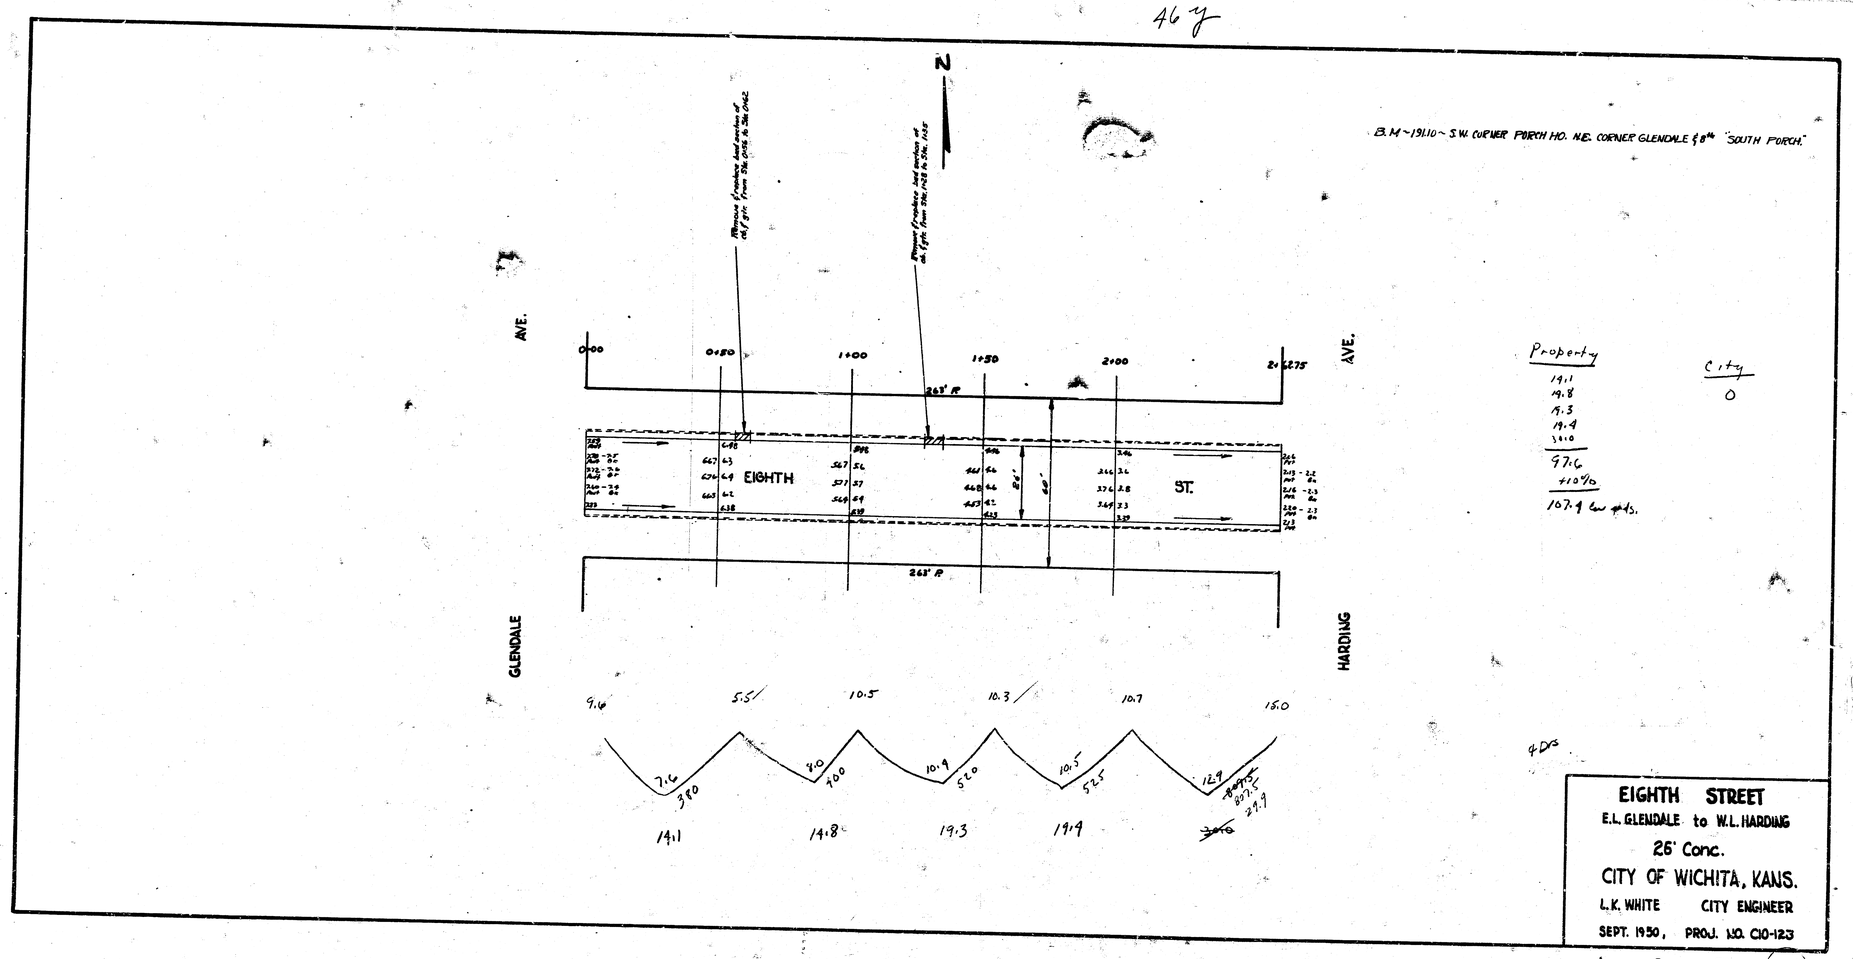

Property	City
19.1	0
19.8	
19.3	
19.9	
19.0	
97.6	
+10%	
107.9 Lin. ft.	

40 ft

EIGHTH STREET
E.L. GLENDALE to W.L. HARDING
26' Conc.
CITY OF WICHITA, KANS.
L.K. WHITE CITY ENGINEER
SEPT. 1950, PROJ. NO. C10-123

4 e 5 51