


B.M. 119.03 "X" on N. cb. 8<sup>th</sup> E. L. Grove.

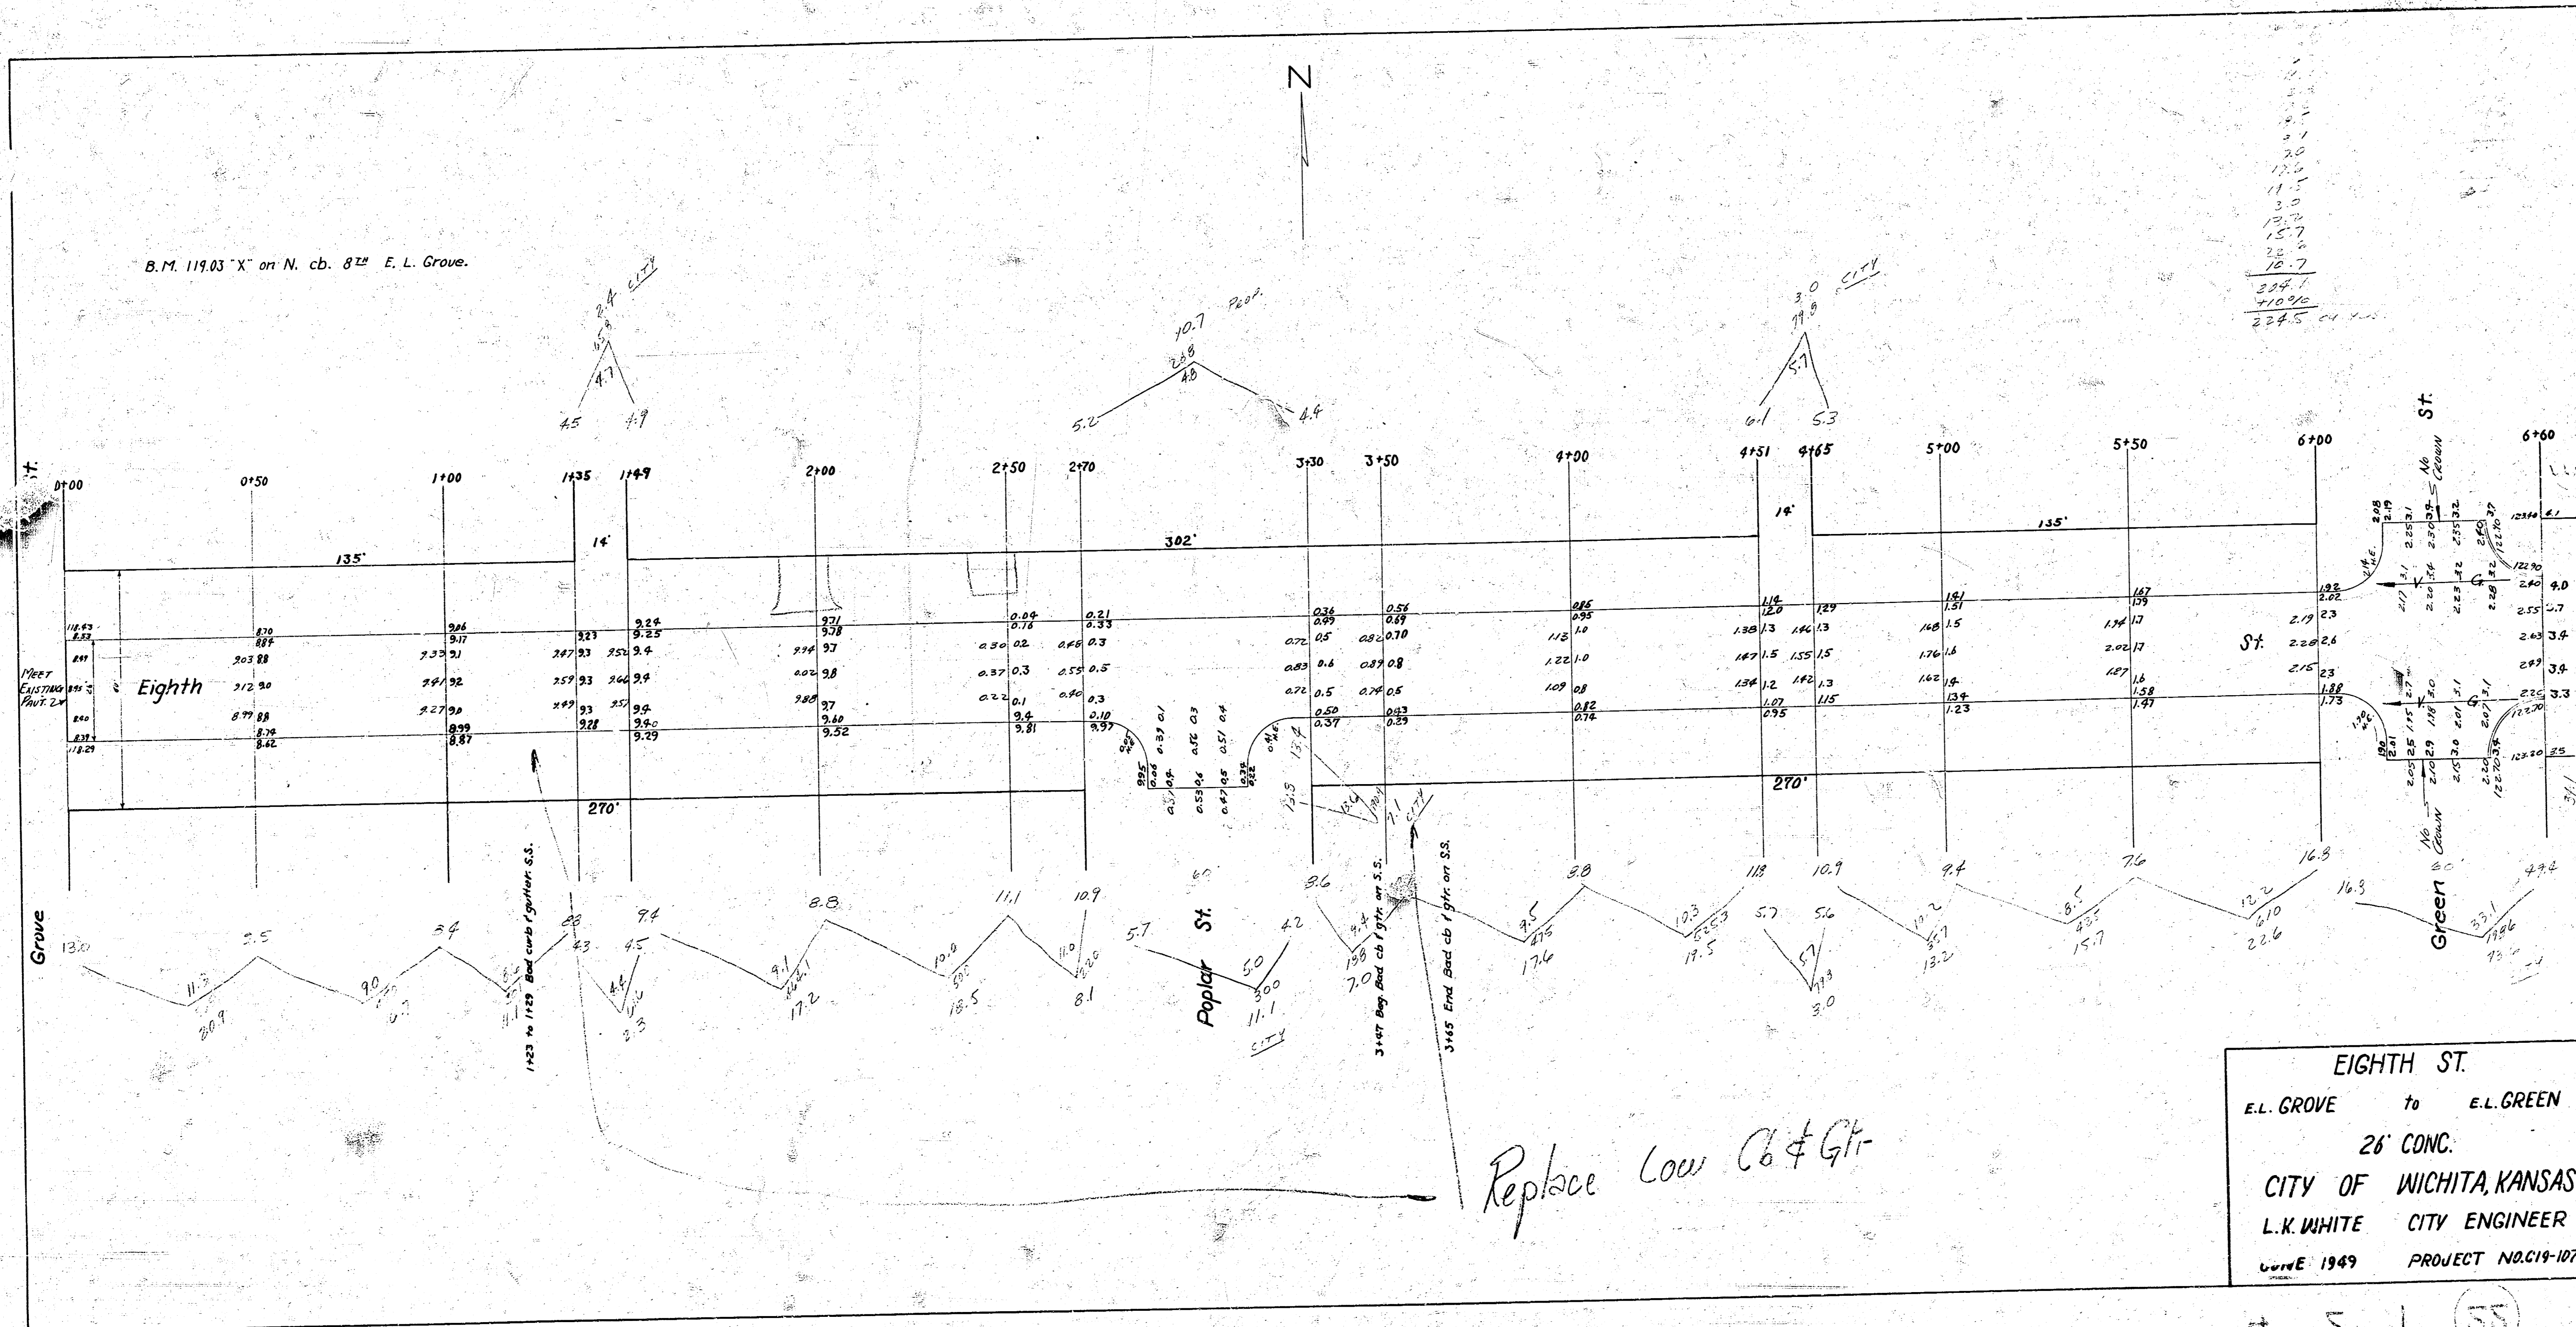

EIGHTH ST.  
 E.L. GROVE to E.L. GREEN  
 26' CONC.  
 CITY OF WICHITA, KANSAS  
 L.K. WHITE CITY ENGINEER  
 WARD 1949 PROJECT NO. C19-107

4 5 1 55