


B.M. 12122 Top Iron 3L 10" St. E.L. Estelle

WK 0.4'

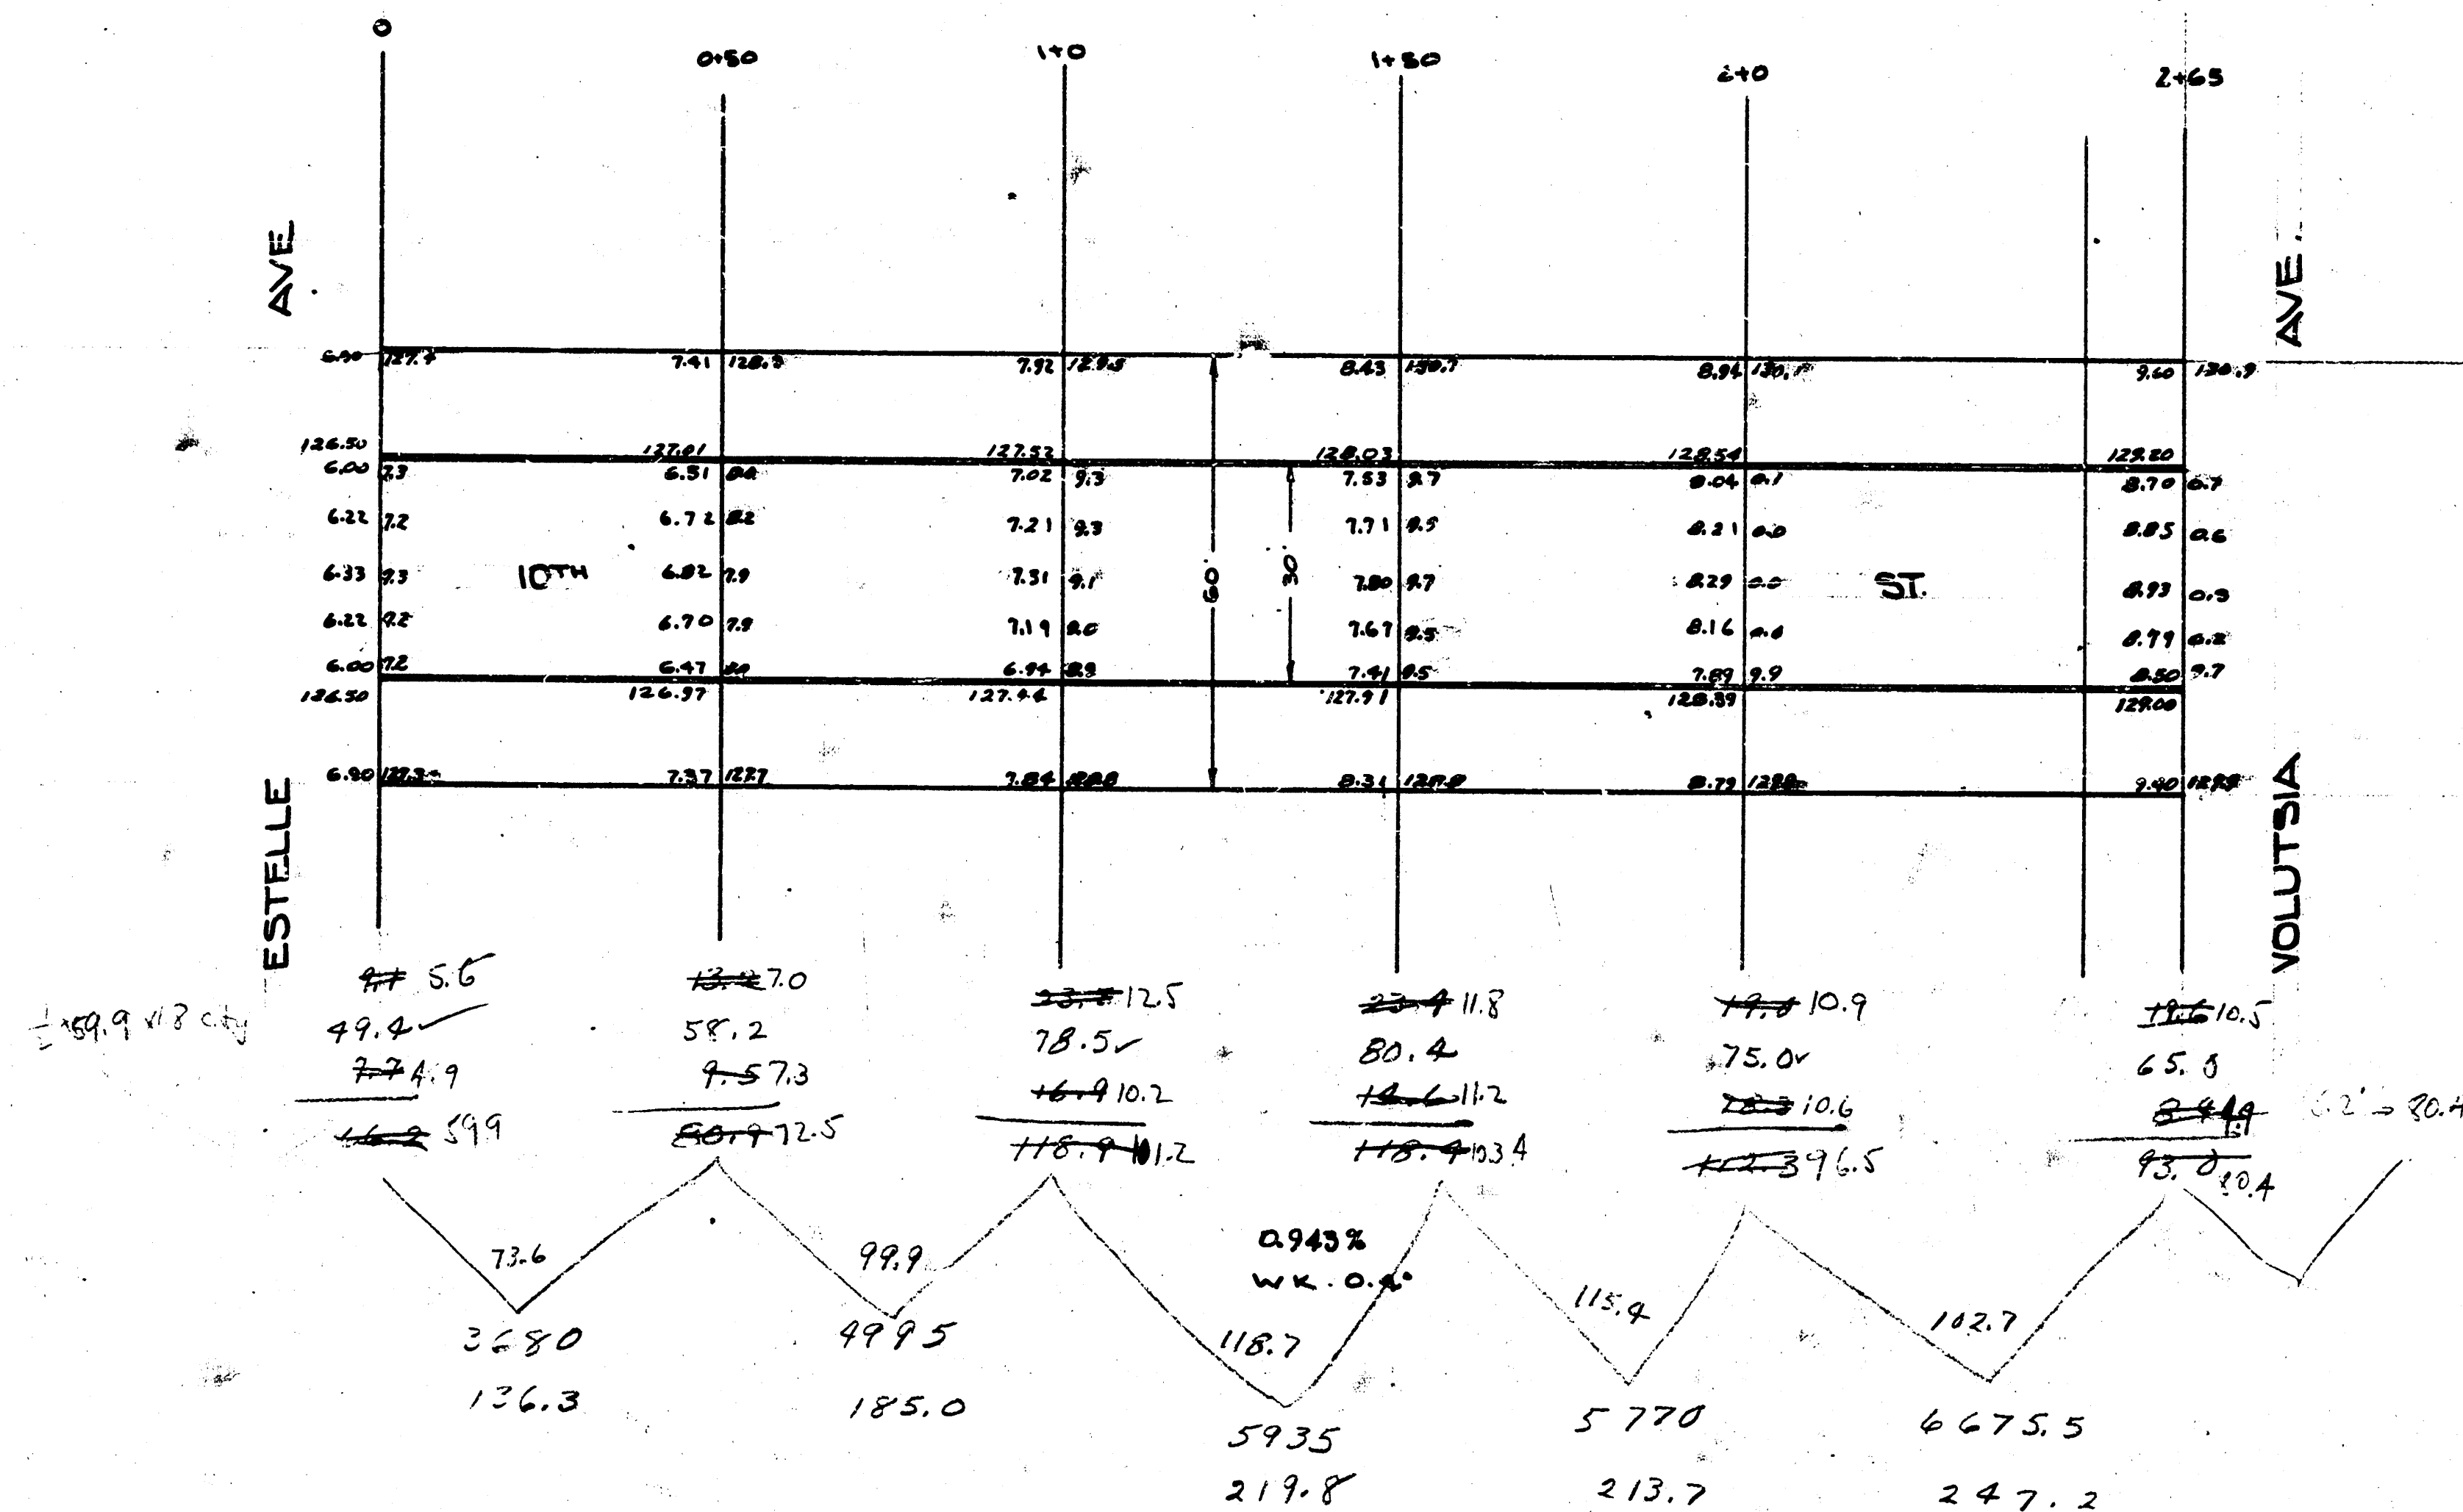

Rep.

247.2
213.7
219.8
185.0
136.3
1002.0
100.2
1102.2 on yd.

TENTH ST.
E.L. ESTELLE + W.L. VOLUTSIA
30' CONCRETE
CITY OF WICHITA, KANS.
L.K. WHITE - CITY ENGR
MARCH 1947

1018