


H-3

Prop. C12-100

Prop. C11-248

BM. 204.17 M IN MUELLER TOP H.V. 5 N COR EDGEMOOR & 10TH

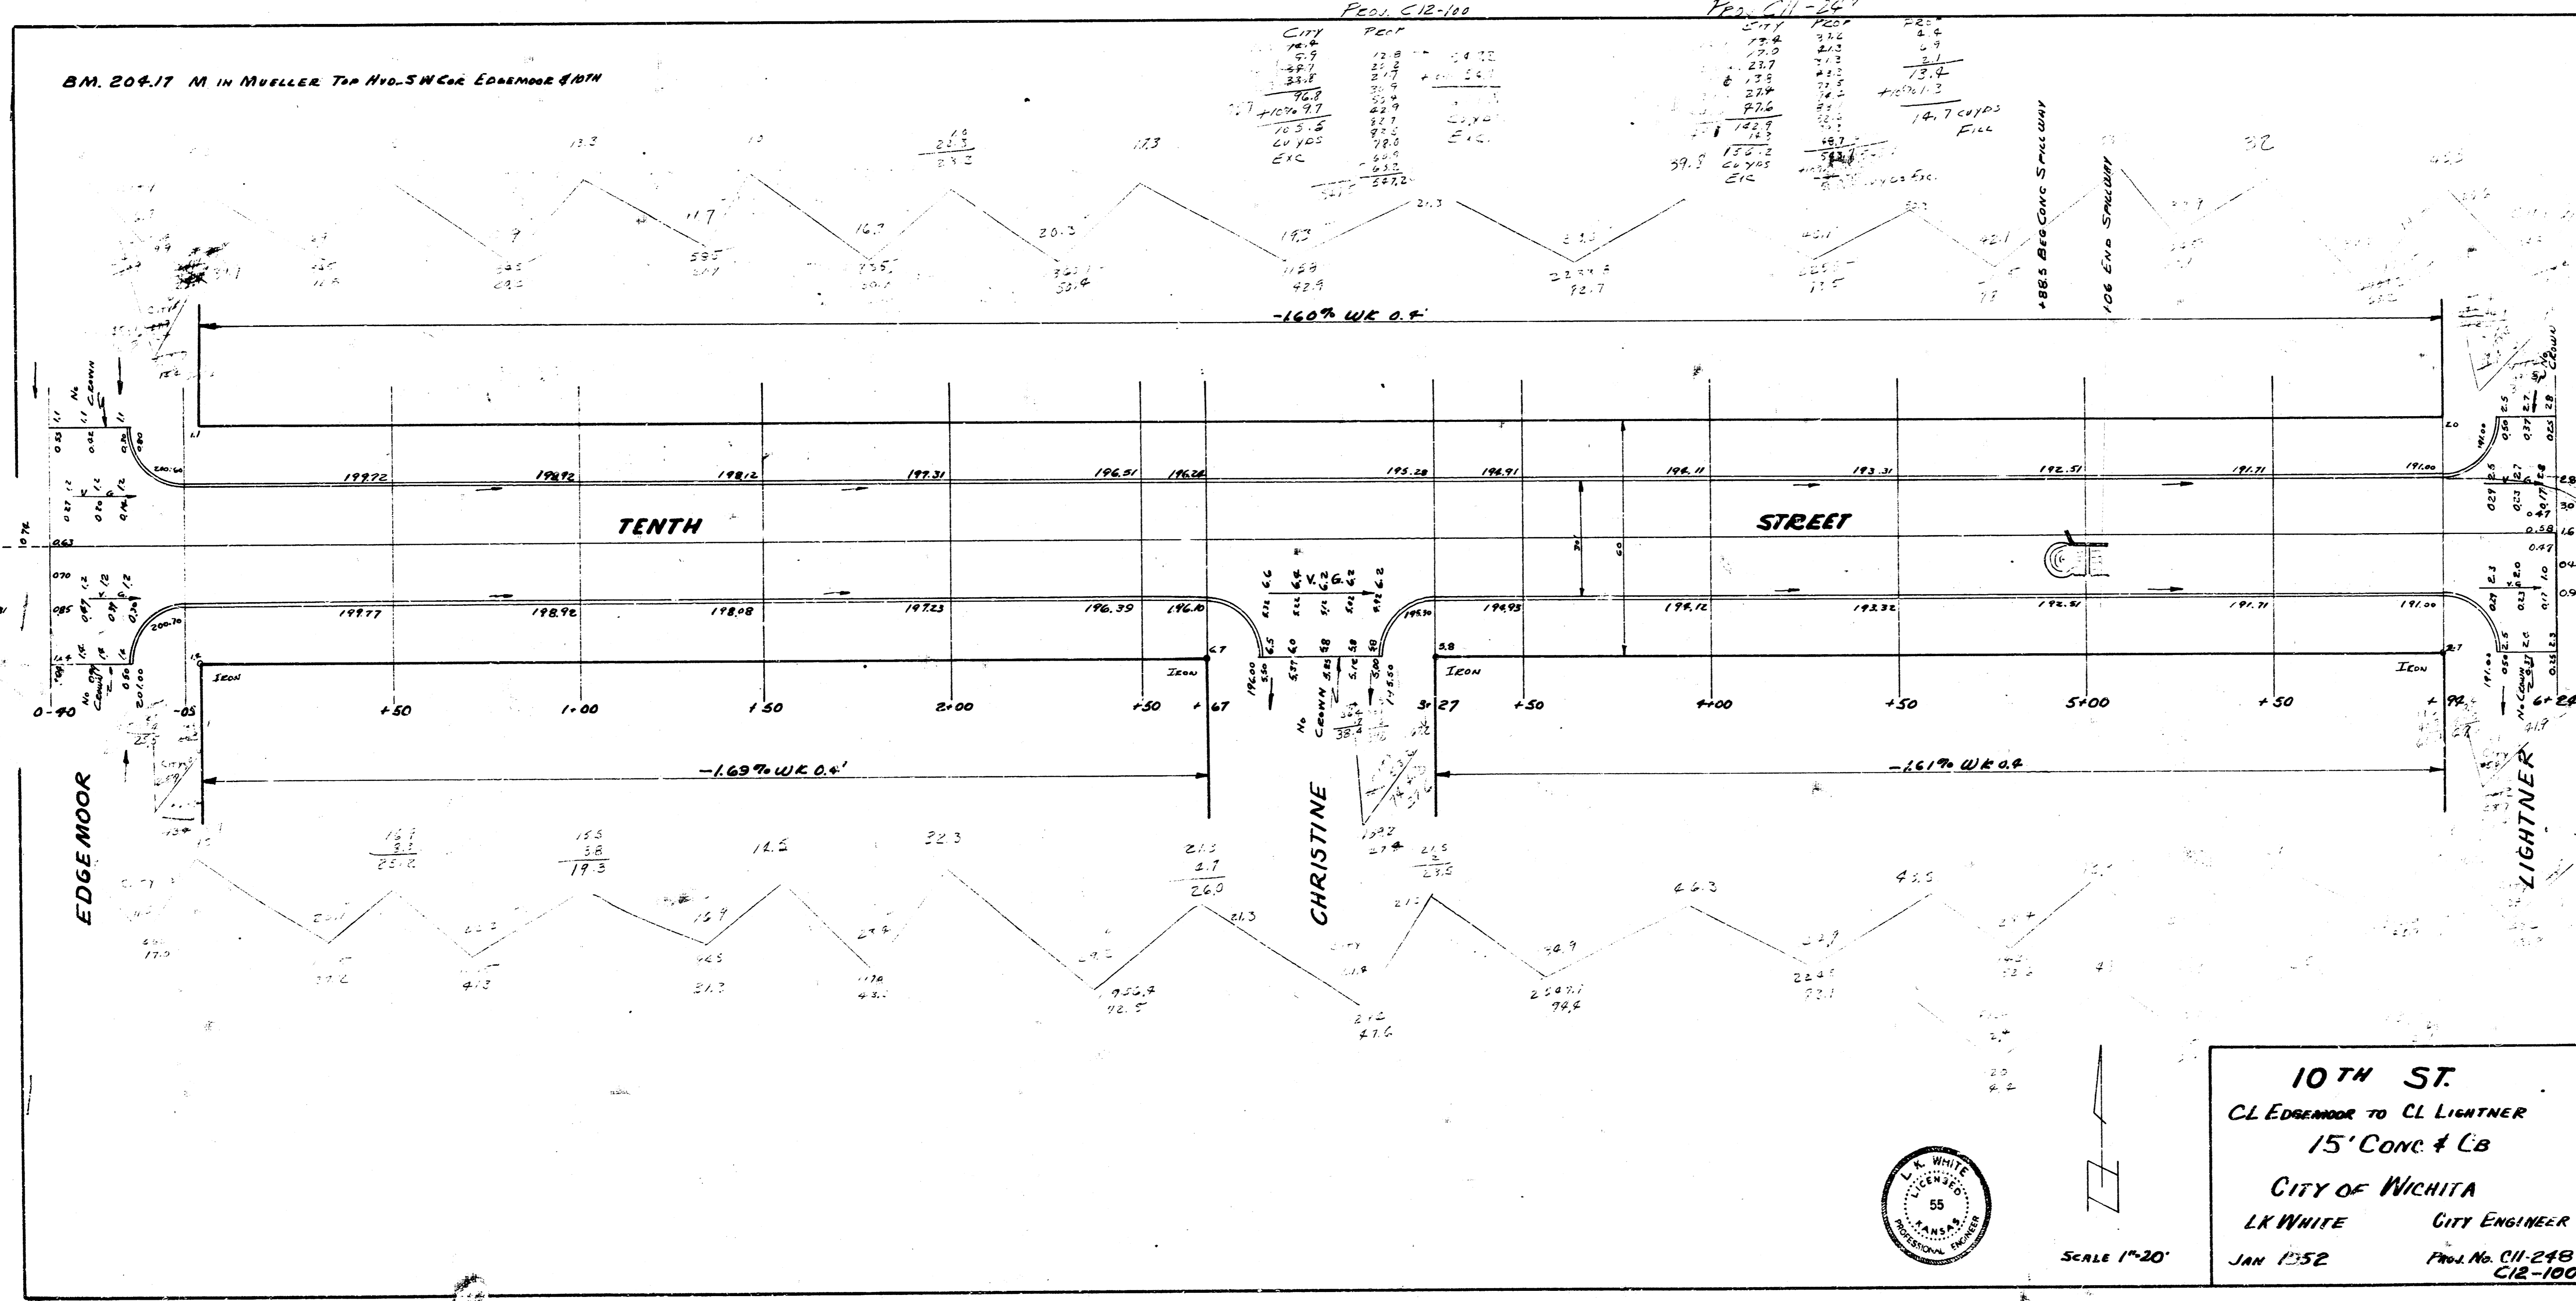

