


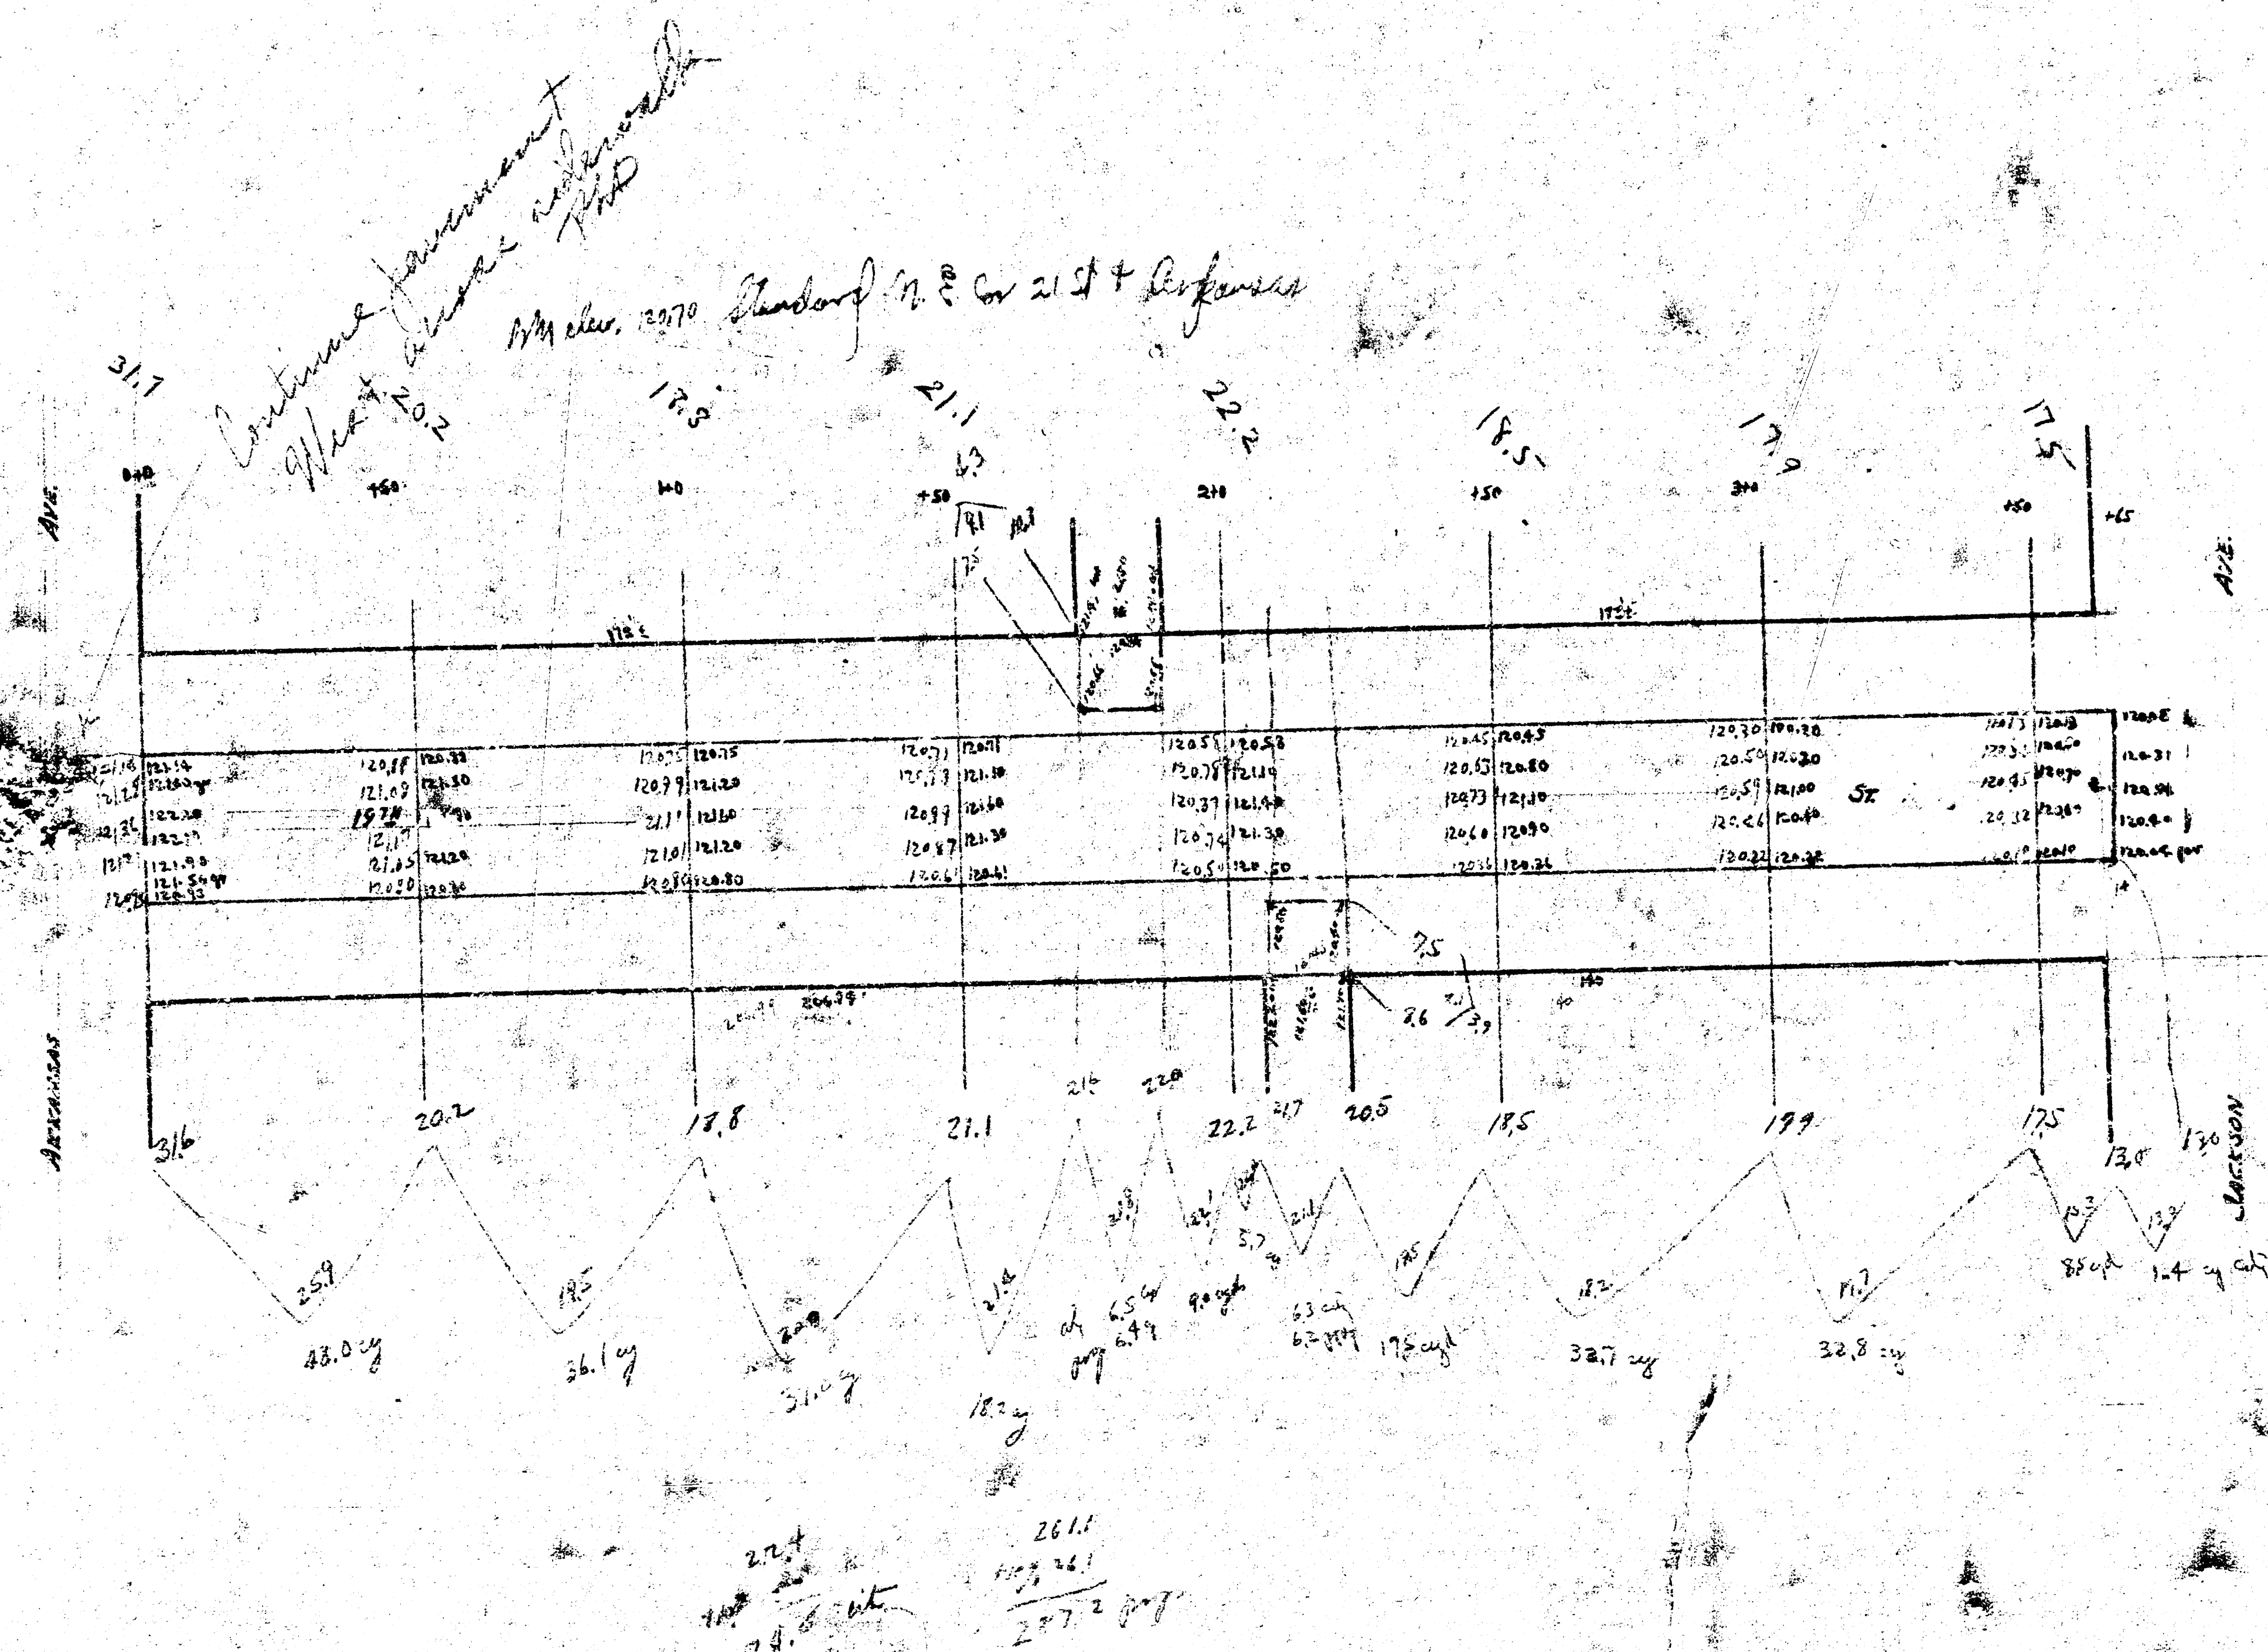

Fox Plod
1939
193 St.
E.L. Arkansas
to
W.L. Jackson