



Property	City

70
8.0
7.0
8.5
546
174 City 20.2

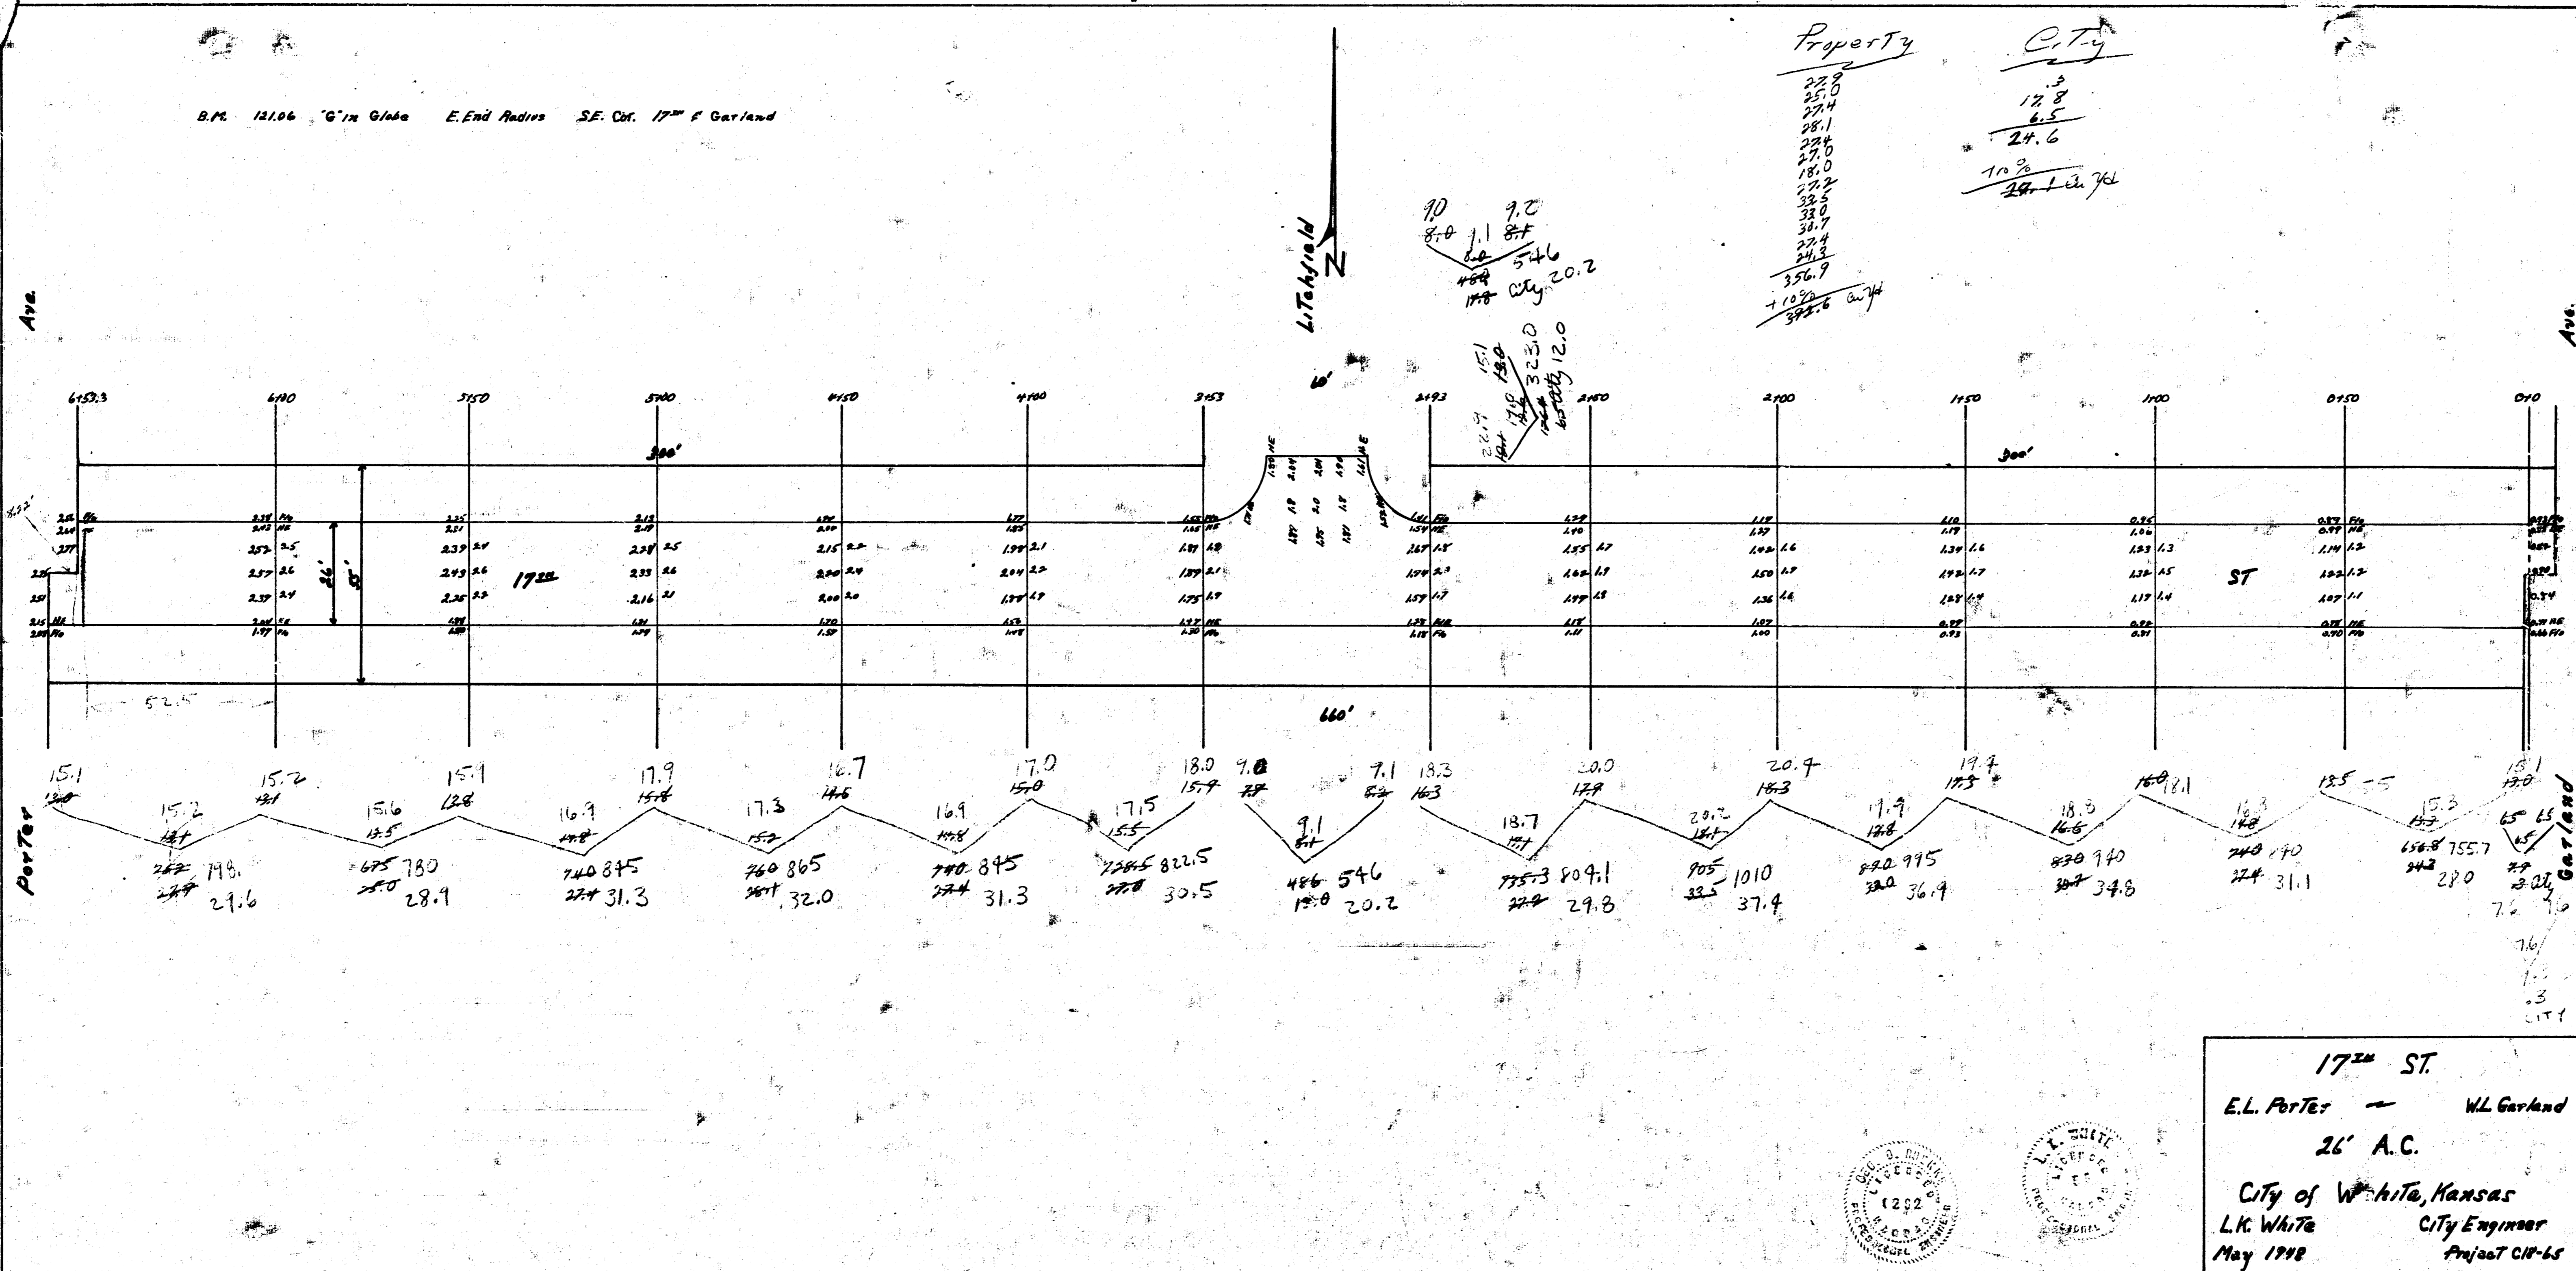

17th ST.
E.L. Porter — W.L. Garland
26' A.C.
L.K. White City Engineer
