* B.M. 128.50 'R' in Pitchie, W. end, N.W. Return, Westridge & 17th
B.M. 130.80 N.W. Cor. Porch, 3715 W. 17th,
S.E. Cor. High & 17th.

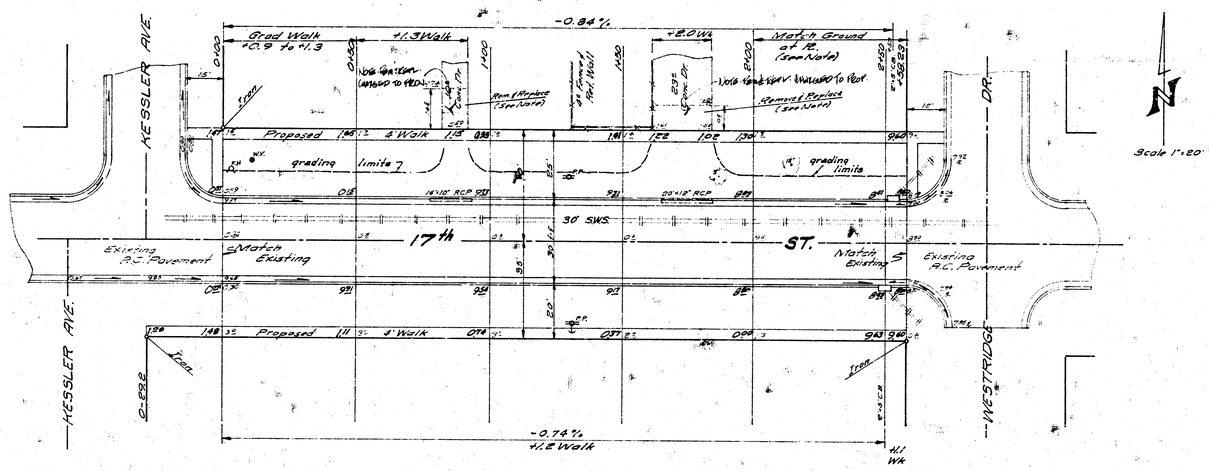

Note:
Contractor to Grade and Clear Parking for Proposed Sidewalk. Sidewalk to be Constructed by 'OTHERS'.

Contractor to Refer to Cross-Sections for Grading North Side of 17th Street.

Field Engineer to Check with Property Owners Before Constructing Drives.

* EARTHWORK QUANTITIES *

	Property	Excavation
	735.4 C.Y.	
+10%	73.5 "	
	808.9 C.Y.	

B. E. SMITH LICENSED 436 KANSAS PROFESSIONAL ENGINEER

1/2

17th STREET

From E.L. KESSLER AVE. NORTH
To W.L. WESTRIDGE DRIVE

26'-2'-30' A.C. & CURB

B.E. SMITH CITY ENGINEER
CITY OF WICHITA, KANSAS

DATE APRIL 1968 C17-97