


INDIANA
CURB

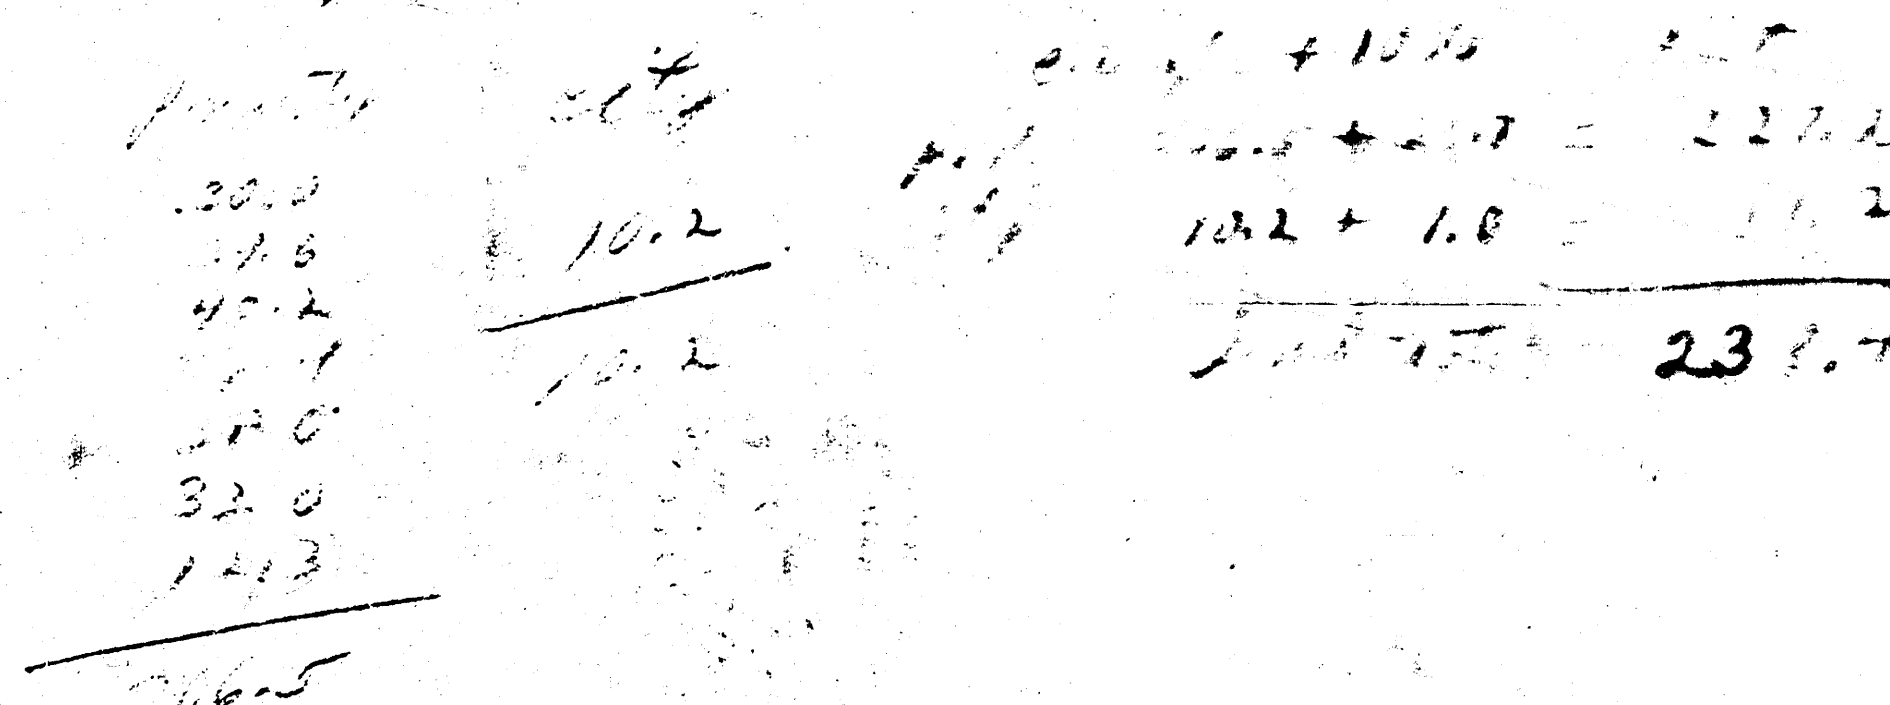

1