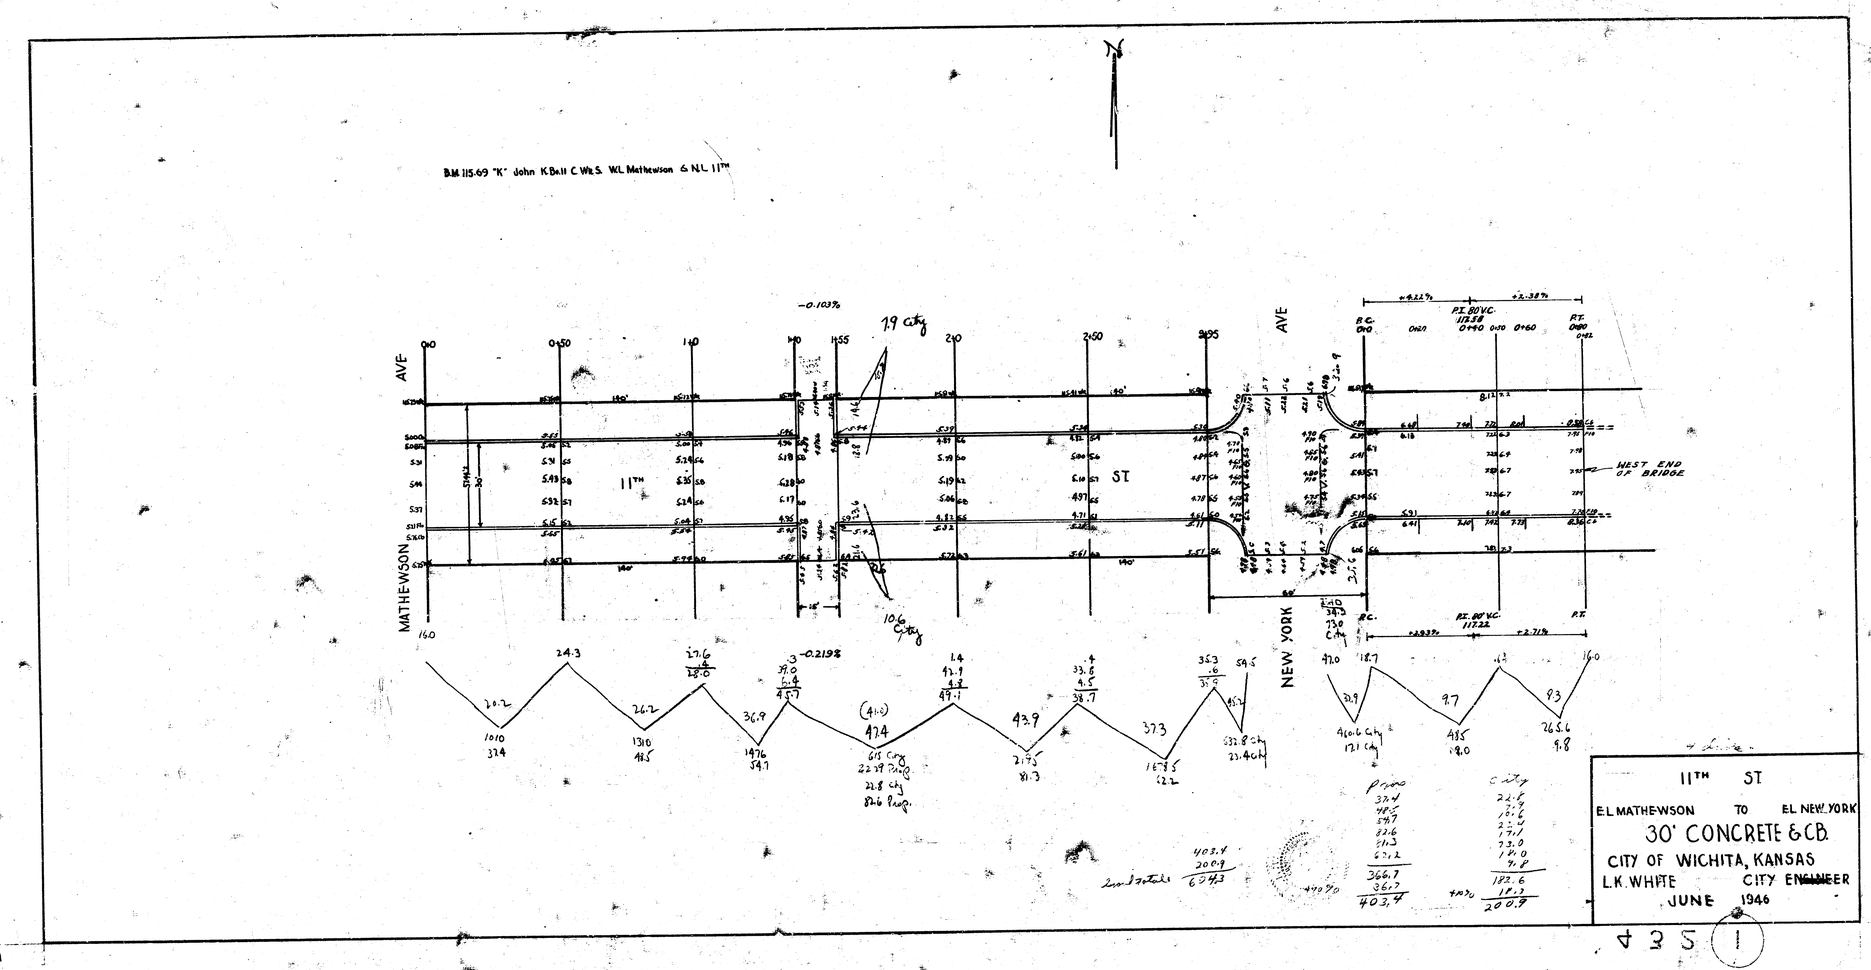
B.M. 115.69 "K" John K. Bell C. Wks. S. W.L. Mathewson & N.L. 11TH
MATHEWSON AVE
11TH ST
NEW YORK AVE
WEST END OF BRIDGE
-0.103%
-0.219%
+0.822%
+2.38%
+0.937%
+2.71%
P.I. 80 VC. 117.50
P.I. 80 VC. 117.22
B.C.
P.T.
END 34.0 130 City
Prime
City
403.4
200.9
603.3
366.7
36.7
403.4
182.6
18.3
200.9
11TH ST
EL MATHEWSON TO EL NEW YORK
30' CONCRETE & C.B.
CITY OF WICHITA, KANSAS
L.K. WHITE CITY ENGINEER
JUNE 1946