


BM 12026 "1" IN LONG SKWK SSW COR BURNS & 16TH

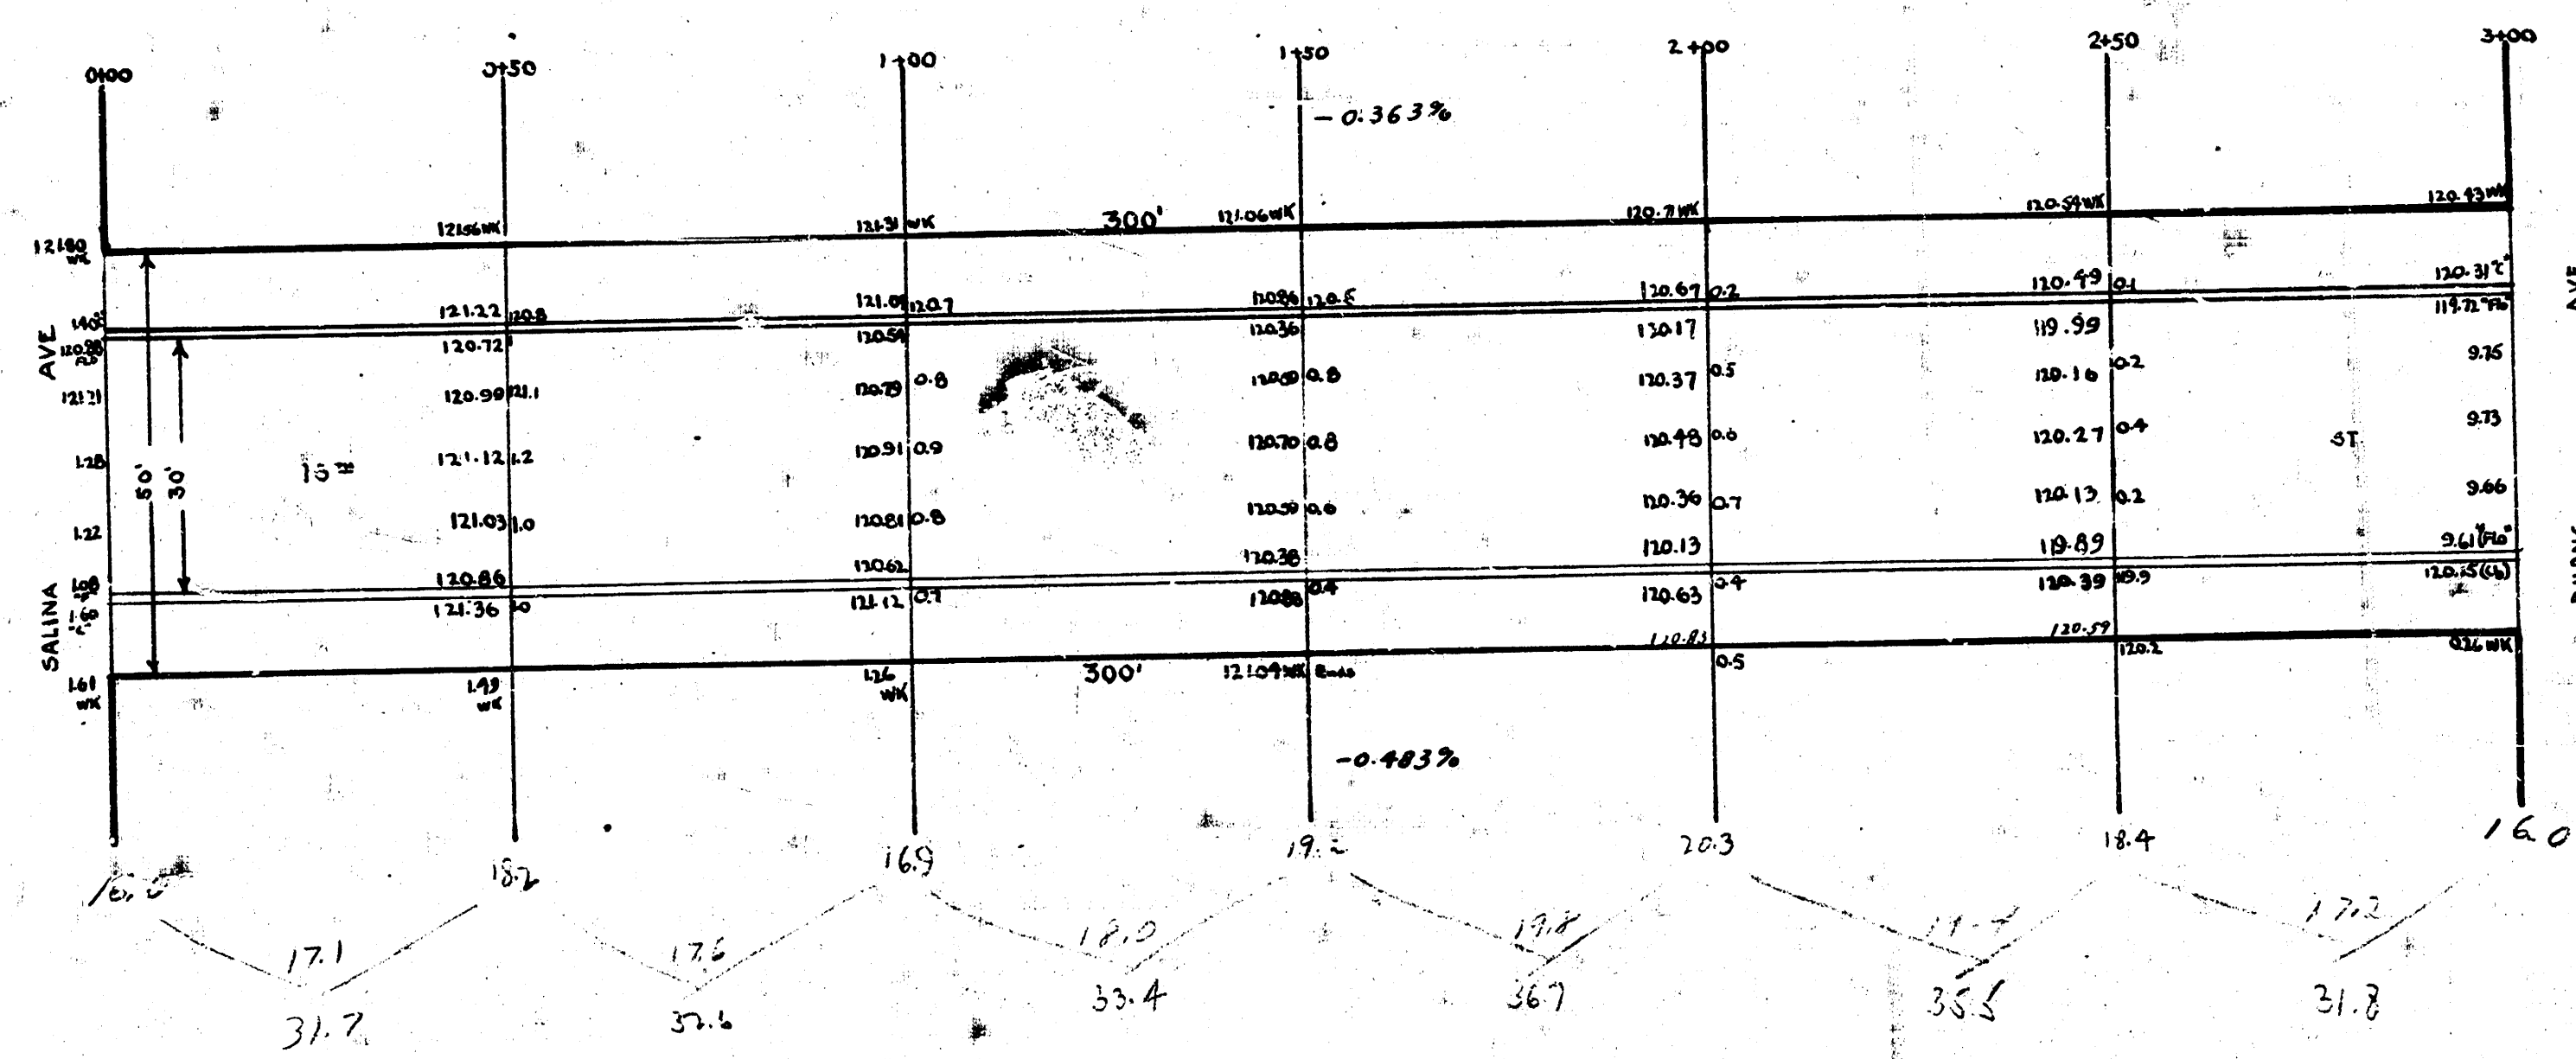

PWD
 31.7
 33.6
 33.4
 36.7
 35.5
 31.4
 201.7
 20.2
 221.9

12 Lines
 16TH ST
 E.L. SALINA TO W.L. BURNS
 30' CONCRETE & CB
 CITY OF WICHITA, KANSAS
 L.K. WHITE CITY ENGINEER
 MAY 1946