


B.M. 119.16 Std. N.E. Cor. 17TH & Arkansas
B.M. 119.34 Iron in thimble & Jackson No. N.I. 16TH

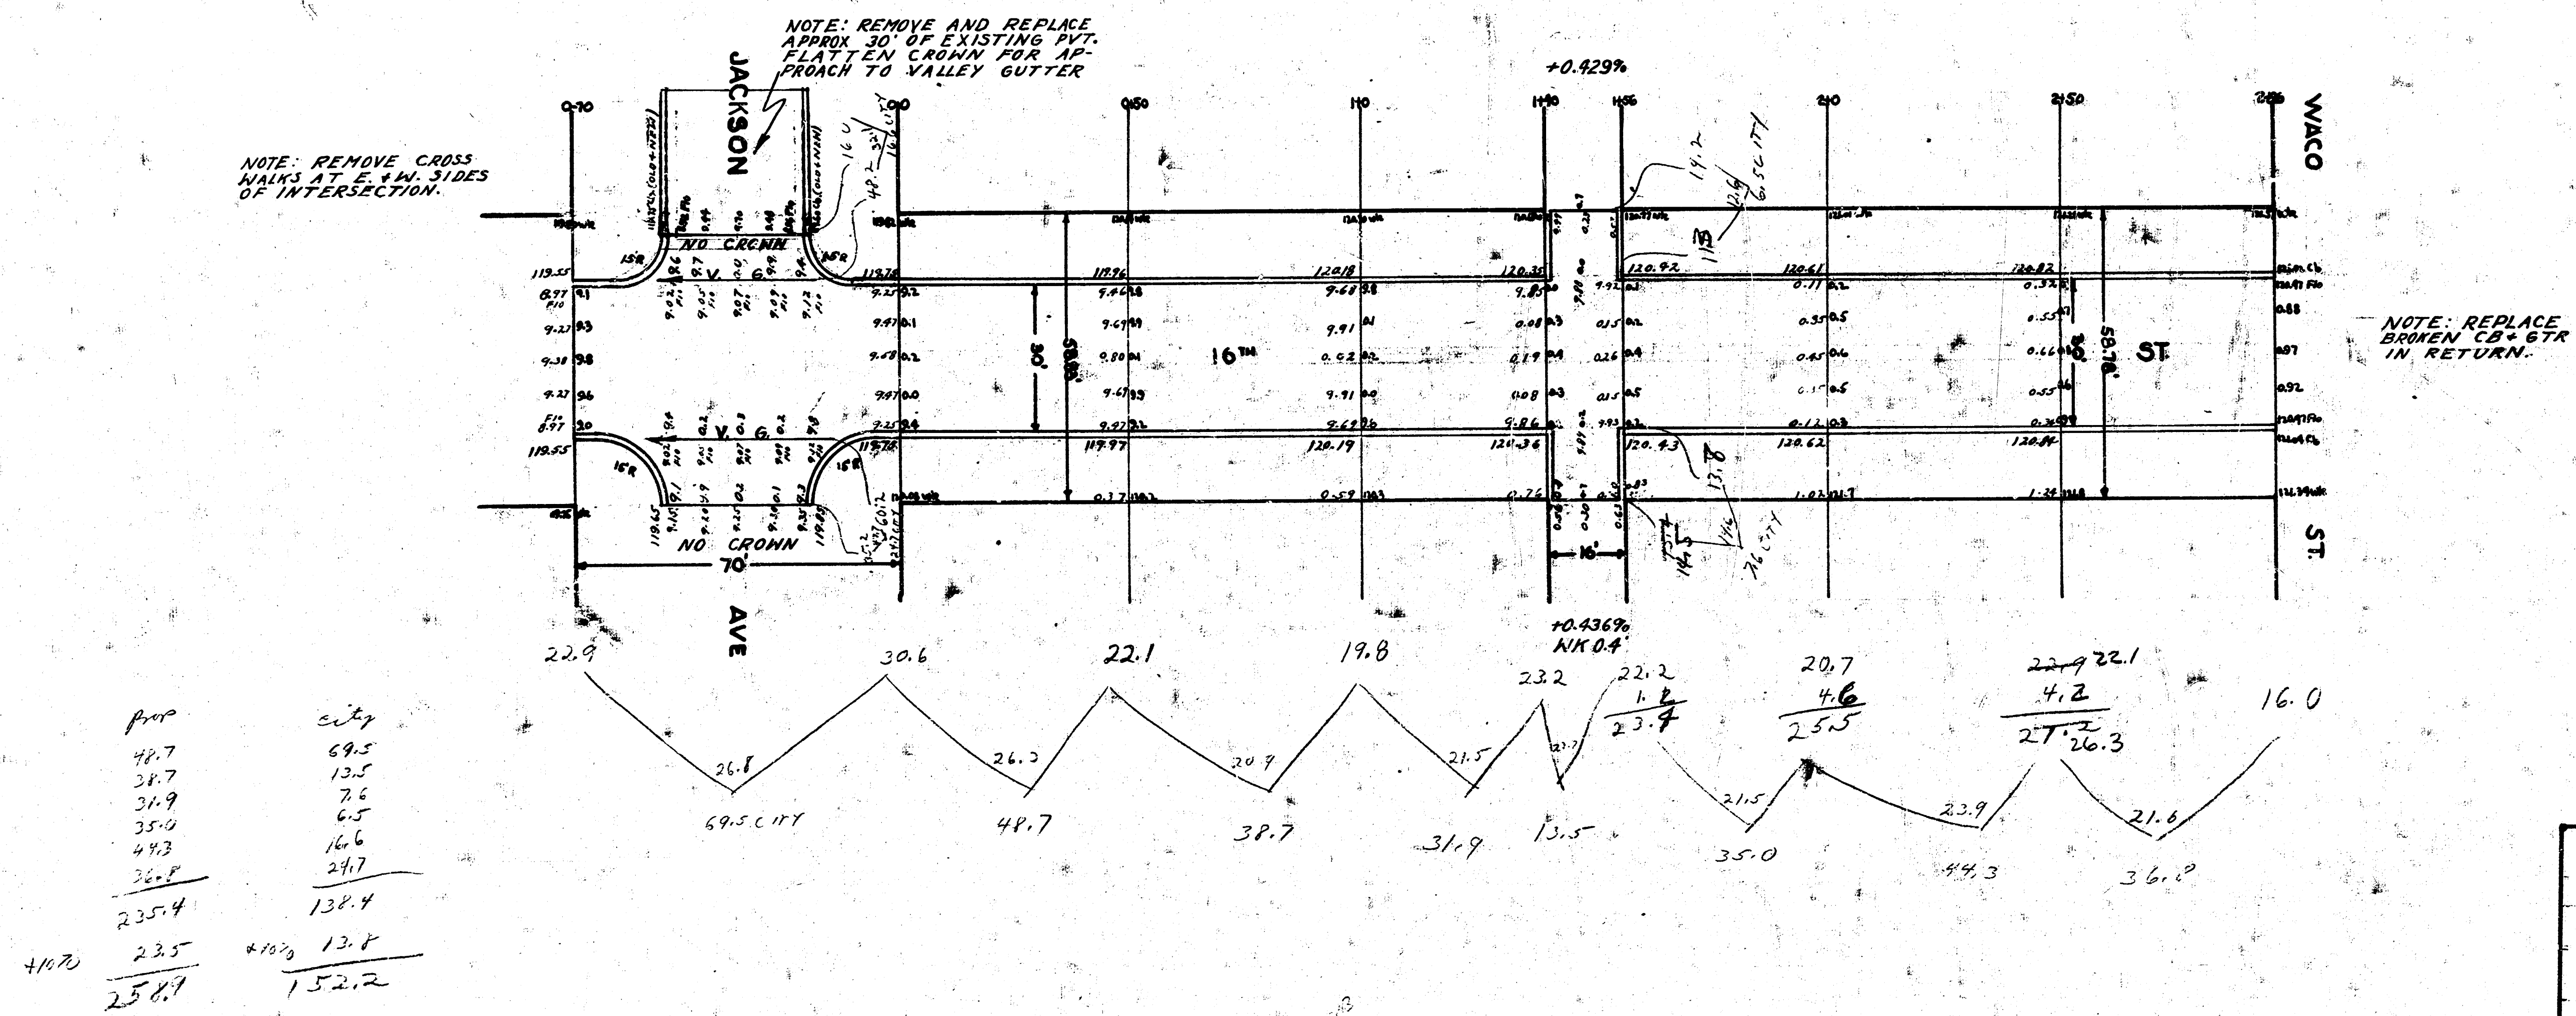

16TH ST. 4-3-36
WEL WACO TO WEL JACKSON
30' CONCRETE & CB.
CITY OF WICHITA, KANSAS
L.K. WHITE CITY ENGINEER
Aug. 1946