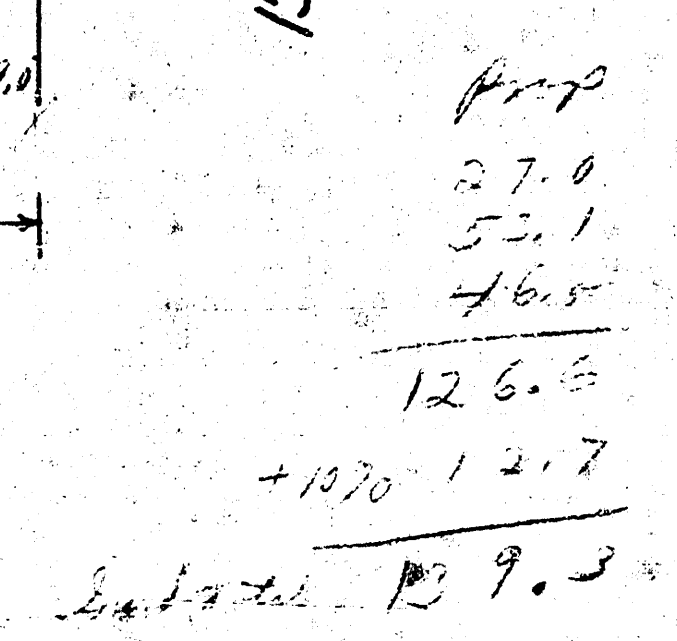


901
902
903


$$\begin{array}{r} 507 \\ 335 \\ \hline 1.72 \\ \hline 50 \end{array}$$