


1941
14TH ST - E. L. WOODLAND W/L. JEANNETTE
26' conc - int cb

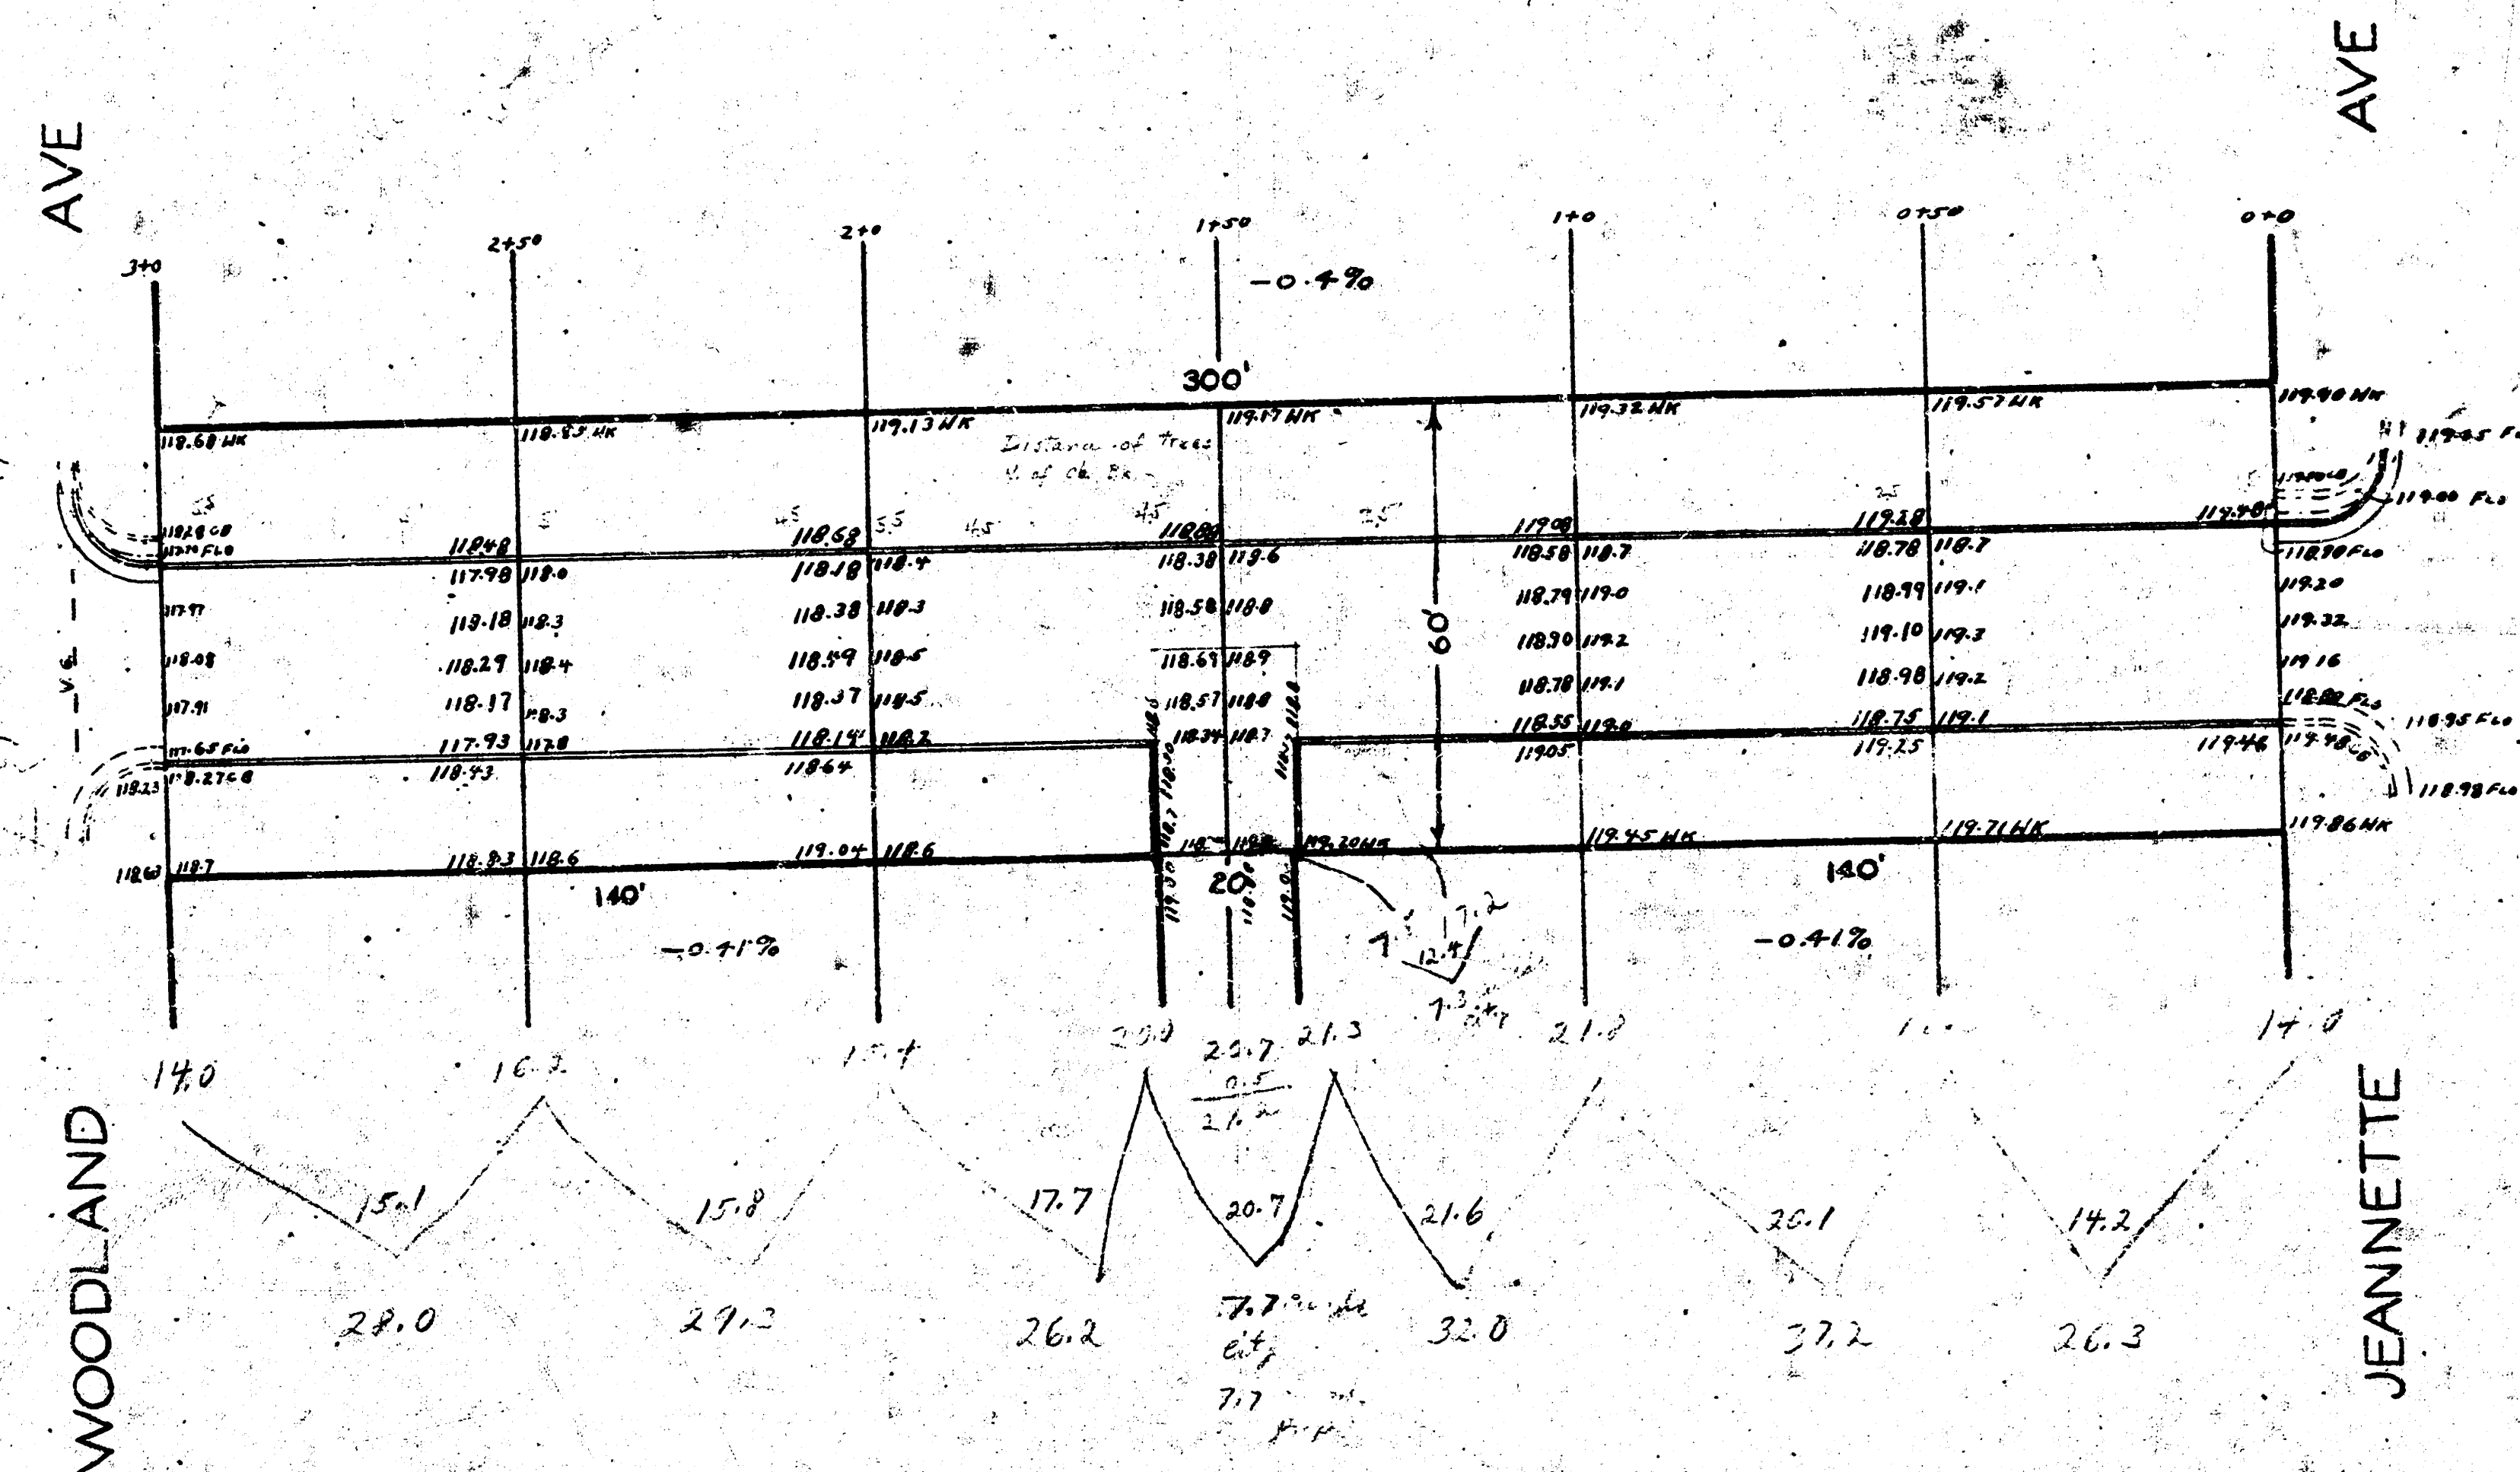

BM 11283 B in Blane ch. W. S. S.W. cor 14th + Jeannette

29.8	7.7
29.3	7.3
26.2	15.0
32.0	1.5
27.4	1.5
26.3	1.5
7.7	16.5
186.7	
18.7	
205.4	

Sub Total → 221.9