14th St. – E.L. Garland to W.L. Payne

26-2-30 Concrete
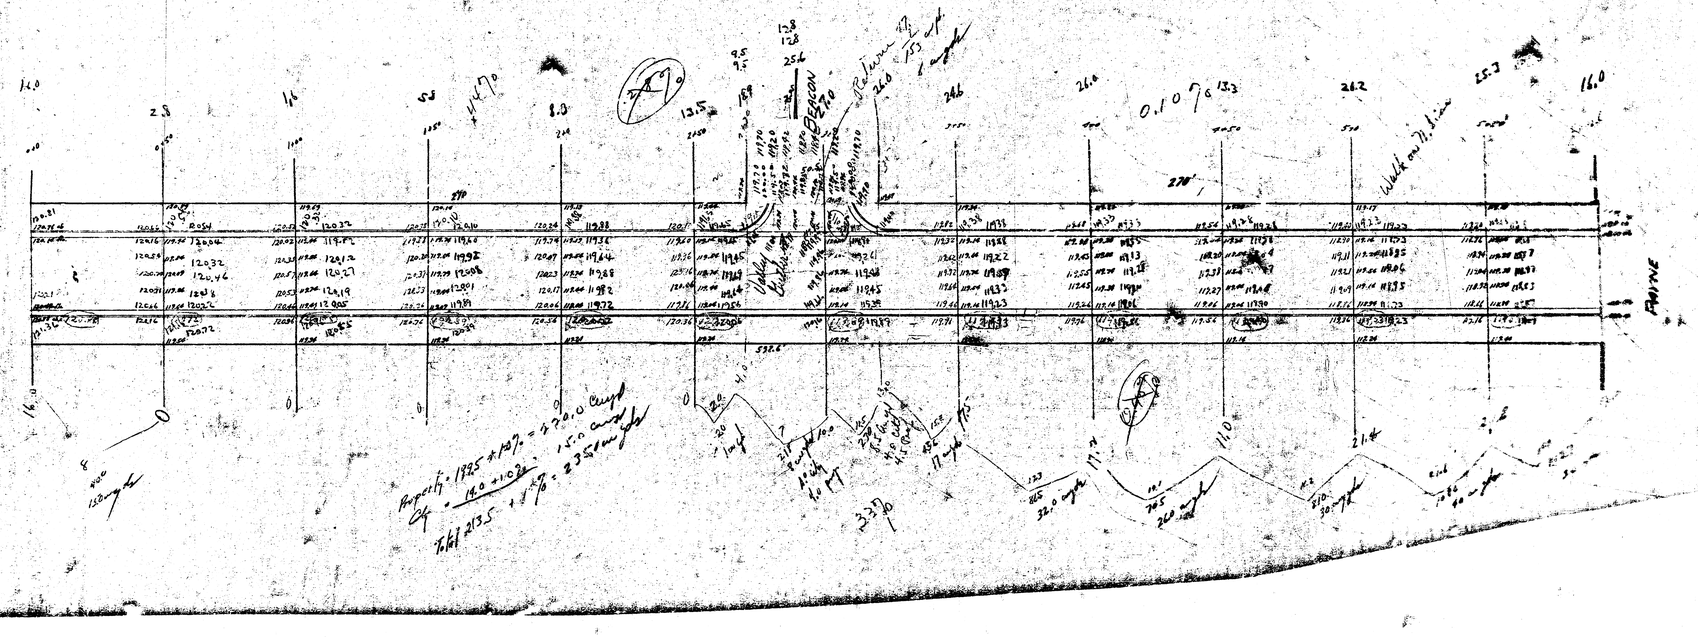
B.M.-117.15 – Int. of walls NW cor. Payne & 14th St.