


B.M. 114.71 "G" in GLOBE, 64.0' N.E. 1/4, N.M. cor. Kansas & 12th.
 B.M. 115.10 "G" in GLOBE, N. 1/4, 12th, N.E. Minneapolis.
NOTE TO FIELD ENGINEER:
 All entrance pipes are to be disposed as
 per directions of the City Dirt Checker.

NOTE:
 V.G. TO BE 10' WIDE & BUILT
 FLAT THROUGHT THIS WIDTH.

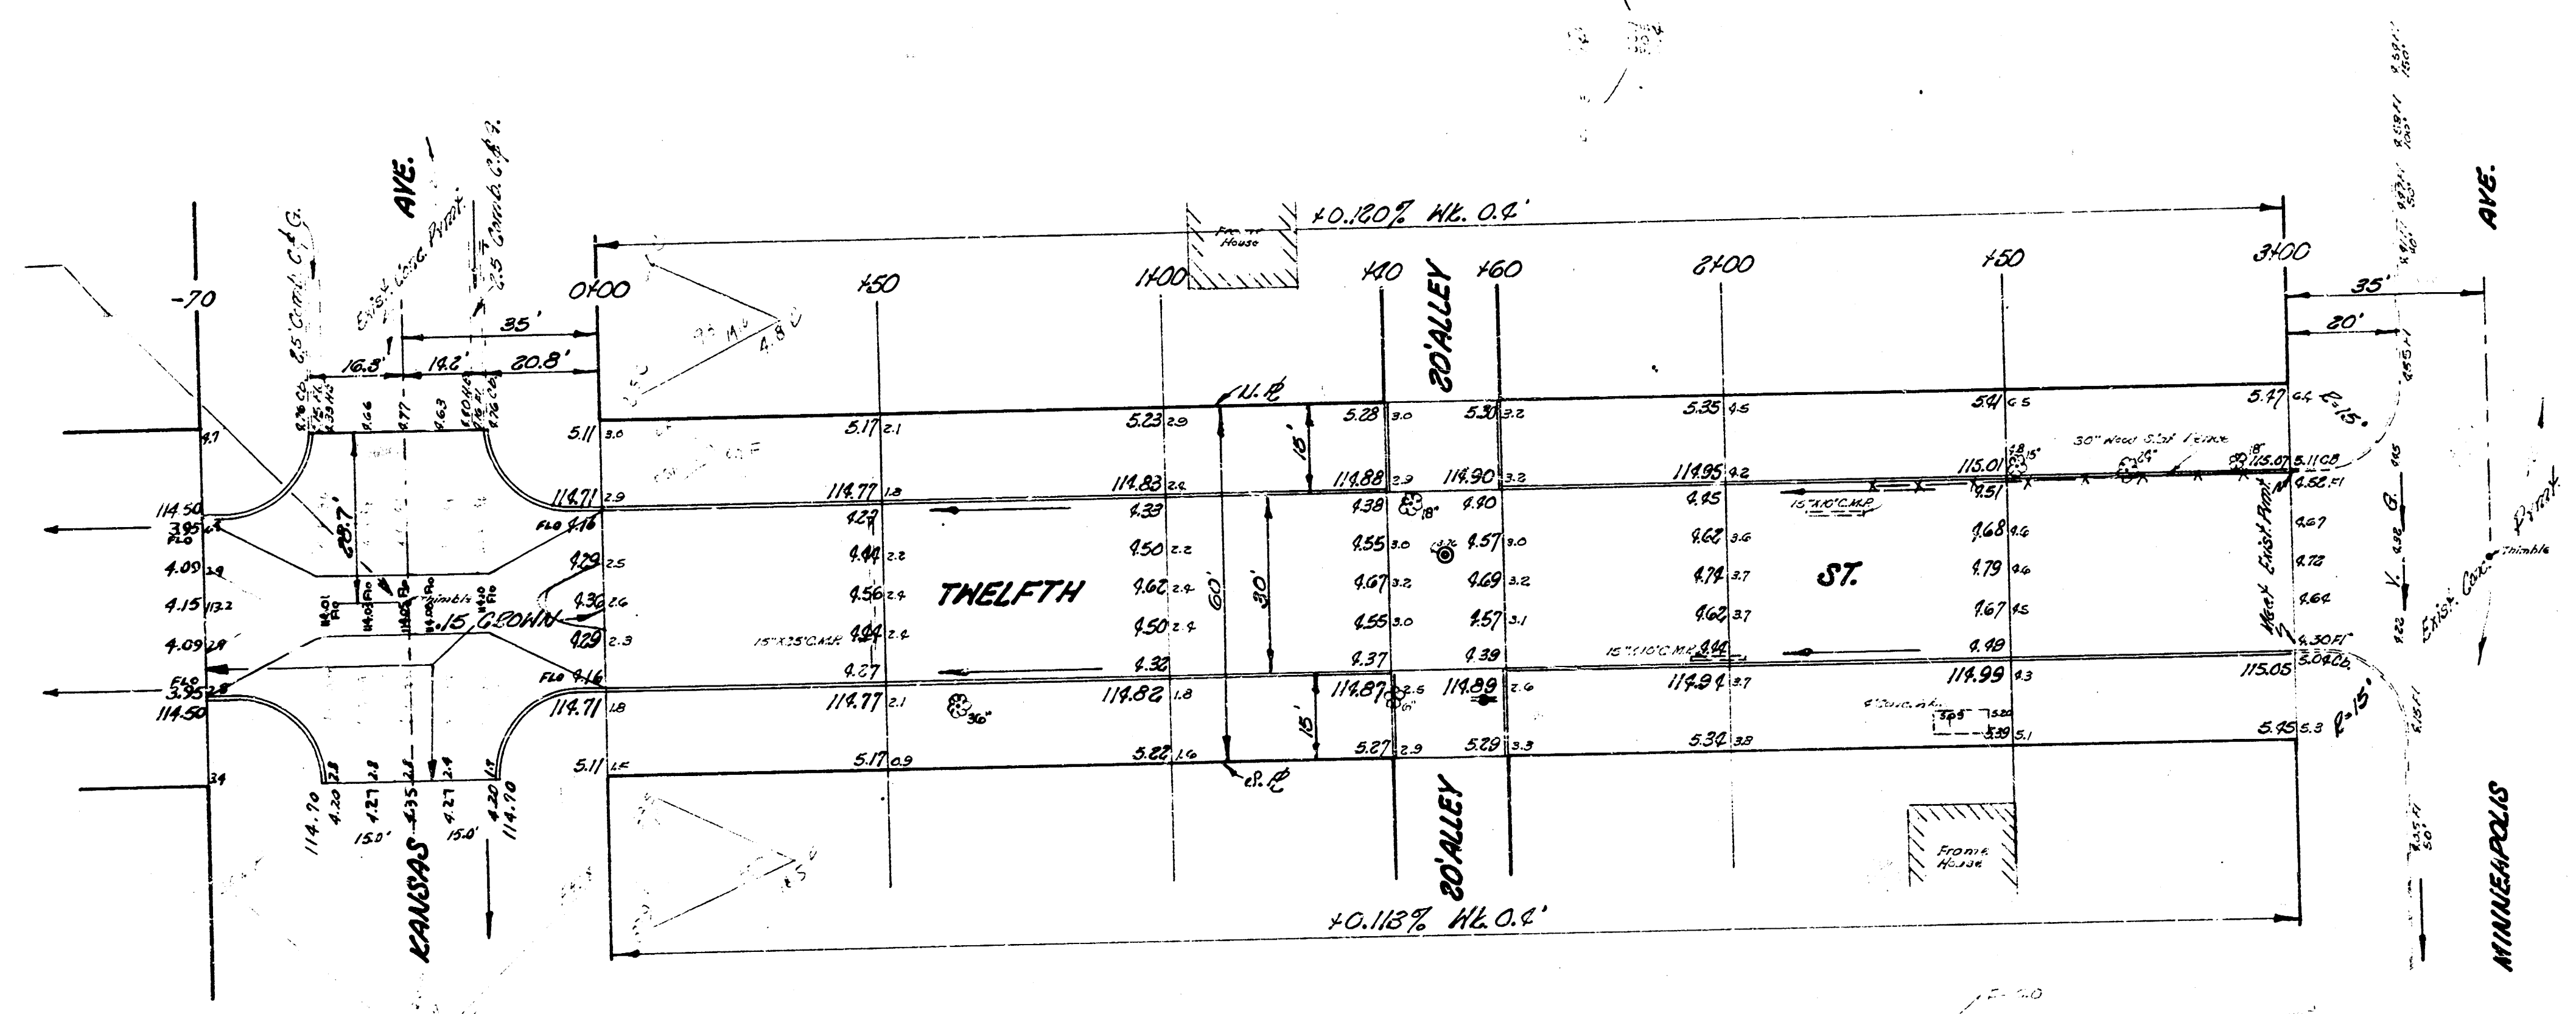


Survey 11/19/08
 E.L. Kansas Ave.
 E.L. Minneapolis Ave.
 E.L. Thelth St.
 E.L. 12th St.

INTERSECTION OF 12TH & KANSAS
 Proj. No. C14-252
THELTH STREET
 E.L. KANSAS AVE. & N.E. MINNEAPOLIS AVE.
 30' WIDE & C.B.
CITY OF NICHITA, KANSAS
 B.E. SMITH
 Aug. 1954
 CITY ENGINEER
 Proj. No. C14-252

B.M. 114.71 8" in GLOBE, bt. of W. 1/4, N. 1/4, cor. Kansas & 12th.
 B.M. 115.10 8" in GLOBE, N. cor. 12th & W. Minneapolis.
 NOTE TO FIELD ENGINEER:
 All entrance pipes are to be disposed as
 per directions of the City Dirt Checker.

NOTE:
 V.G. TO BE 10' WIDE & BUILT
 FLAT THRUOUT THIS WIDTH.

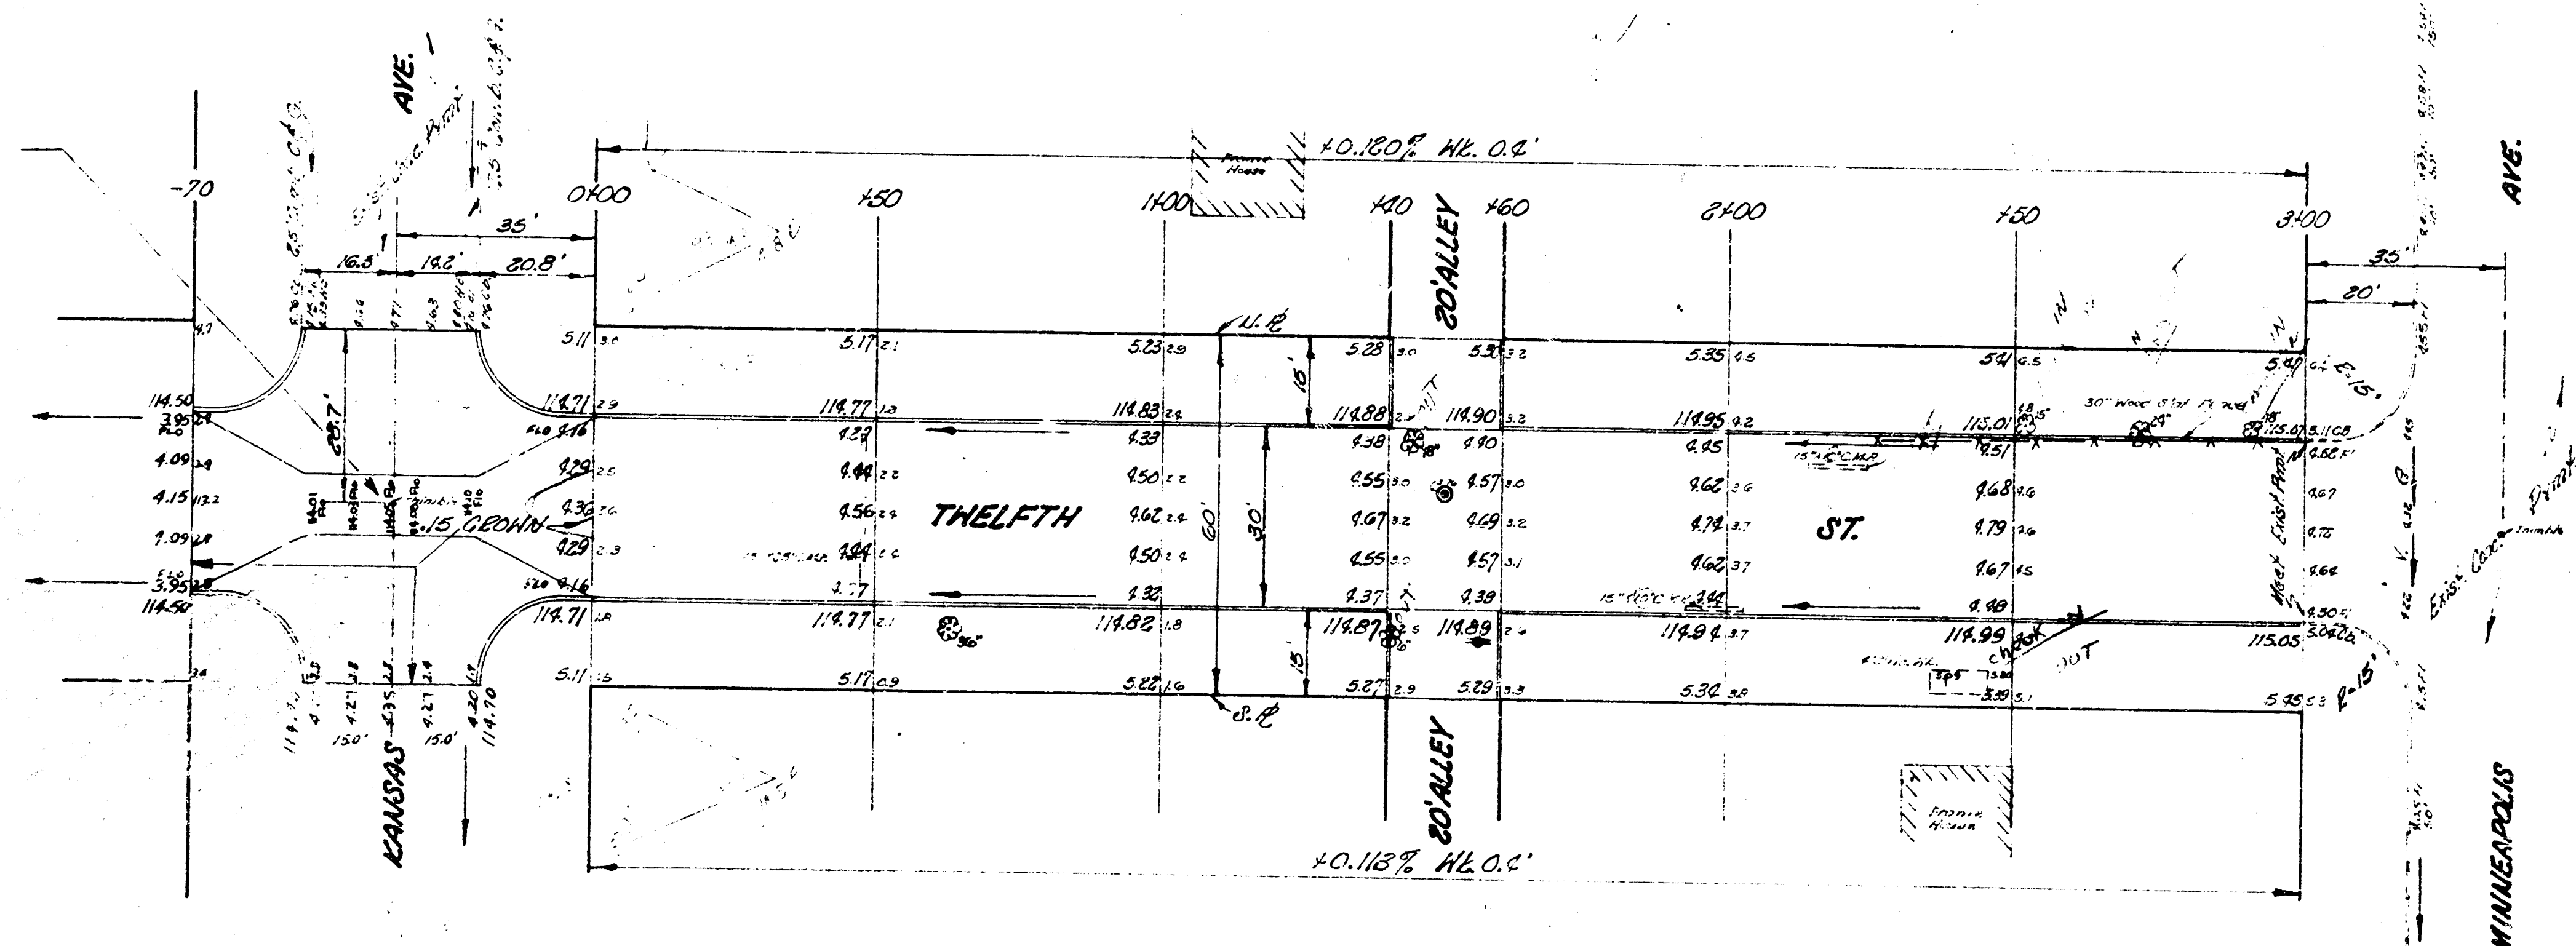

See - no original

INTERSECTION OF 12TH & KANSAS
 PROJ. NO. C14-252
THELFTH STREET
 S.W. KANSAS AVE. & W. MINNEAPOLIS AVE.
 30' ROAD & CO.
 CITY OF WICHITA, KANSAS
 B.E. SMITH
 AUG. 1954
 CITY ENGINEER
 PROJ. NO. C14-252