


Survey  
 1/18/06  
 2/18/06  
 City Engineer

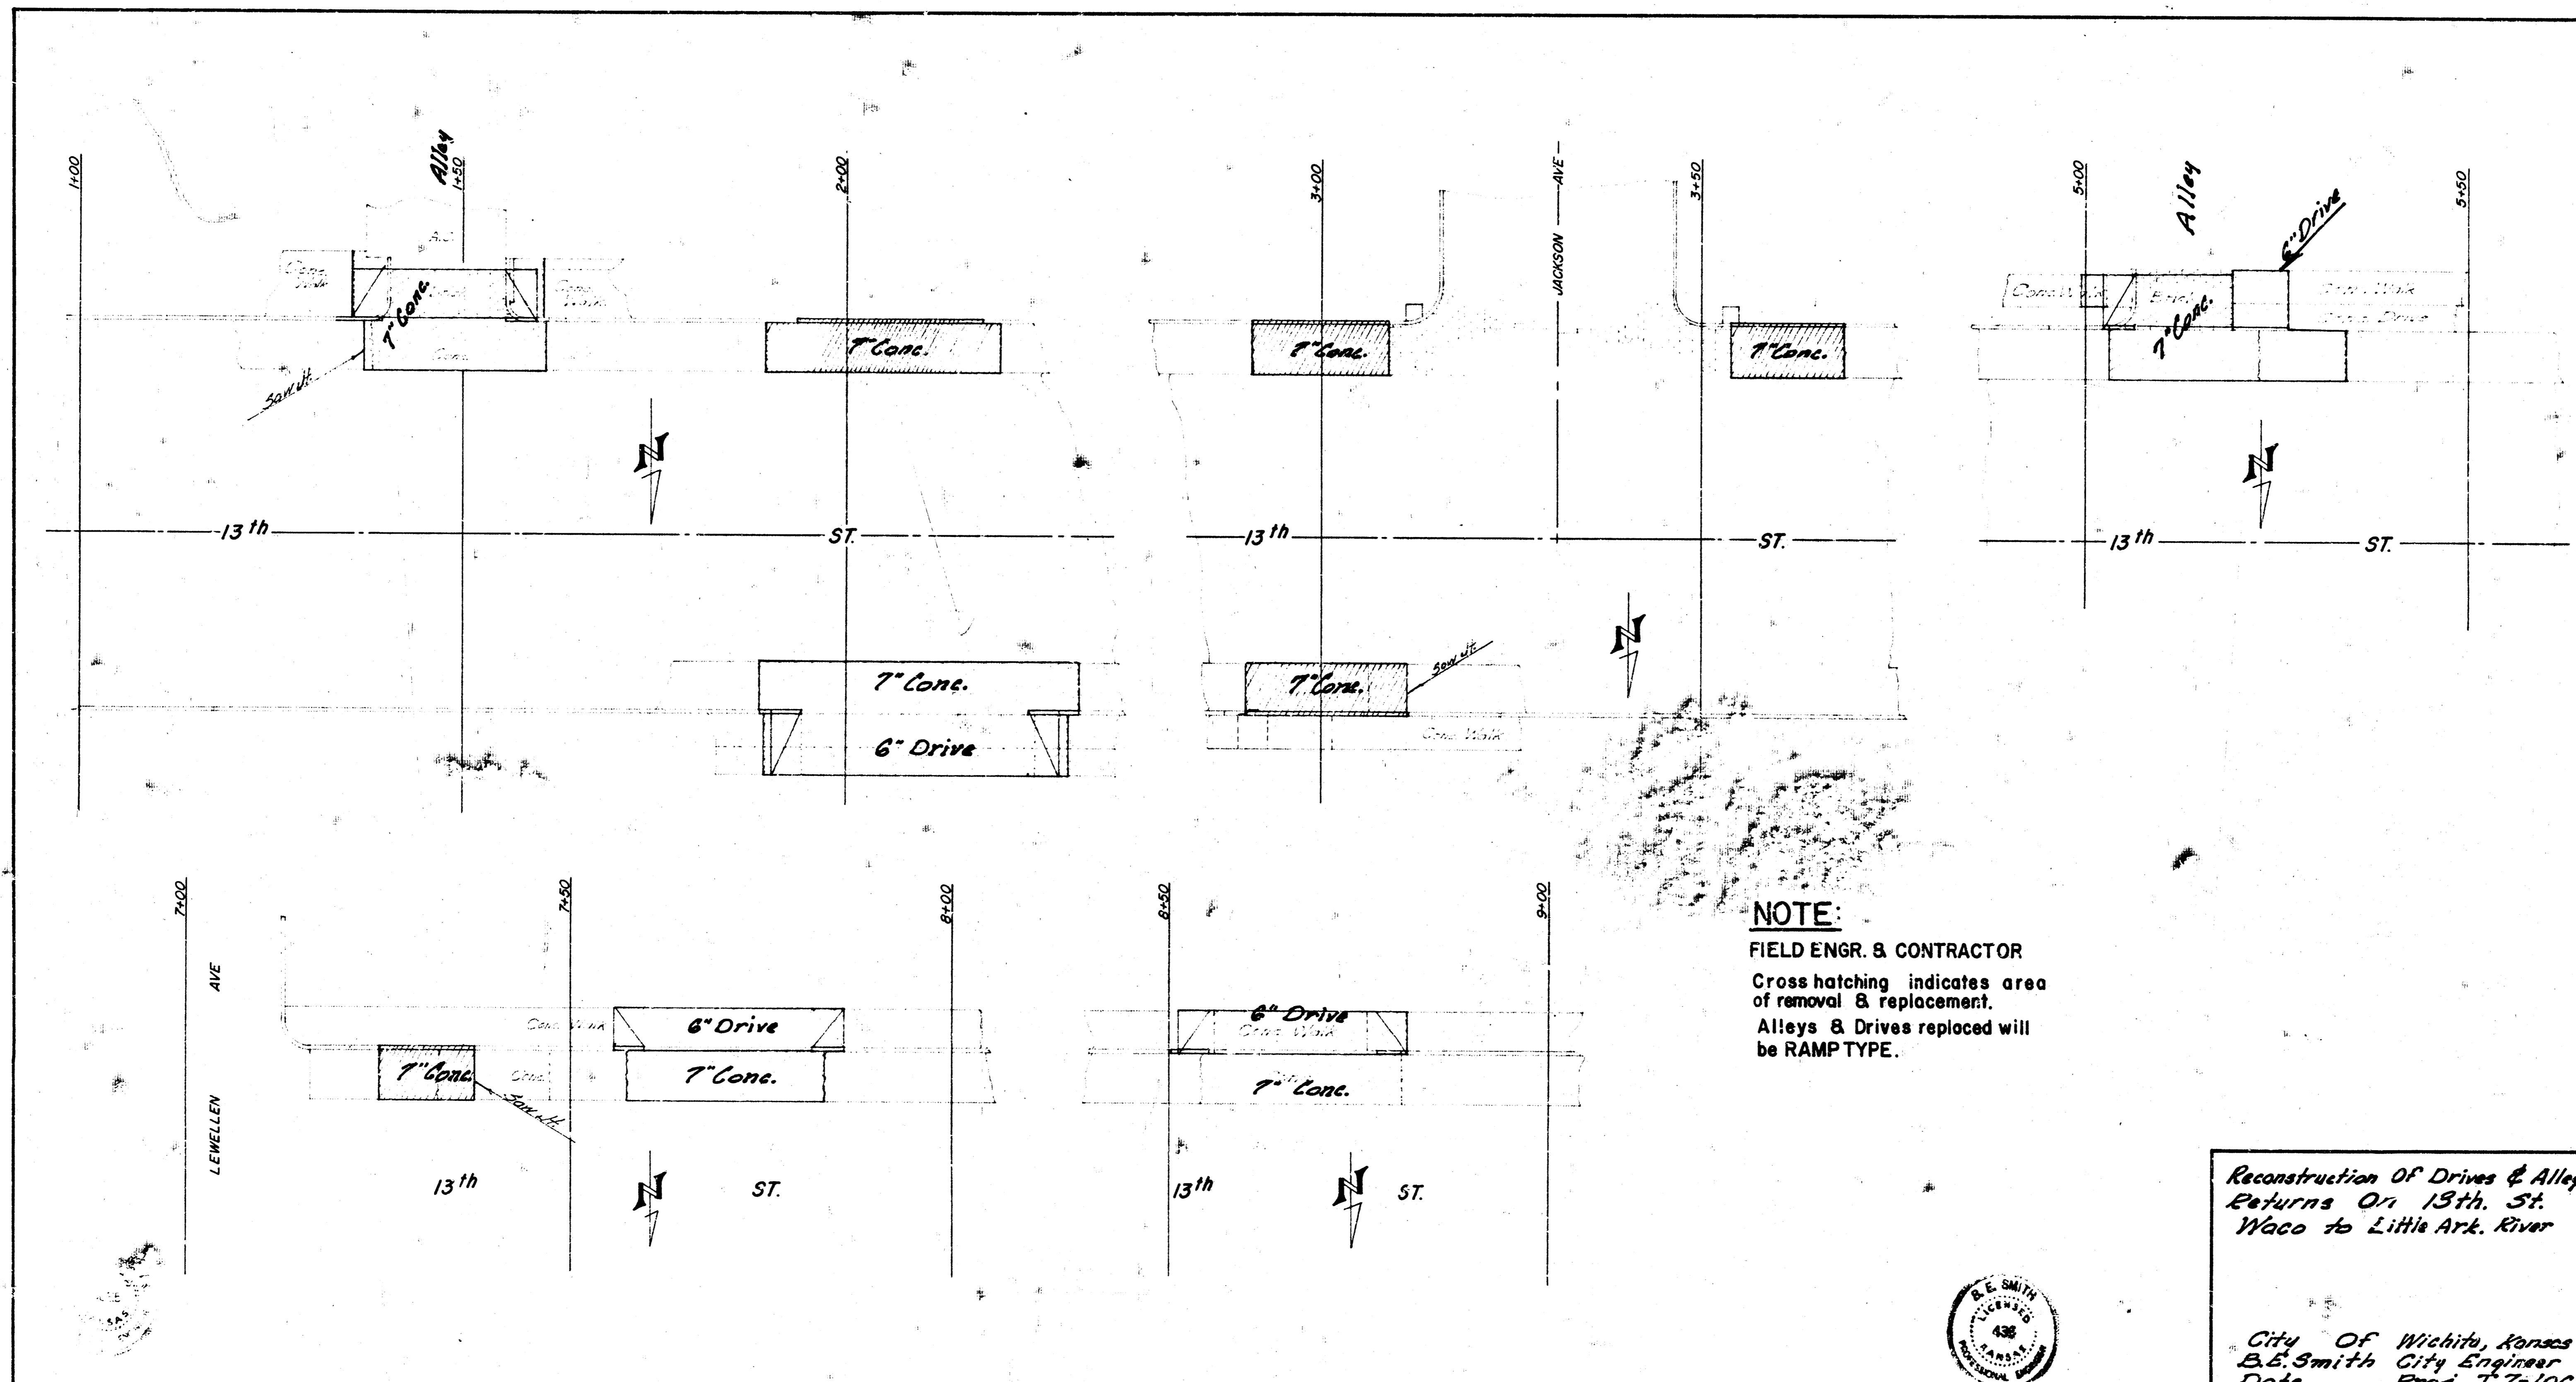


**NOTE:**  
 FIELD ENGR. & CONTRACTOR  
 Cross hatching indicates area  
 of removal & replacement.  
 Alleys & Drives replaced will  
 be RAMPTYPE.

Reconstruction of Drives & Alley  
 Returns On 13th St.  
 Waco to Little Ark. River



City Of Wichita, Kansas  
 B.E. Smith City Engineer  

Survey J.A. BURNS  
 Plan 27608  

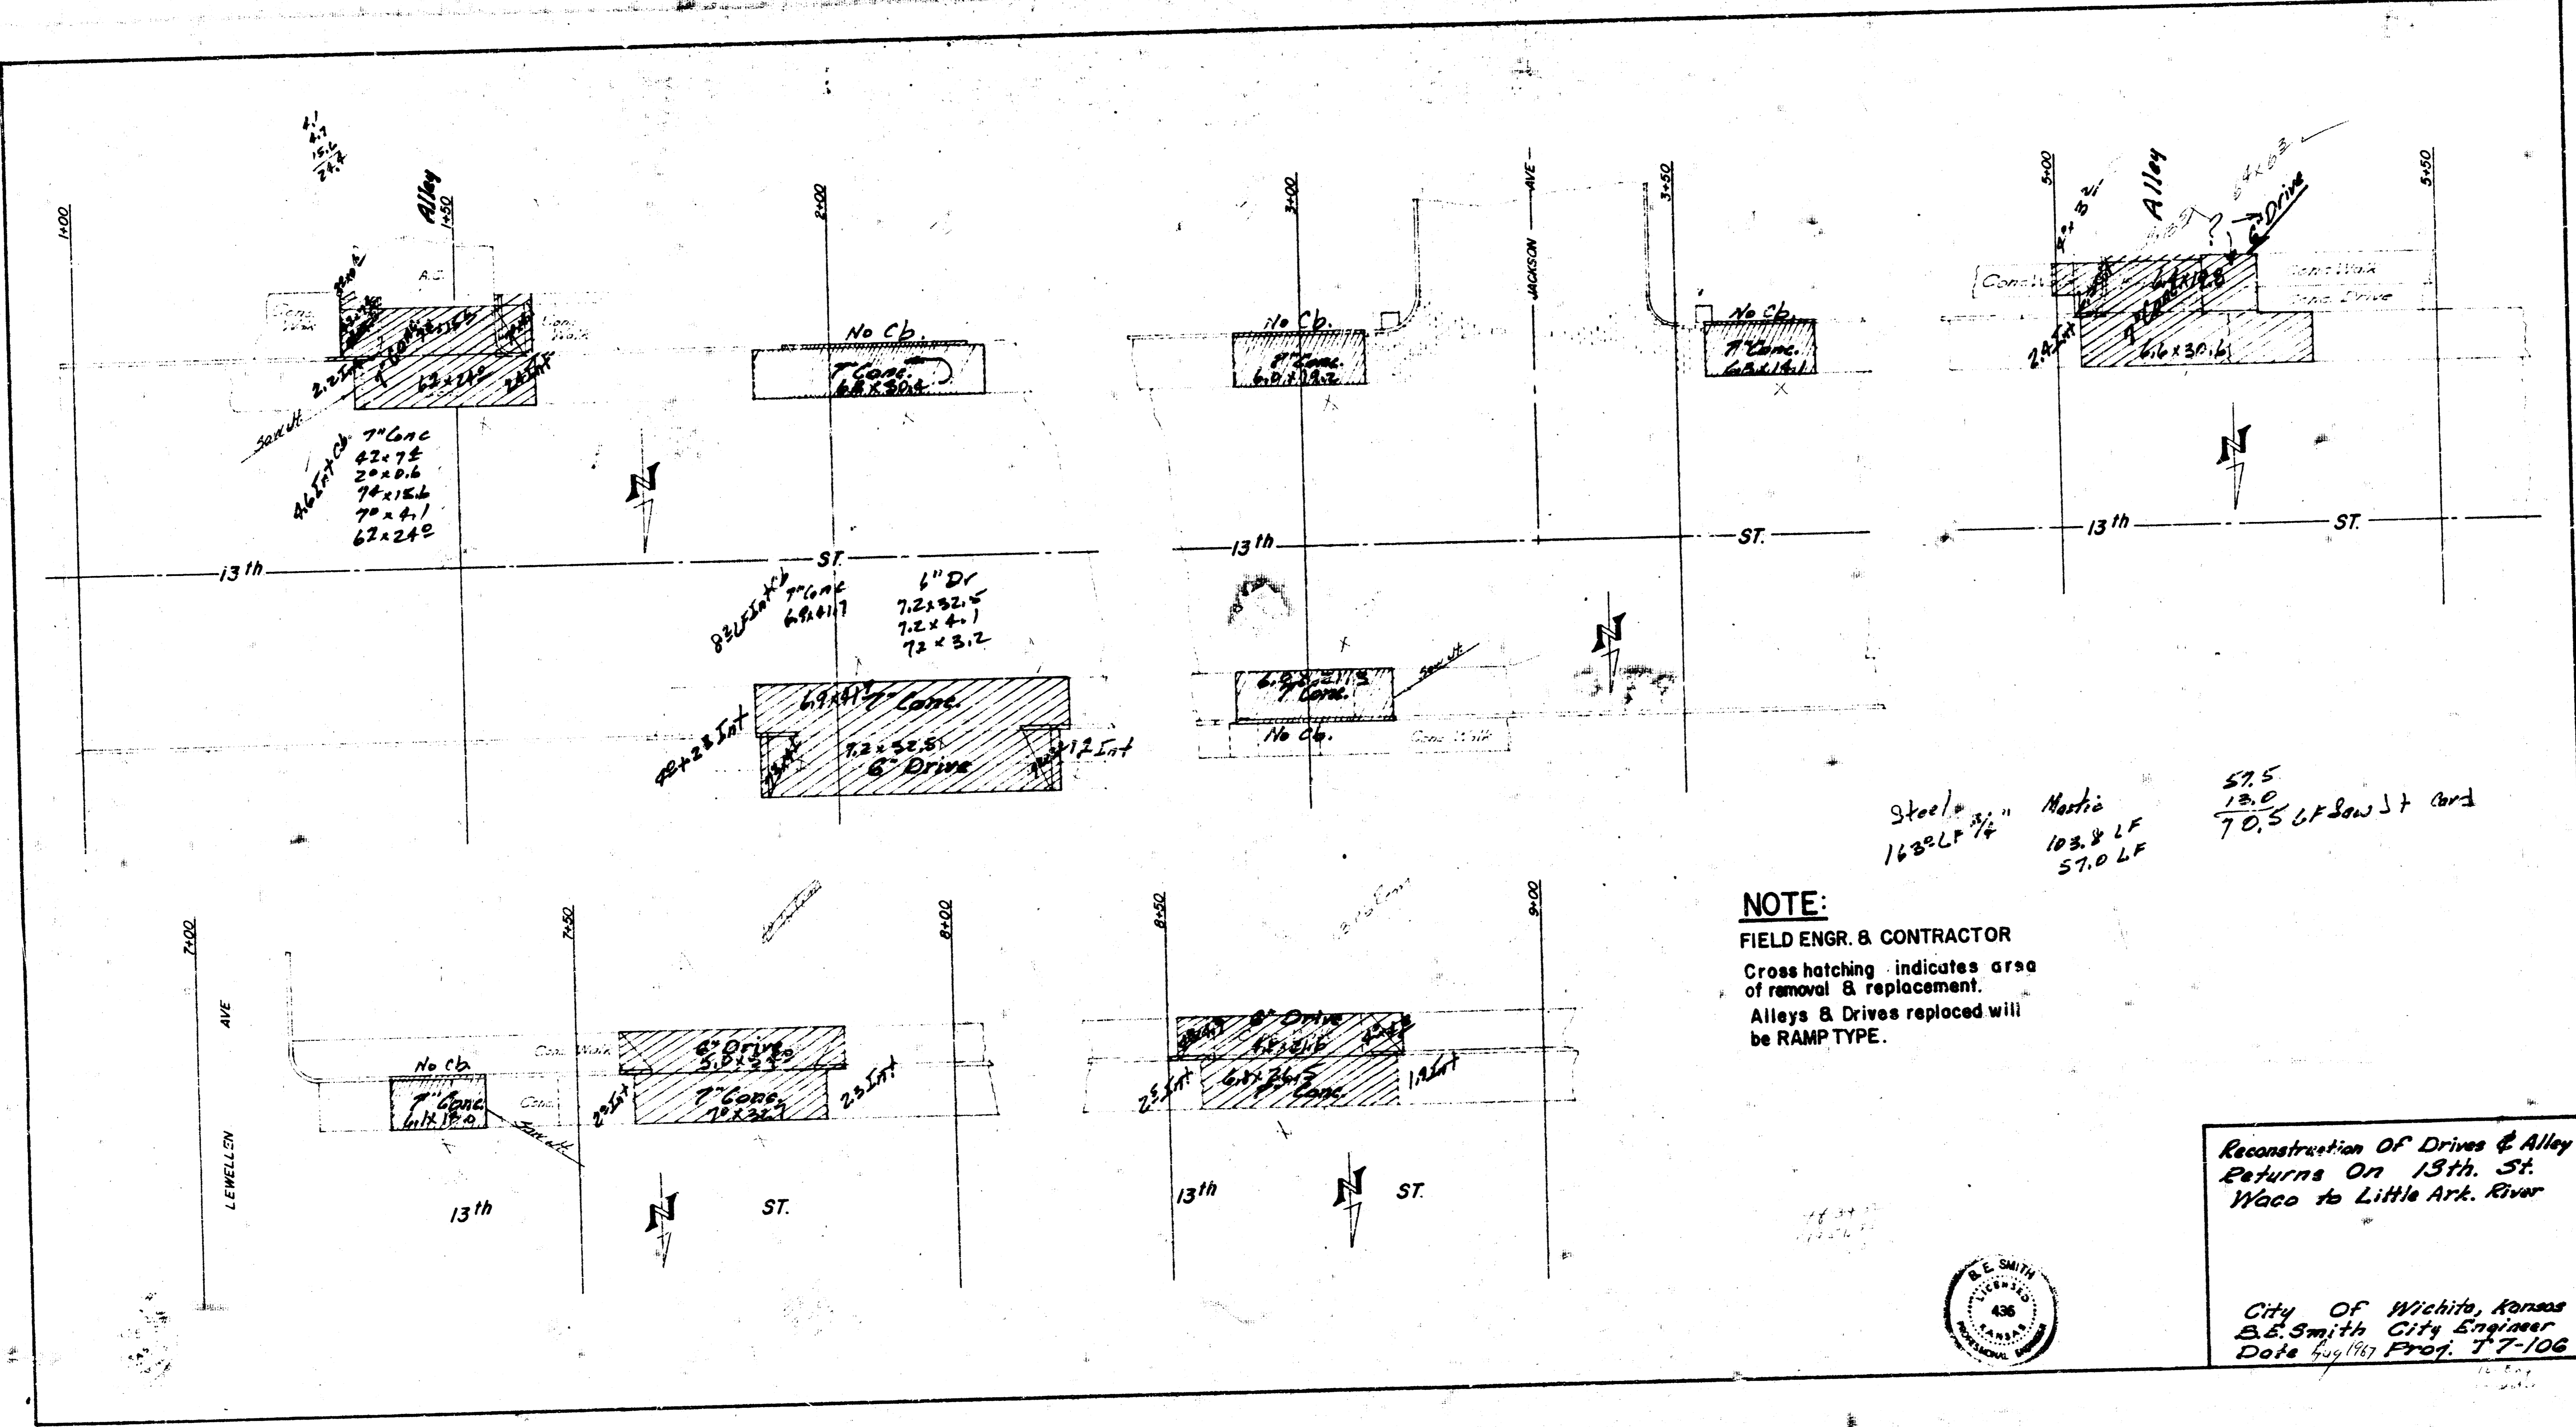

Steel # 3/4"    Maxia  
 163' LF 1/4"    103.8 LF  
 57.5    70.5 LF Saw St Card

**NOTE:**  
 FIELD ENGR. & CONTRACTOR  
 Cross hatching indicates area  
 of removal & replacement.  
 Alleys & Drives replaced will  
 be RAMP TYPE.

Reconstruction of Drives & Alley  
 Returns On 13th St  
 Waco to Little Ark. River

City of Wichita, Kansas  
 E. S. Smith City Engineer  
 Date 4/24/67 Proj. T-7-106

