



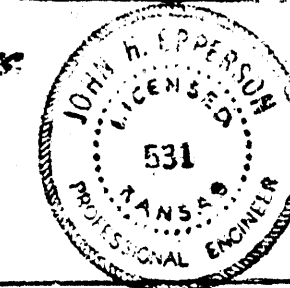
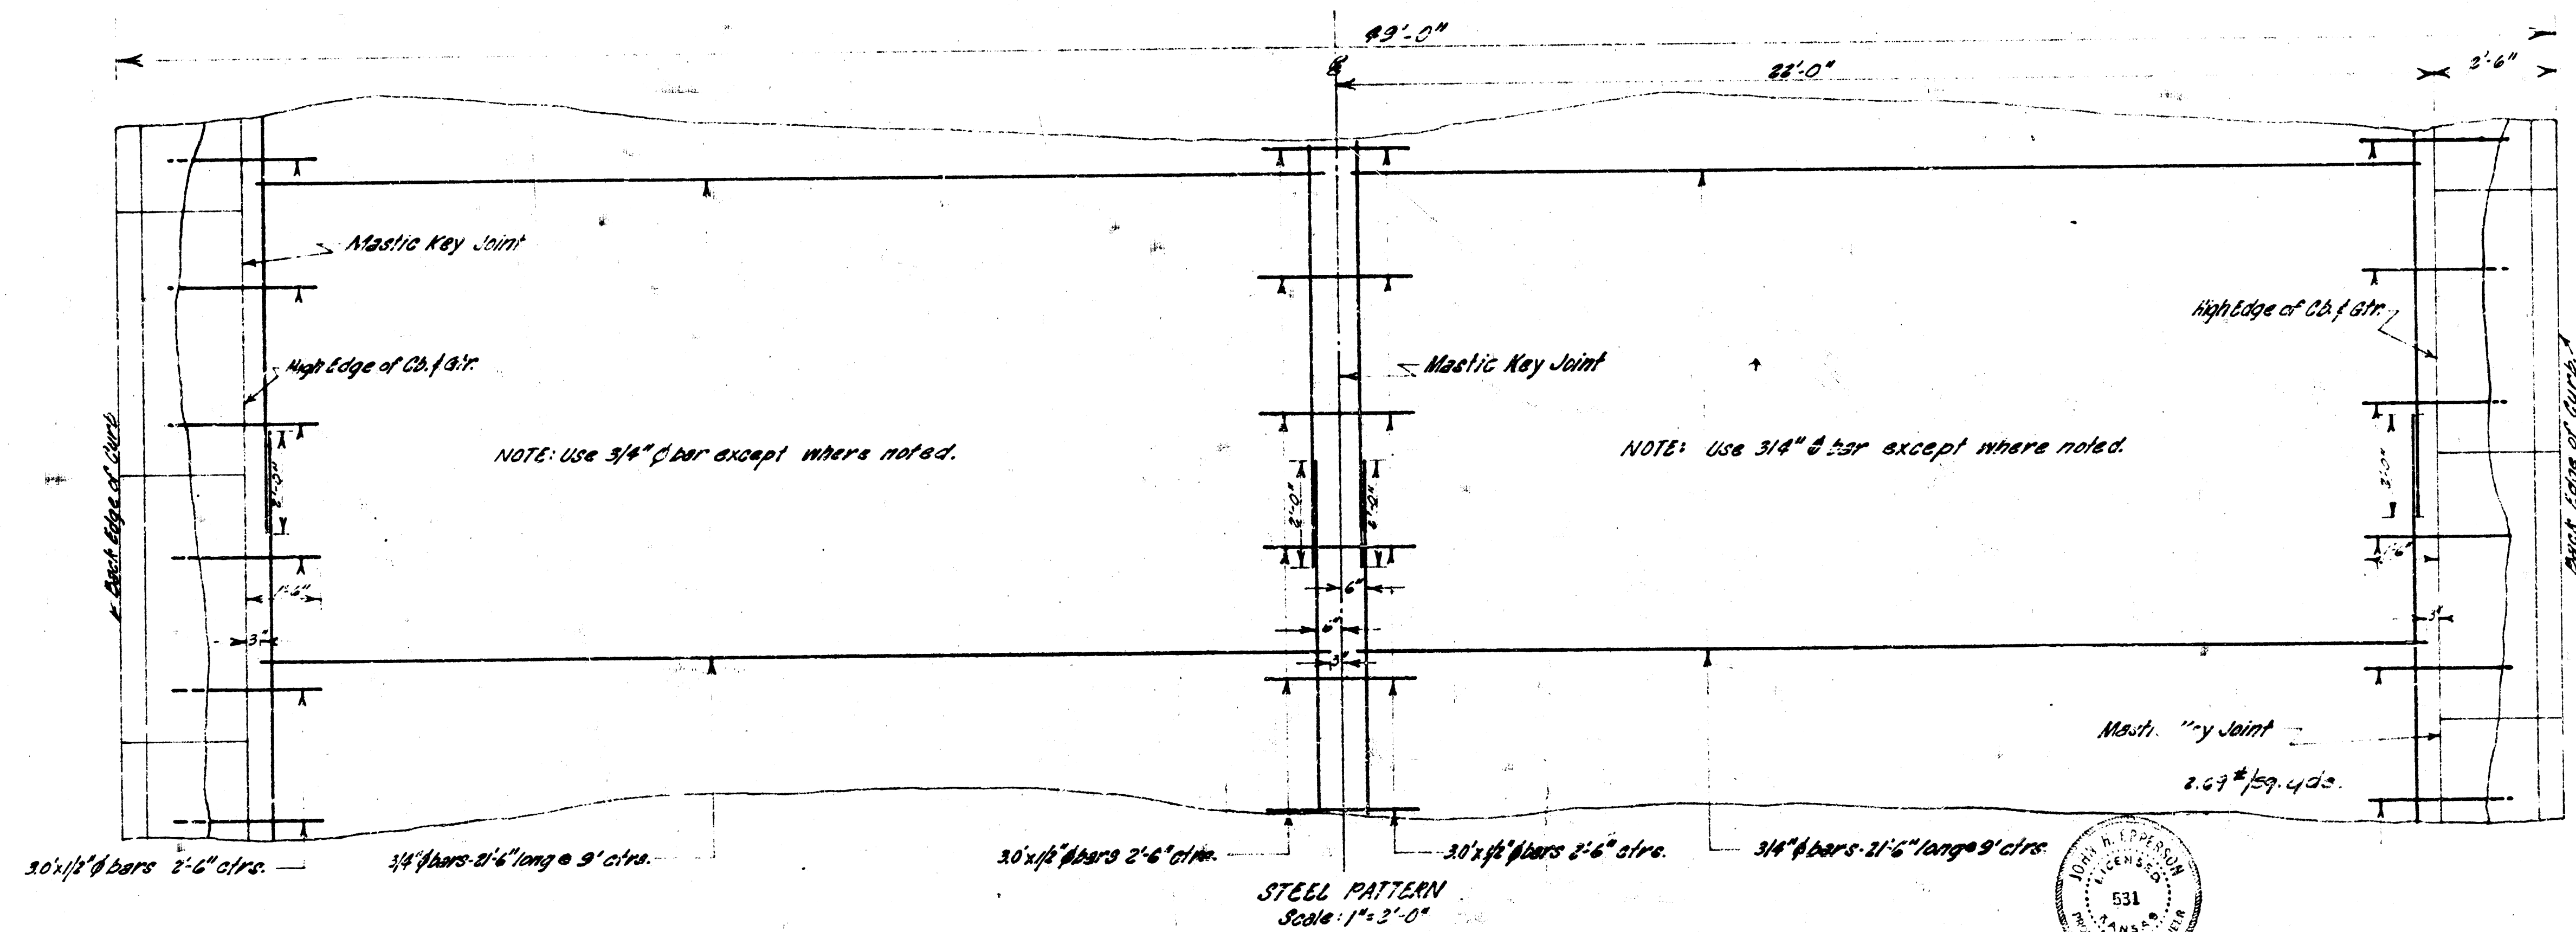


THIRTEENTH STREET
W.L. PARKWOOD LANE TO W.L. WOODLAWN AVENUE
PROJECT NO. C11-37

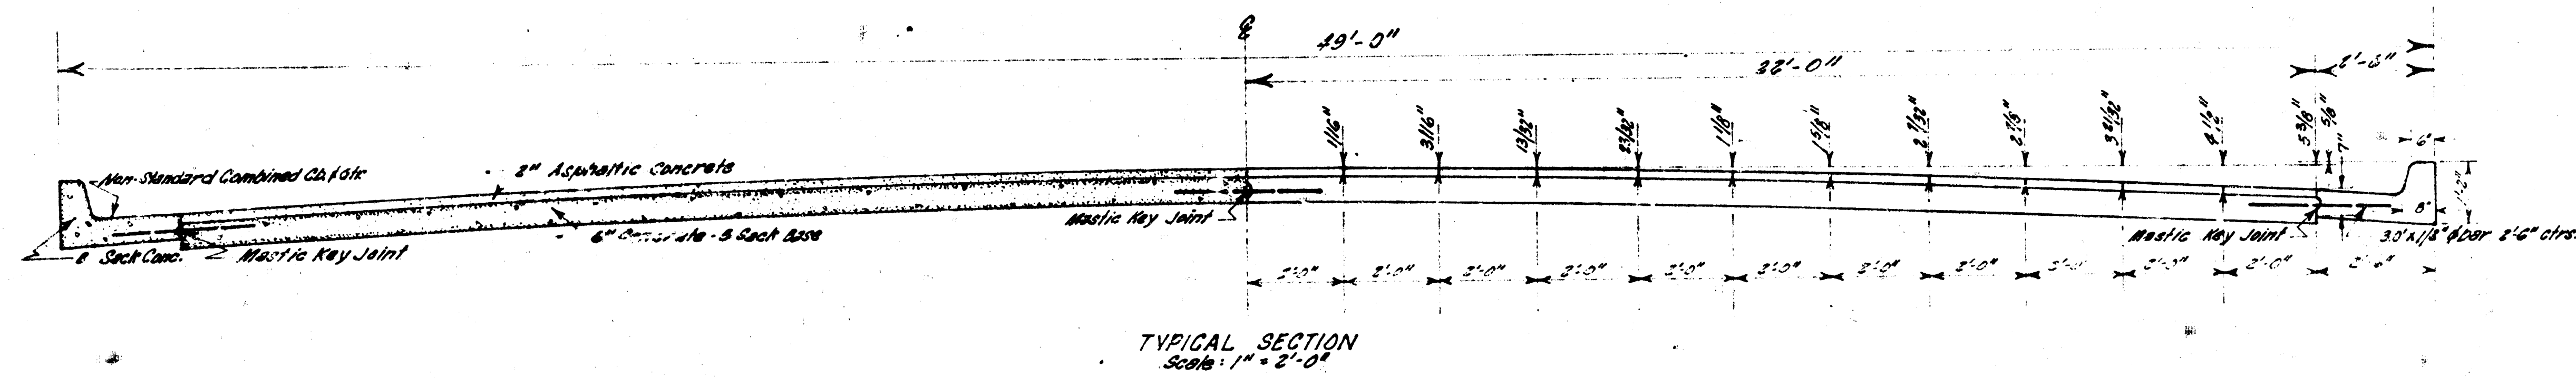

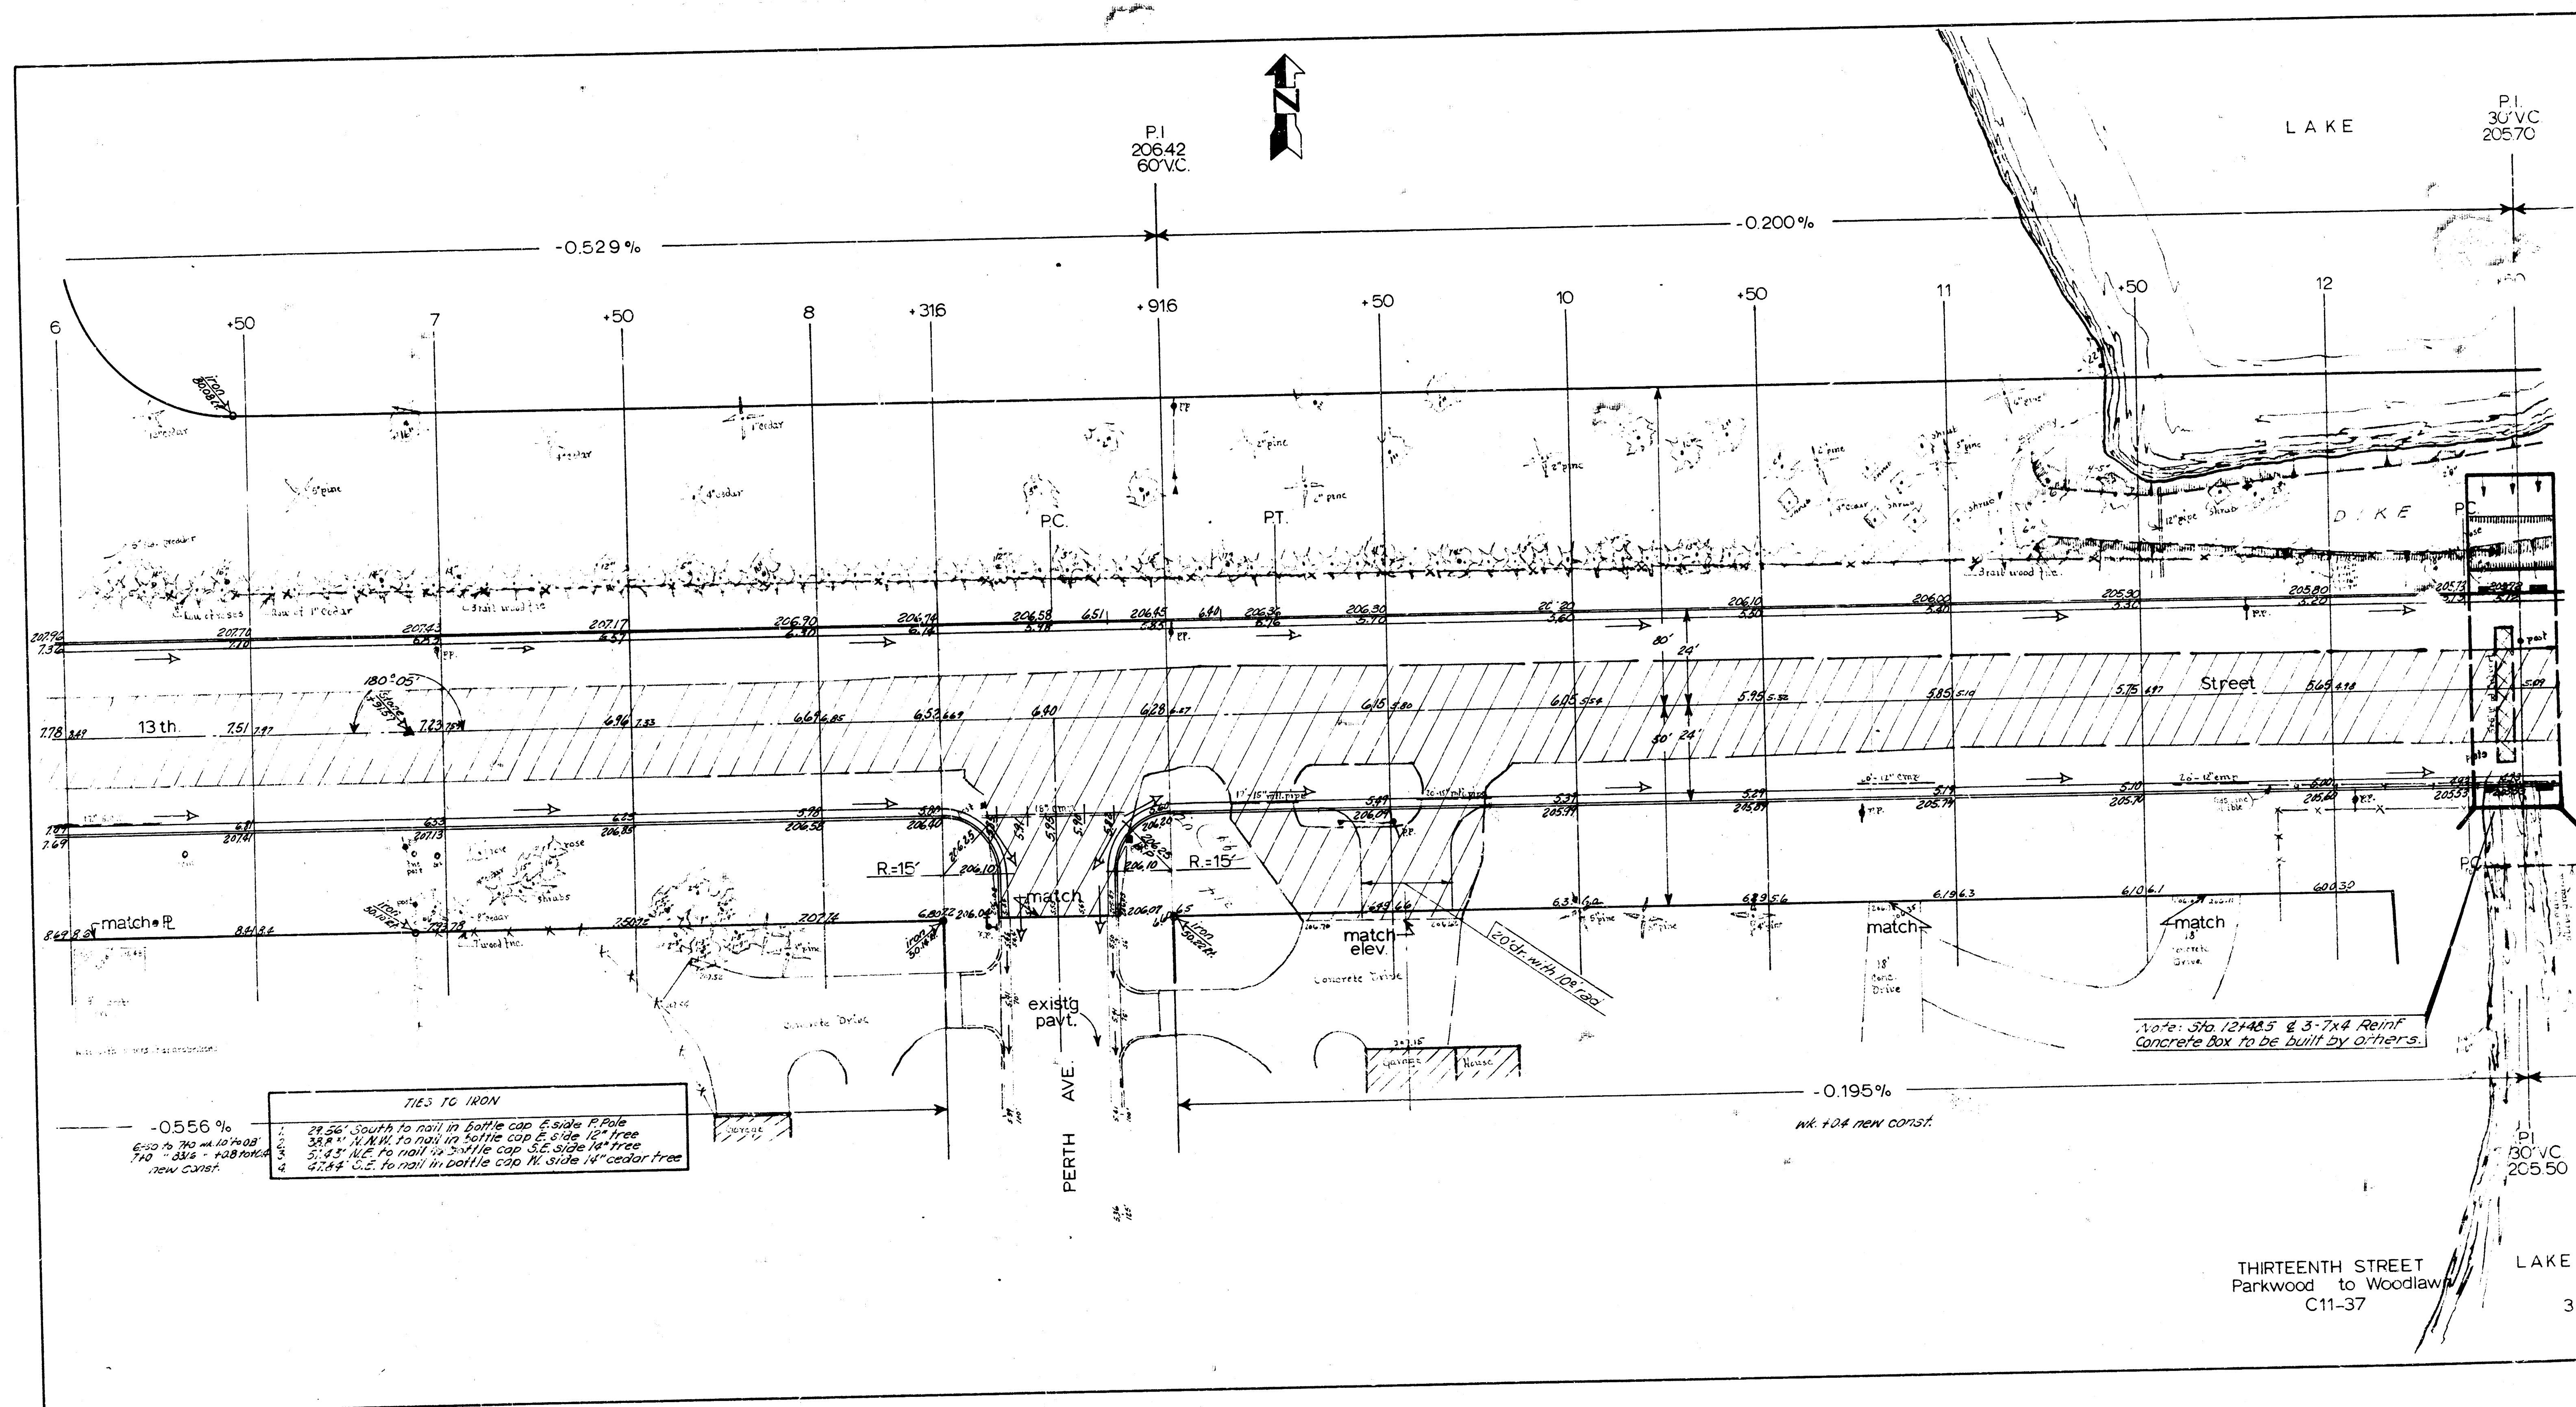

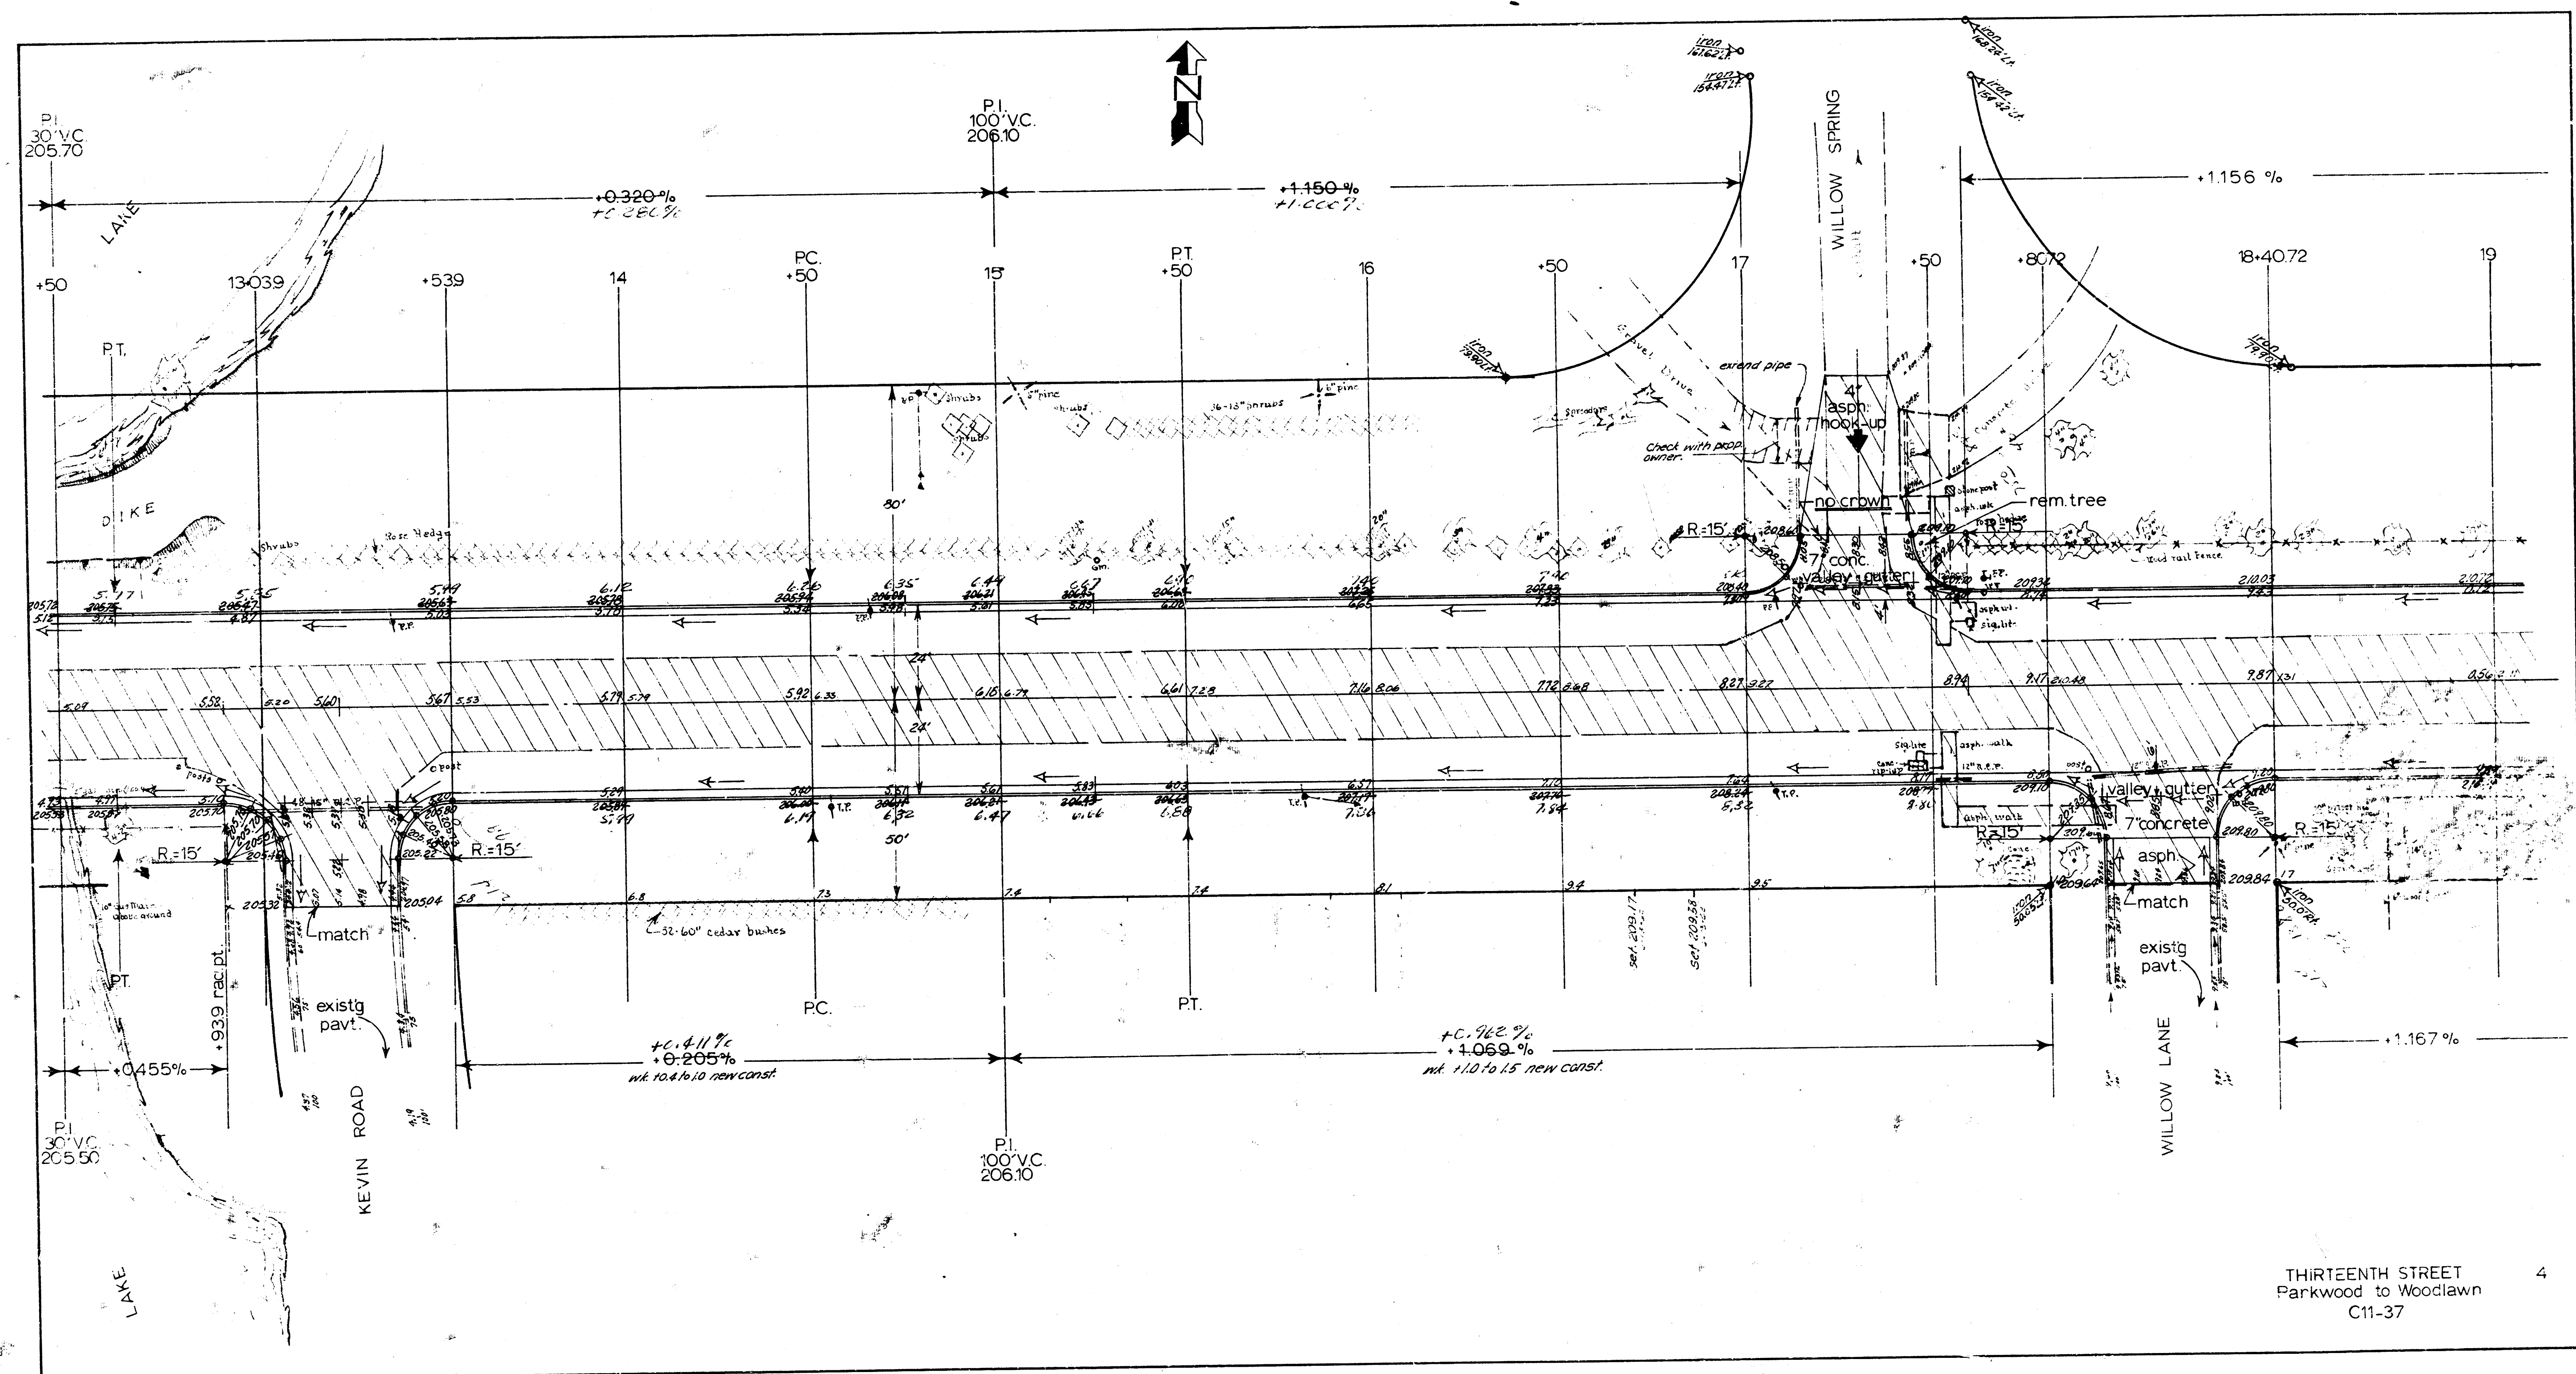

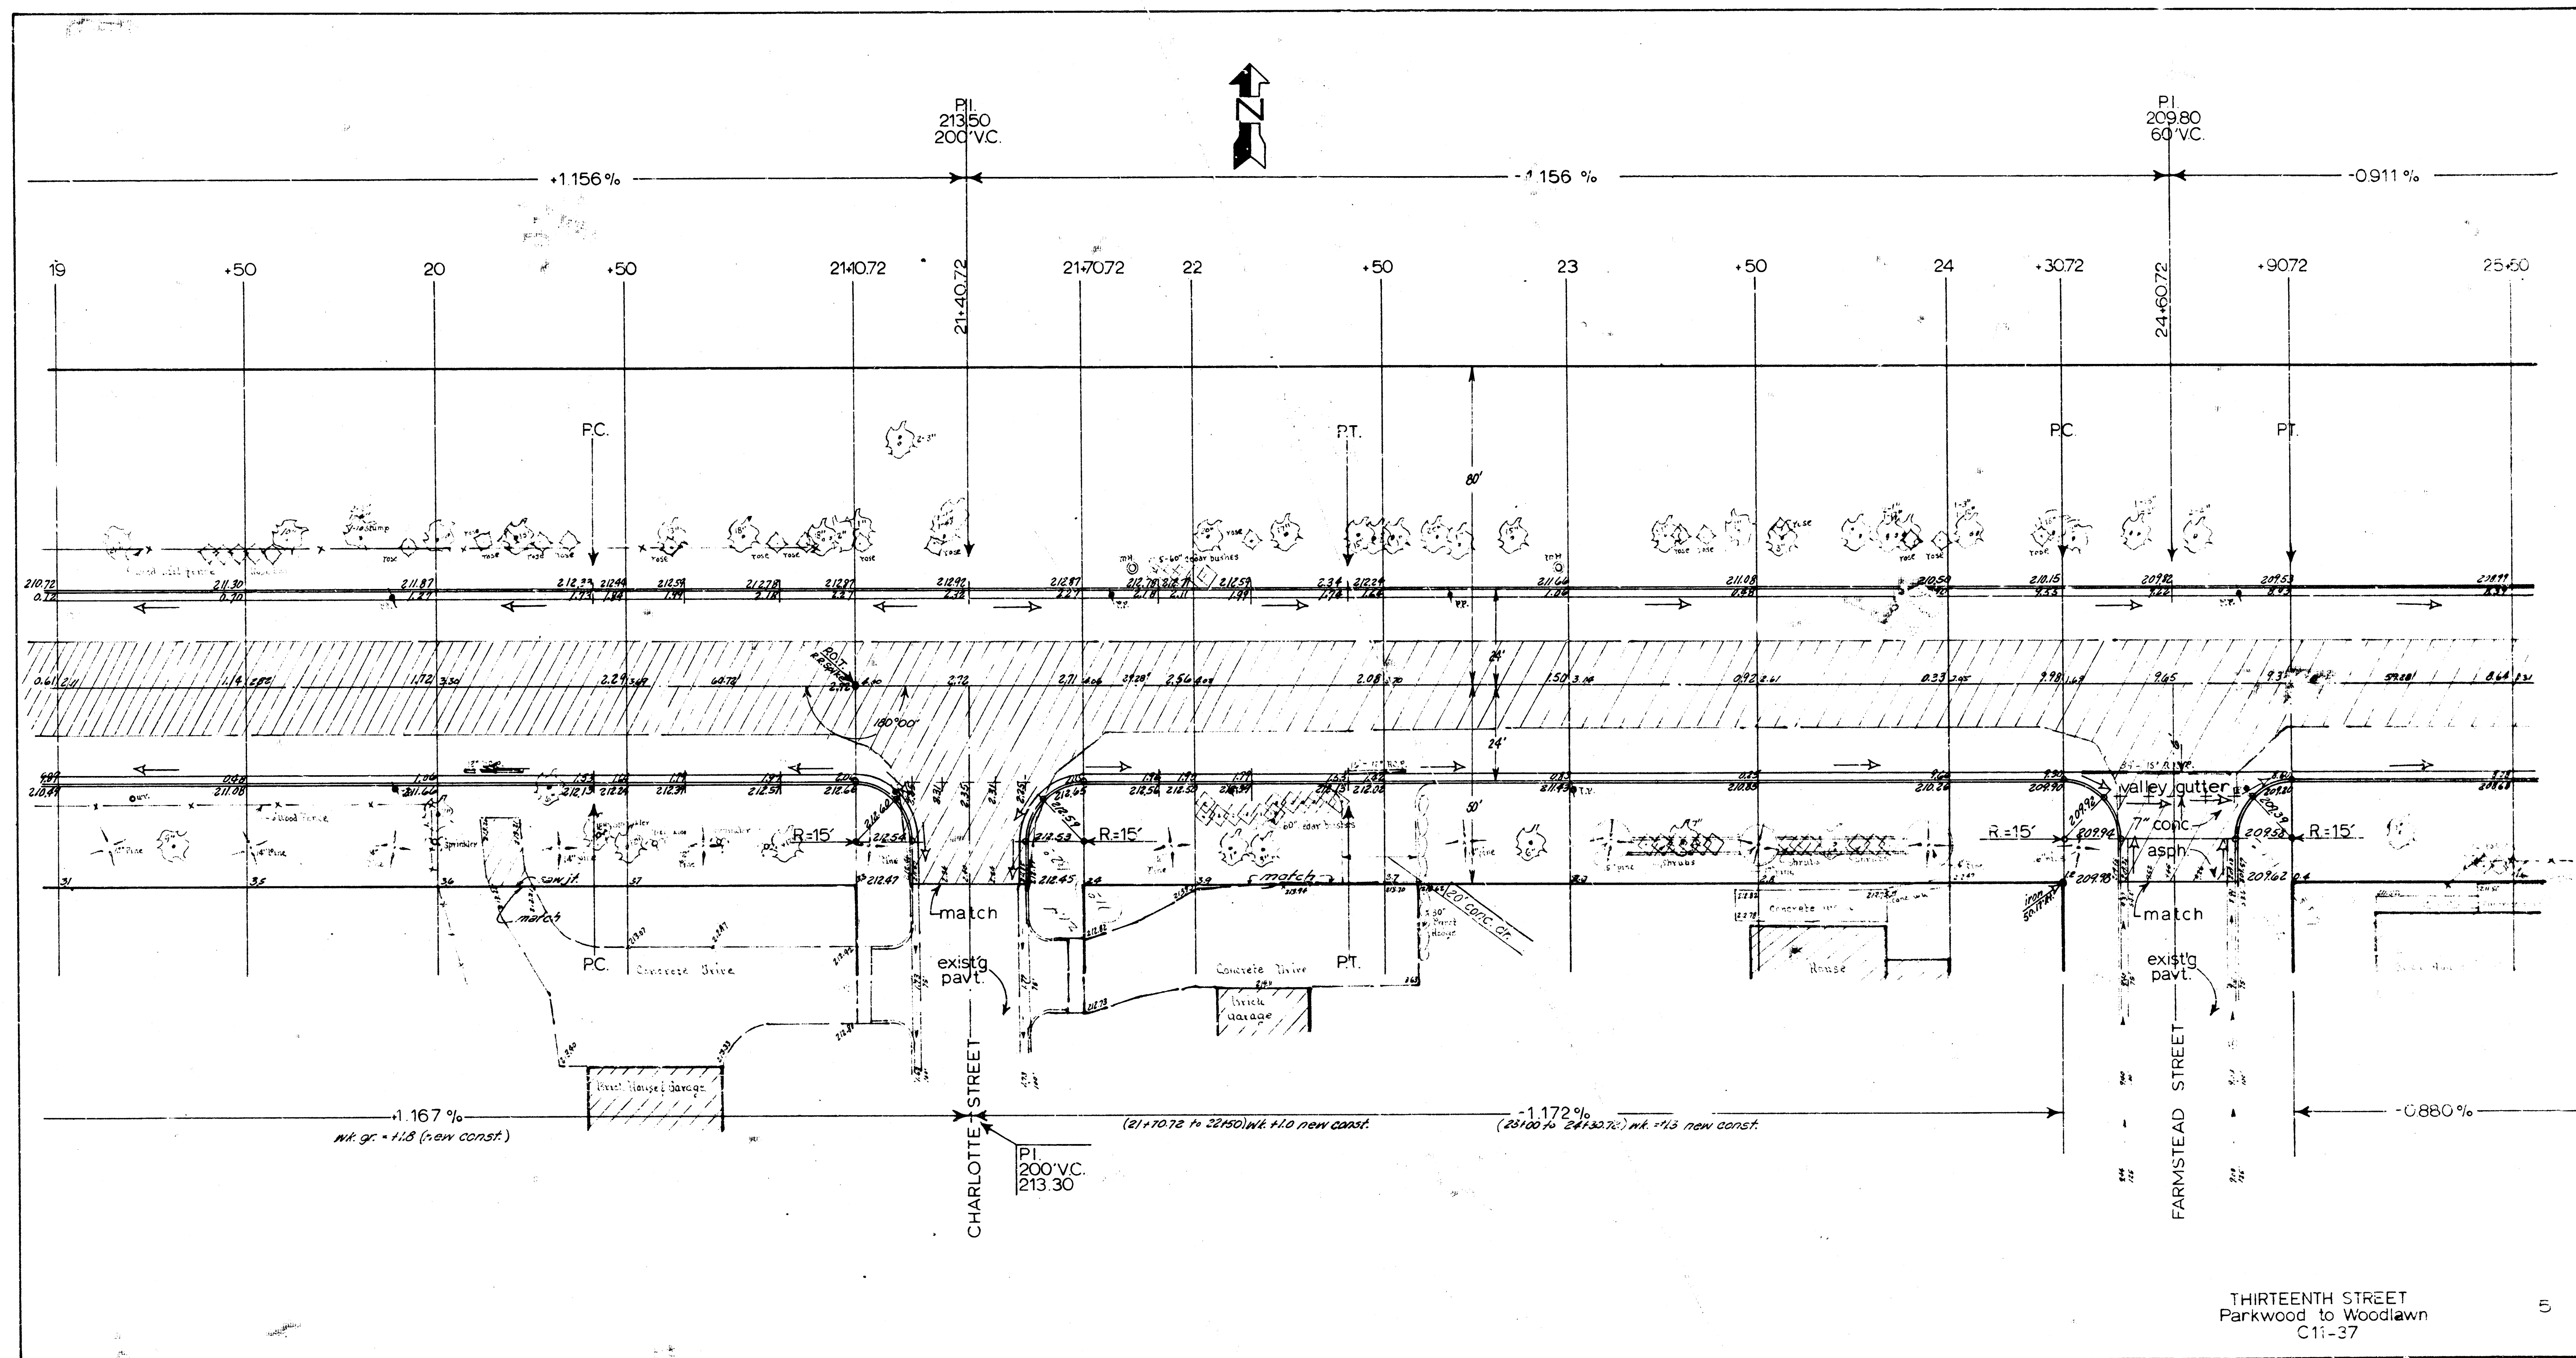

THIRTEENTH STREET
Parkwood to Woodlawn
C11-37

