


B.M. 11827 Top of Ch. N.E. Cor. 14th & Woodland
 B.M. 11827 N.E. Cor. Lower Step No. 1551 15th & Woodland

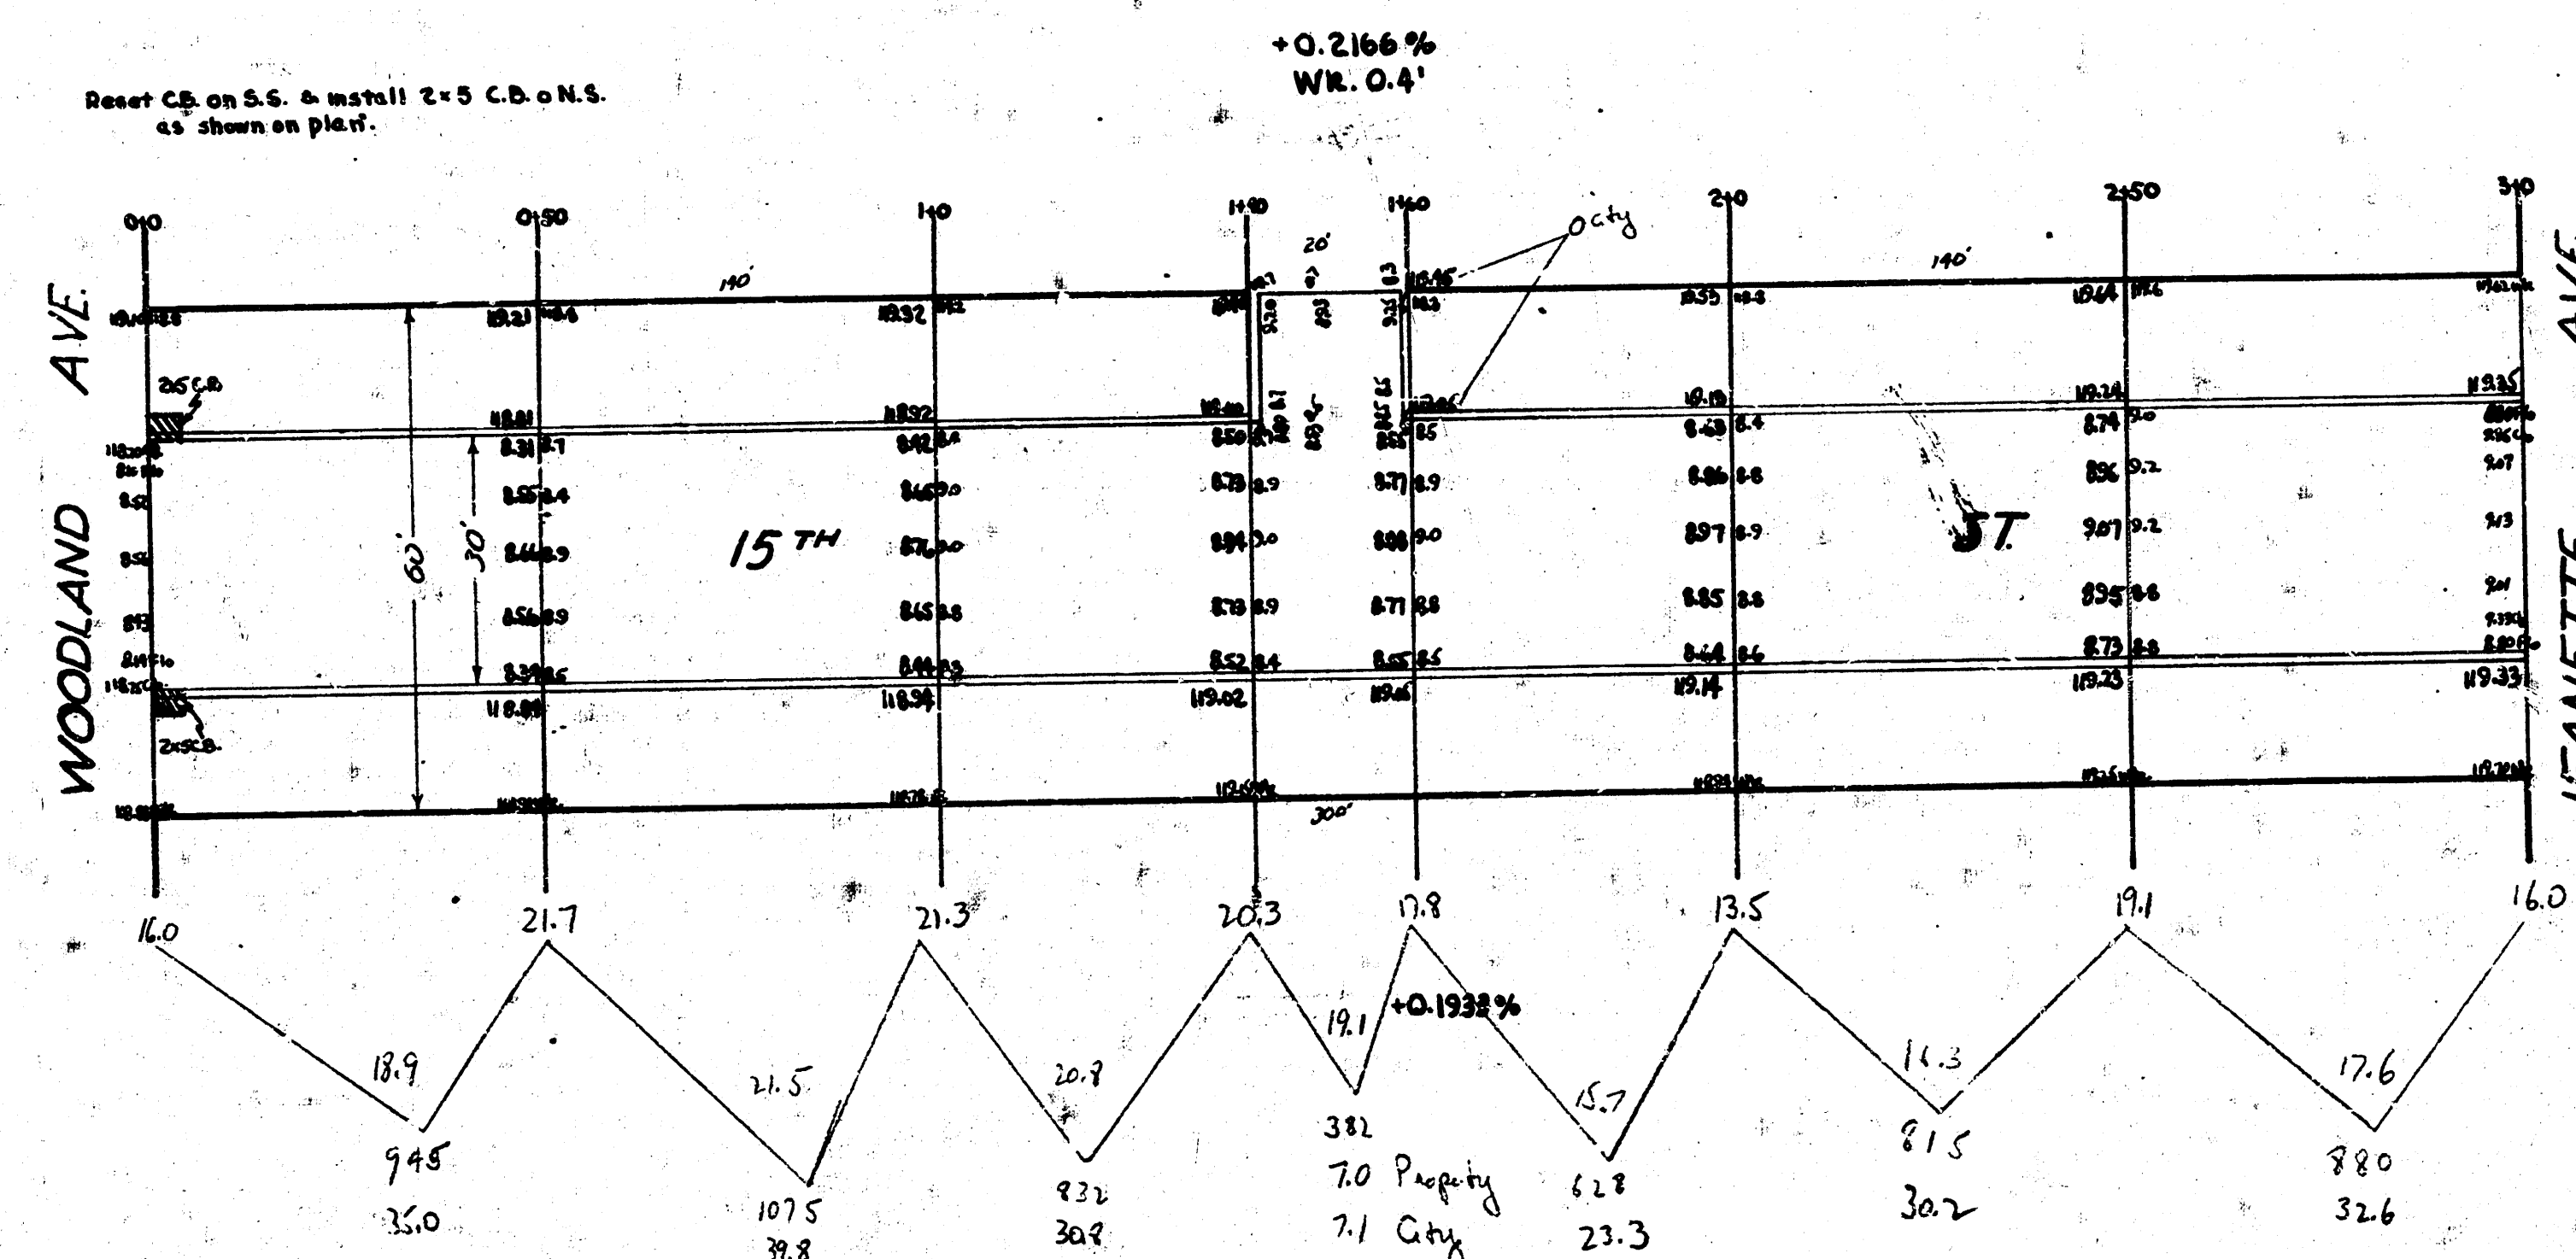


Property
 25.0
 31.8
 30.9
 30.7
 23.3
 30.2
 32.6
 199.7
 10.96
 218.6 cu yds

City
 7.1
 7.1
 10.96
 7.1 cu yds

15th ST.
 EL WOODLAND TO W. JEANETTE
 30' CONCRETE & CB
 CITY OF WICHITA, KANSAS
 L. K. WHITE CITY ENGINEER
 JULY 1946

B.M. 115.87 Top of Cb. N.E. Cor. 14th & Woodland
 B.M. 120.87 N.E. Cor. Lower Step 110' x 155' 15th & Woodland

Reset Cb. on S.S. & install 2' x 5' C.D. on N.S.
 as shown on plan.

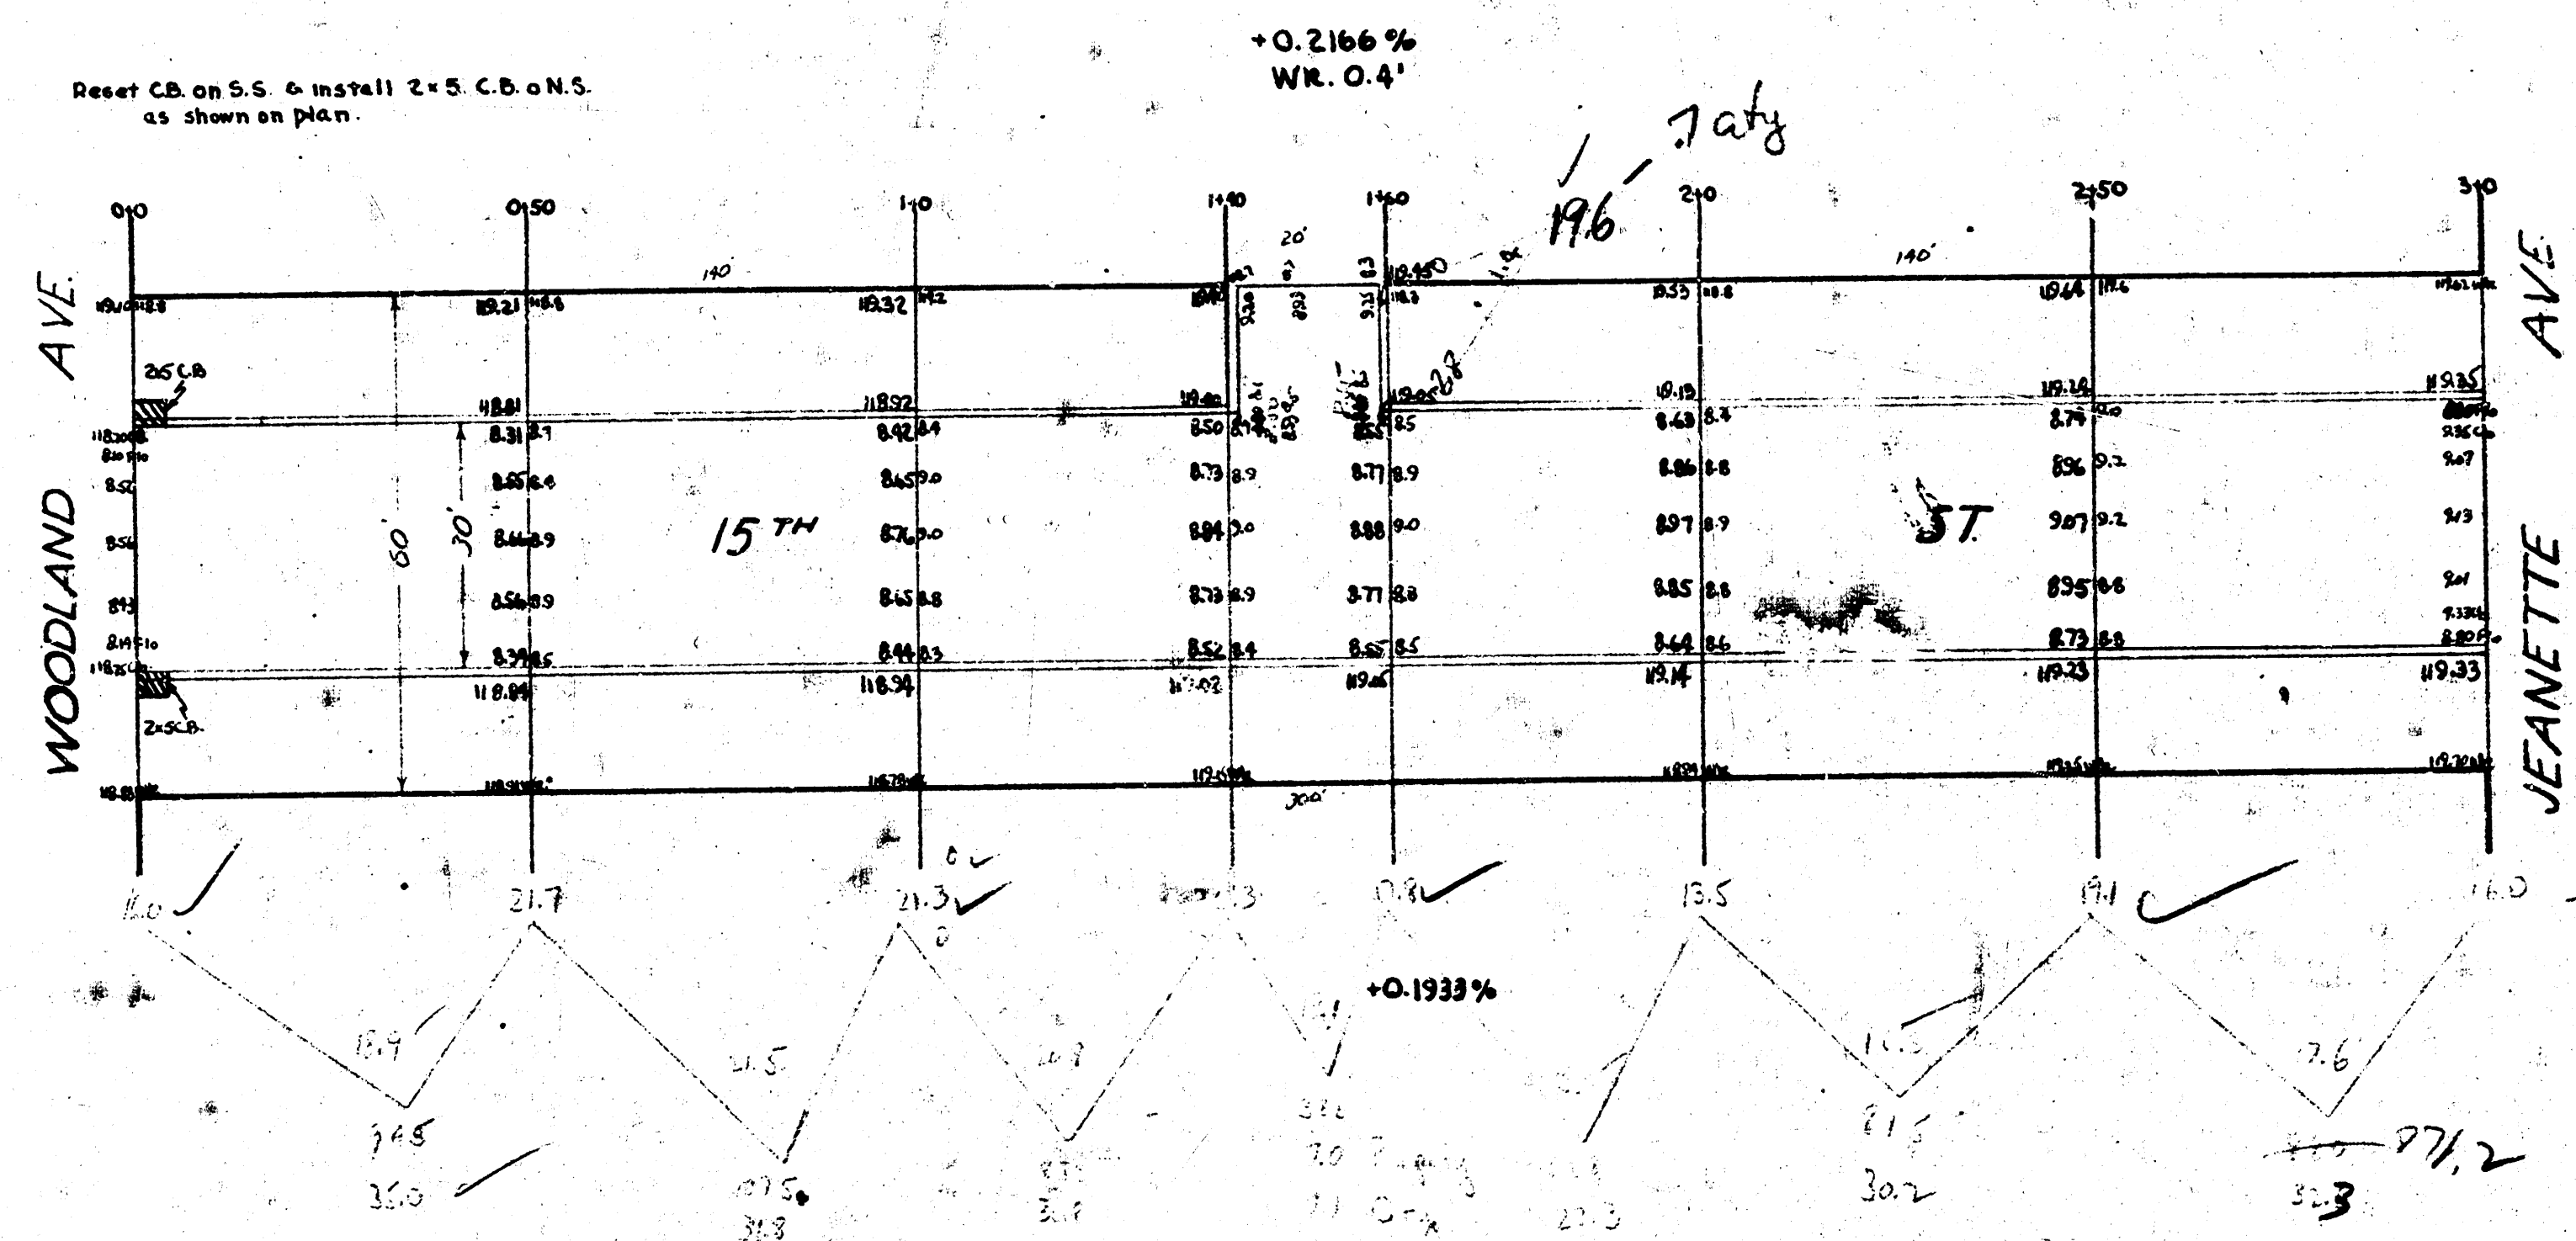

15TH ST.
 EL. WOODLAND TO WL. JEANETTE
 30" CONCRETE & CB
 CITY OF WICHITA, KANSAS
 L. K. WHITE CITY ENGINEER
 JULY 1946

754.48 241.69
 237