B.M. 128.42 SQ. HEAD SPIKE E.S. K.L.R. E.S. WEST STREET & 30' S. OF ℄ 15TH STREET EAST
B.M. 123.735 S.E. COR. 1ST. CONC. STEP SOUTH SCHOOL ENT. SCHOOL W.S. WEST @ 15TH STREET
NOTE: BASE LINE = CENTERLINE 15TH STREET

N

SCALE: 1" = 20 FT.

WEST STREET

-0.535 %
WALK GRADE +0.70

ILLINOIS AVENUE

-0.136 %
WALK GRADE +0.40

McCOMAS AVENUE

TIES TO IRON
1. 0.80' E. TO W. FACE WDE. FROM 1610 NO.
2. 15.0' S. TO C. FACE WDE. FROM 1610 EAST

STA. 0+00 — 0+50 — 1+00 — 1+50 — 2+00 — 2+50 — 3+00 — 3+50 — 4+00 — 4+50 — 5+00 — 5+41.97

2+61.84 — 3+12.22

6" SANITARY SEWER

8" SANITARY SEWER

VALLEY GUTTER

24" C.M.P.

30" C.M.P.

FULL CROWN

½ CROWN

8" CONCRETE RETURN

NO CROWN

8" CONCRETE RET.

60.0' R

TIES TO IRON
1. 42.4' S.E. TO CTR. FIRE HYD.
2. 28.8' WEST TO STEEL PAC. M.H.

4.8 D.H. 4" HOOK-UP

-0.515 %
WALK GRADE +0.70

-0.261 %
WALK GRADE +0.70 TO +0.40

EXCAVATION TOTALS

PROPERTY		CITY	
EXCAVATION	FILL	EXCAVATION	FILL
3331.6	- 181	714.4	3.5
+10% 333.2	+ 10% 1.8	+10% 71.4	+10% 0.3
3664.8 CU.YDS.	19.9 CU.YDS.	785.8 CU.YDS.	3.8 CU.YDS.

JAMES H. TILLOY 2012 REGISTERED ENGINEER

JOHN E. ERICKSON LICENSED 531 KANSAS ENGINEER

436

1/7

15TH. STREET

E.L. WEST STREET — W.L. GCW STREET

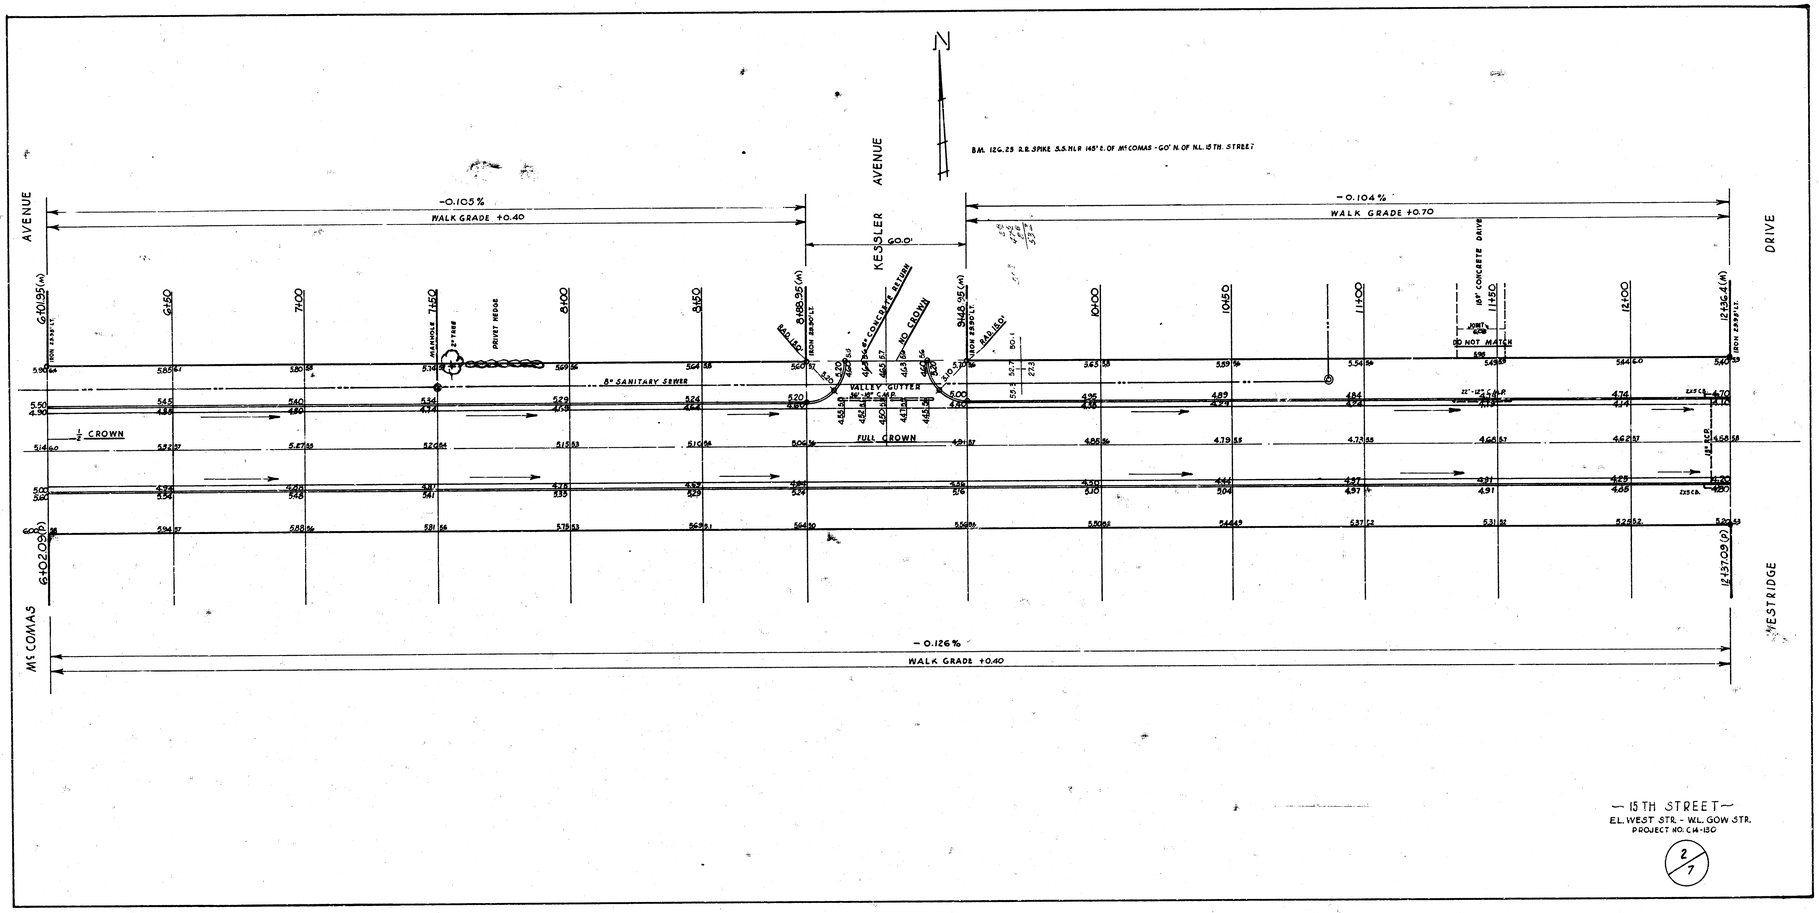
26-2-30 ASPHALTIC CONC.

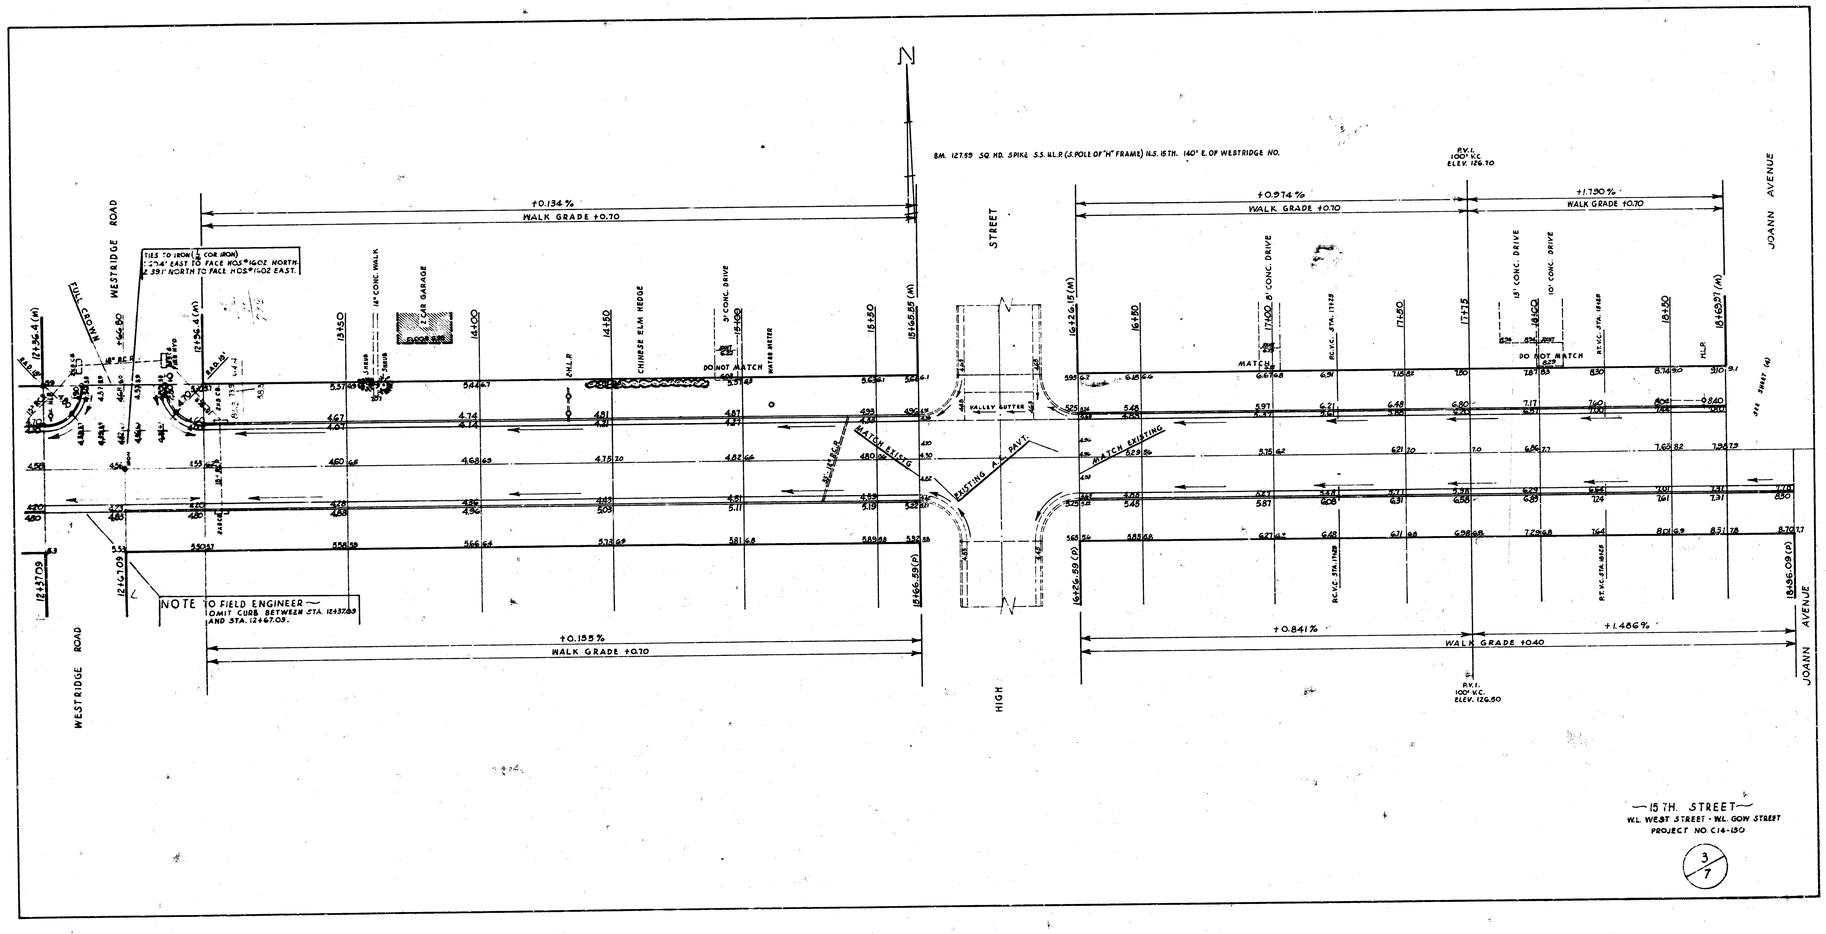
CITY OF WICHITA, KANSAS

B.E. SMITH — CITY ENGINEER

DATE MAY 1960 — PROJ. NO. C-14-150

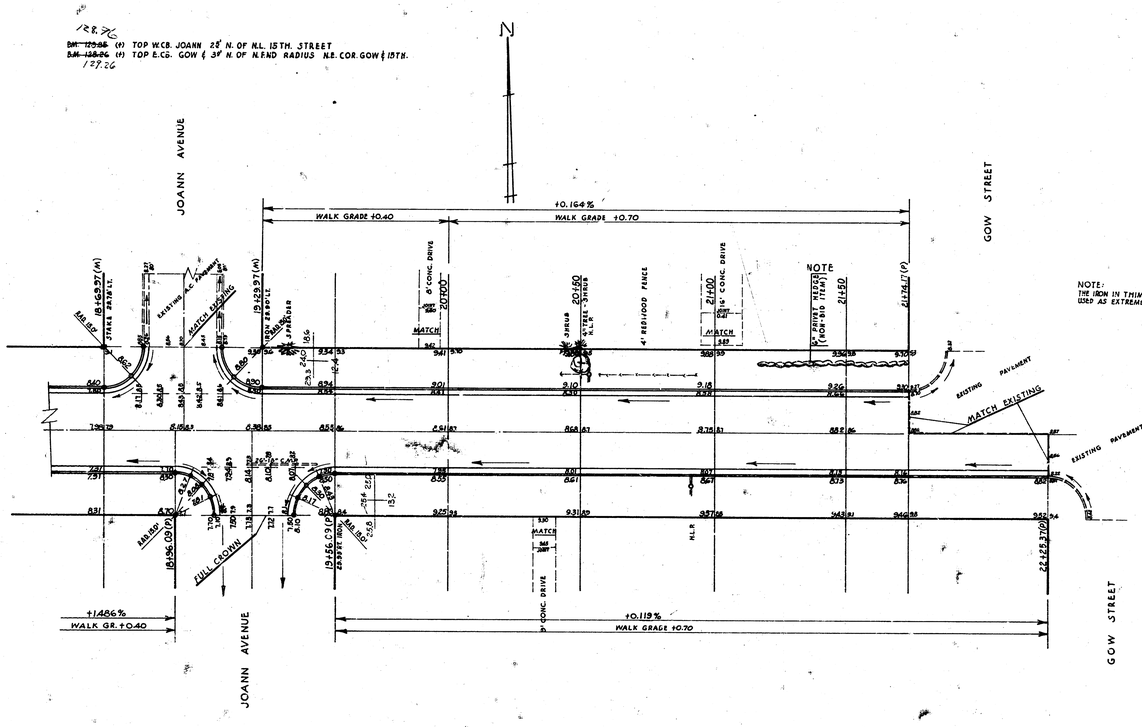
Surv. G. YOUNG 2-16-60
S.SEAL
L. SEAL
Inst. 12


N
BM. 126.23 R.R. SPIKE S.S. NLR 145' E. OF McCOMAS - GO' N. OF NL. 15TH. STREET
AVENUE
KESSLER AVENUE
DRIVE
-0.105%
WALK GRADE +0.40
-0.104%
WALK GRADE +0.70
60.0'
G60.95(M)
G150
7400
7450
8400
8450
8489.95(M)
9460.95(M)
10400
10450
11400
11450
12400
12436.41(M)
IRON ROD L.T.
MANHOLE
2" TREE
PRIVET HEDGE
CONCRETE BASIN
NO CROWN
MAIN LINE
SAN. LINE
18" CONCRETE DRIVE
JOINT
DO NOT MATCH
8" SANITARY SEWER
VALLEY GUTTER
22'-12" C.M.P.
1.5% C.B.
1/2 CROWN
FULL CROWN
18" R.C.P.
1.5% C.B.
6402.09(M)
12437.09(M)
MS COMAS
WESTRIDGE
-0.126%
WALK GRADE +0.40
-15TH STREET-
EL. WEST STR. - W.L. GOW STR.
2/7


N
BM. 127.59 SQ. HD. SPIKE 3.5. W.L.P. (S. POLE OF "H" FRAME) N.S. 15TH. 140' E. OF WESTRIDGE RD.
R.V.I. 100' V.C. ELEV. 126.70
WESTRIDGE ROAD
JOANN AVENUE
STREET
HIGH
+0.134 %
WALK GRADE +0.70
+0.974 %
WALK GRADE +0.70
+1.730 %
WALK GRADE +0.70
+0.155 %
WALK GRADE +0.70
+0.841 %
WALK GRADE +0.40
+1.466 %
TIES TO IRON (1/2 COR. IRON)
2 CAR GARAGE
EXIST. SHED
14' CONC. WALK
CHINESE ELM HEDGE
5' CONC. DRIVE
10' CONC. DRIVE
13' CONC. DRIVE
WATER METER
DO NOT MATCH
MATCH
MATCH EXISTING
EXISTING A.C. PAVT.
VALLEY GUTTER
R.V.C. STA. 17+29
R.V.C. STA. 17+89
R.V.C. STA. 18+29
R.V.C. STA. 17+08
R.V.C. STA. 18+29
R.V.I. 100' V.C. ELEV. 126.50
NOTE TO FIELD ENGINEER
OMIT CURB BETWEEN STA. 12+37.09 AND STA. 12+67.09.
15TH. STREET
W.L. WEST STREET - W.L. GOW STREET
3/7

128.26

~~BM 129.86~~ (+) TOP W.C.B. JOANN 28' N. OF N.L. 15TH. STREET
~~BM 128.26~~ (+) TOP E.C.B. GOW & 3' N. OF N.R.ND RADIUS N.E. COR. GOW & 15TH.
127.26



4/7