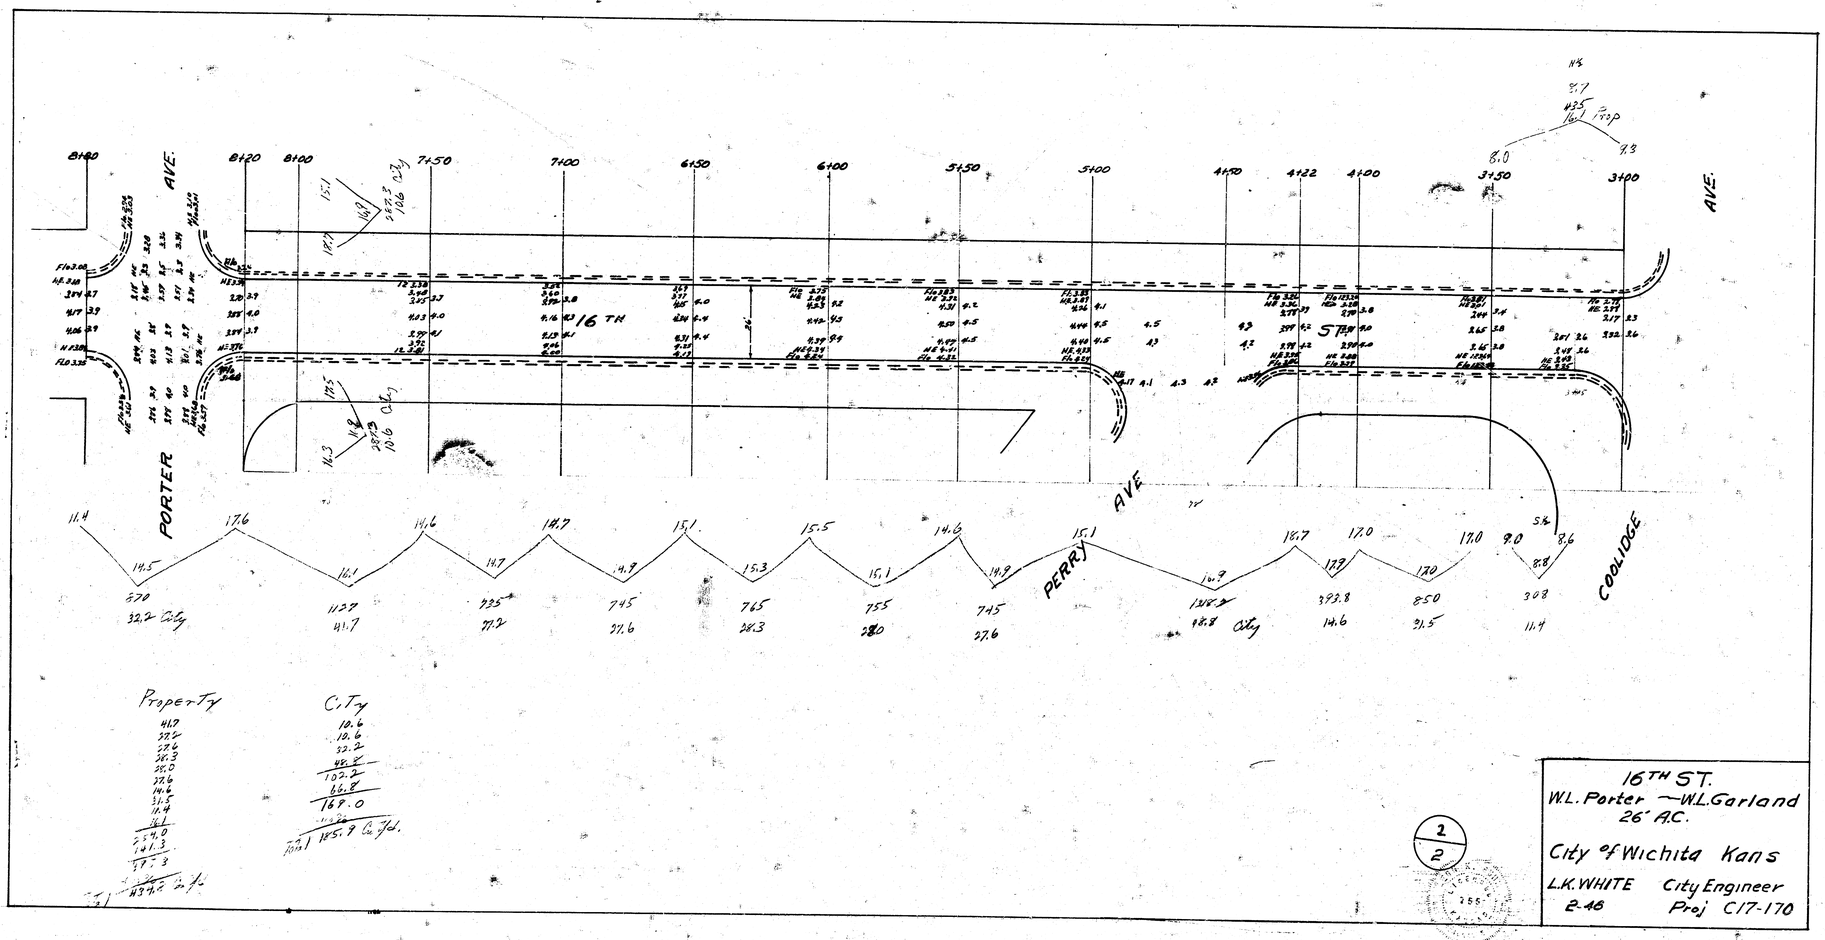
8+40
AVE.
8+20
8+00
7+50
7+00
6+50
6+00
5+50
5+00
4+70
4+22
4+00
3+50
3+00
AVE.
16 TH
5 TH
PORTER
PERRY AVE
COOLIDGE
11.4
14.5
17.6
16.1
14.6
14.7
14.9
15.1
15.3
15.5
15.1
14.6
14.9
15.1
10.9
16.7
17.0
17.0
17.0
9.0
8.8
8.6
370
32.2 City
1127
41.7
935
27.2
745
27.6
765
28.3
755
28.0
745
27.6
1148
18.8 City
393.8
14.6
850
31.5
308
11.4
Property
41.7
32.2
27.6
28.3
28.0
27.6
14.6
31.5
11.4
274.0
141.3
17.3
434.0 Cu. Yd.
City
10.6
10.6
32.2
18.8
102.2
66.8
169.0
185.9 Cu. Yd.
16TH ST.
W.L. Porter — W.L. Garland
26' A.C.
City of Wichita Kans
L.K. WHITE City Engineer
2-46 Proj C17-170
2
2

Bk 44 JJ

B.M. 120.92 "A" in W. ITCHIE No. Cb. 16TH ST. EL. GARLAND.

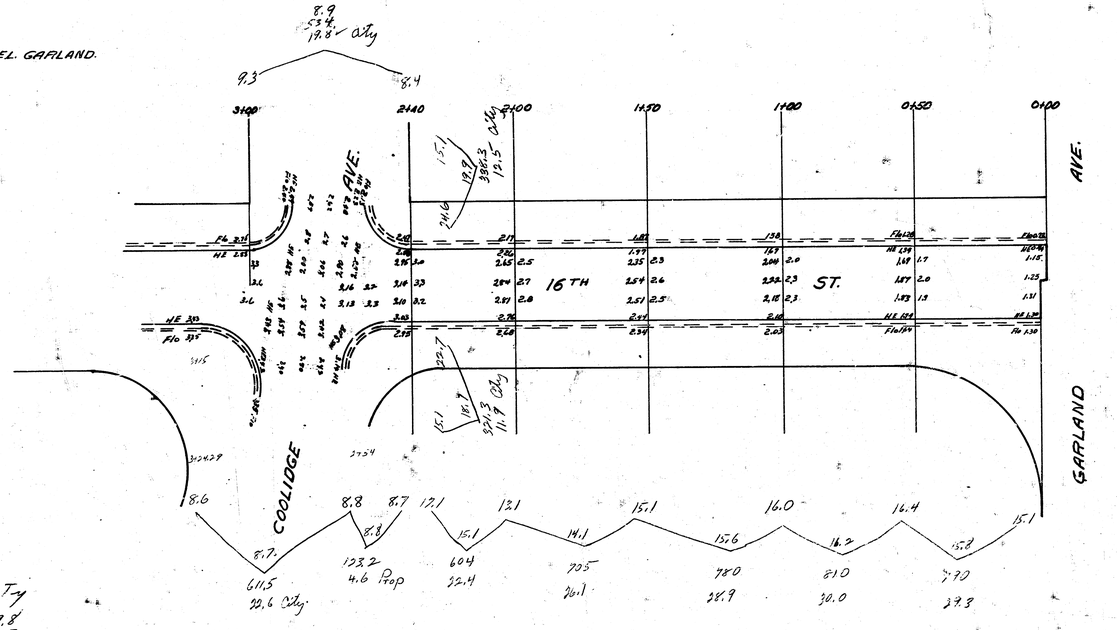

Property	City
32.4	19.8
26.1	12.5
26.9	11.9
32.0	22.6
39.3	66.8
4.6	
161.3	

1/2

16TH ST.
W.L. Porter — W.L. Garland
26' A.C.
City of Wichita Kans.
L.K. WHITE City Engineer
2-48 Proj C 17-170

184 E

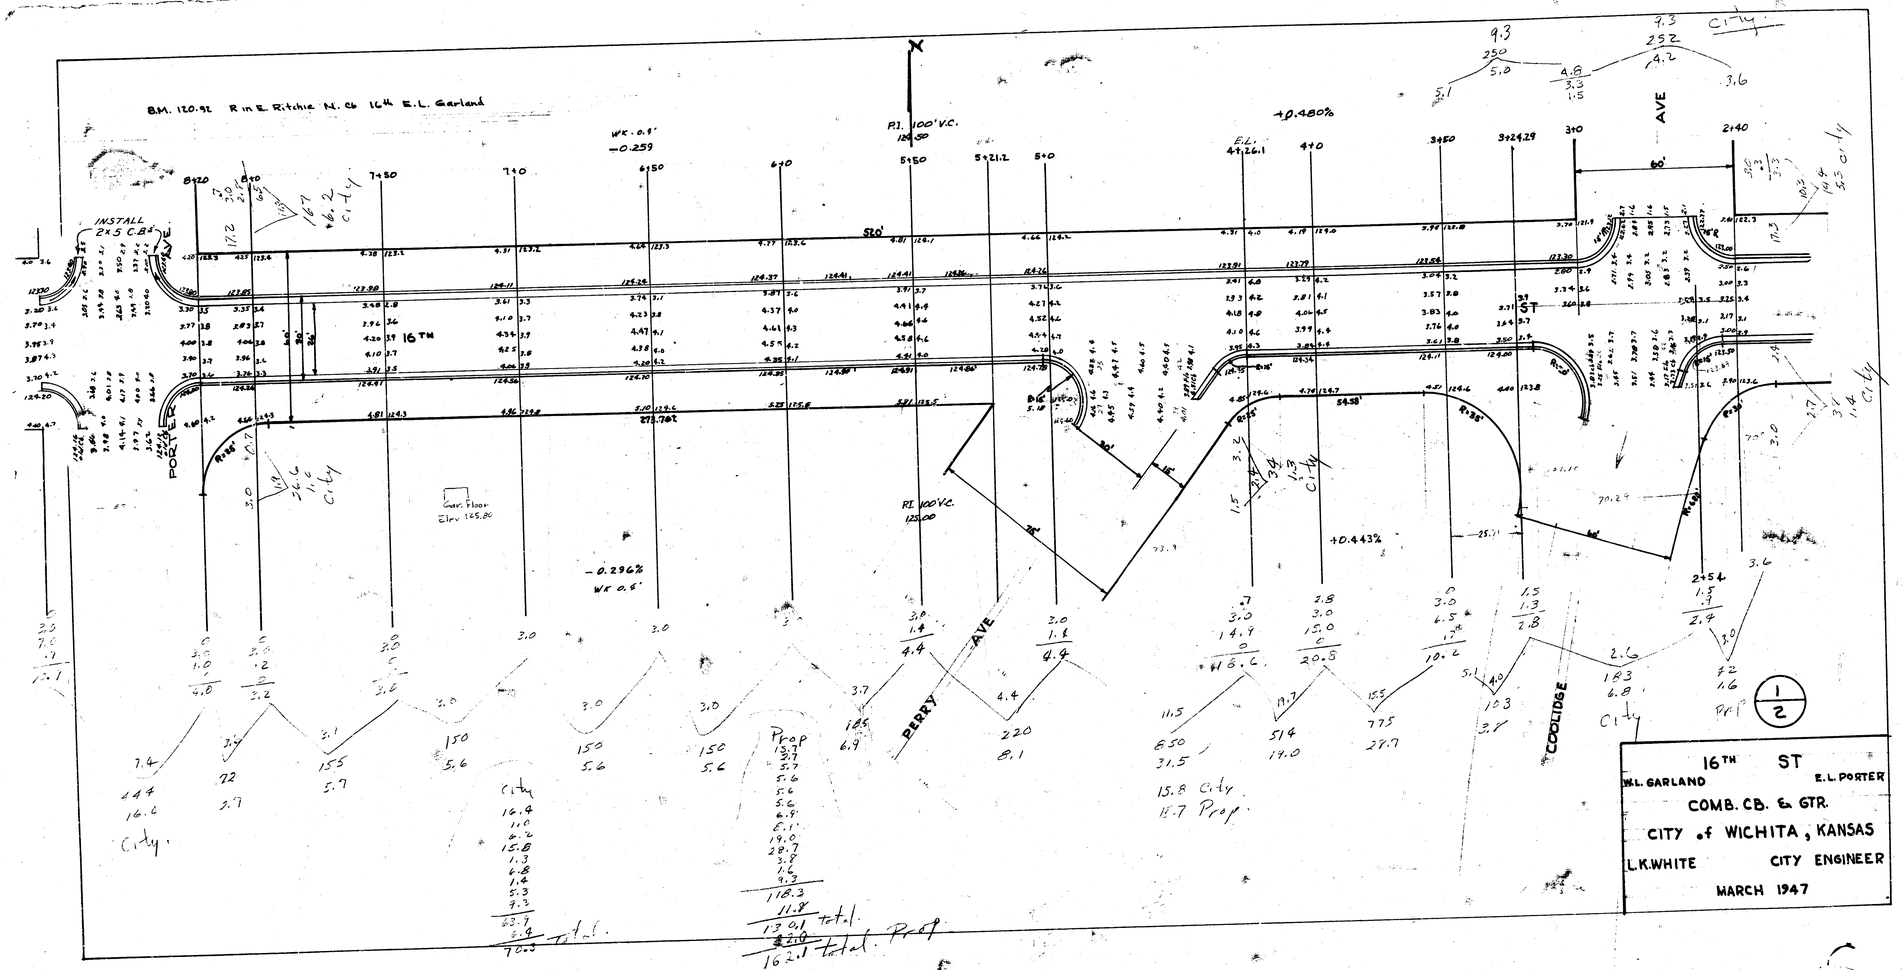
BM. 120.92 R in E. Ritchie N. of 16th E.L. Garland
INSTALL 2x5 C.B.
PORTER AVE
16TH ST
PI. 100' V.C. 124.50
WK - 0.9' -0.259
+0.480%
E.L. 4+26.1
-0.296% WK 0.6'
+0.443%
RI. 100' V.C. 125.00
PERRY AVE
COOLIDGE
60'
80'
520'
272.70'
54.58'
Curb Floor Elev 125.86
8+20
8+00
7+50
7+40
6+50
6+40
5+50
5+21.2
5+0
4+0
3+50
3+24.29
3+0
2+40
2+54
City
Prop
Total
Total Prop
W.L. GARLAND
E.L. PORTER
COMB. CB. & GTR.
CITY of WICHITA, KANSAS
L.K. WHITE CITY ENGINEER
MARCH 1947
1/2

N

AVE

2+00 2+50 1+50 1+00 0+50 0+00

+0.58% 0.4 WK

220'

16TH ST

174'

80'R 80'R

+0.68% 0.4 WK

COOLIDGE

GARLAND






2/2

Bk. 44 JJ

B.M. 120.92 "A" IN RITCHIE No. Cb. 16TH ST. EL. GARLAND

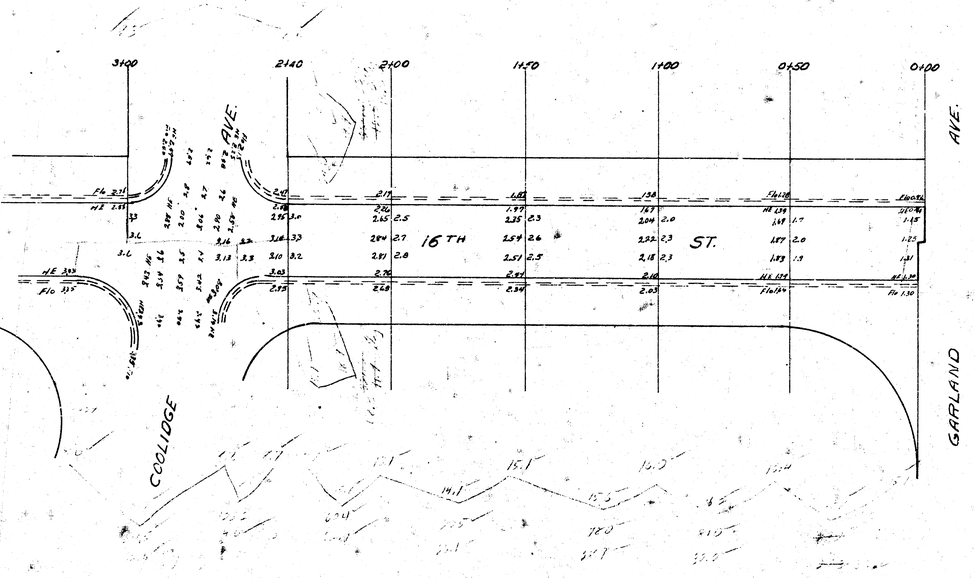

1/2

16TH ST.
W.L. Porter — W.L. Garland
26' AC.
City of Wichita Kans.
L.K. WHITE City Engineer
2-48 Proj C 17-170

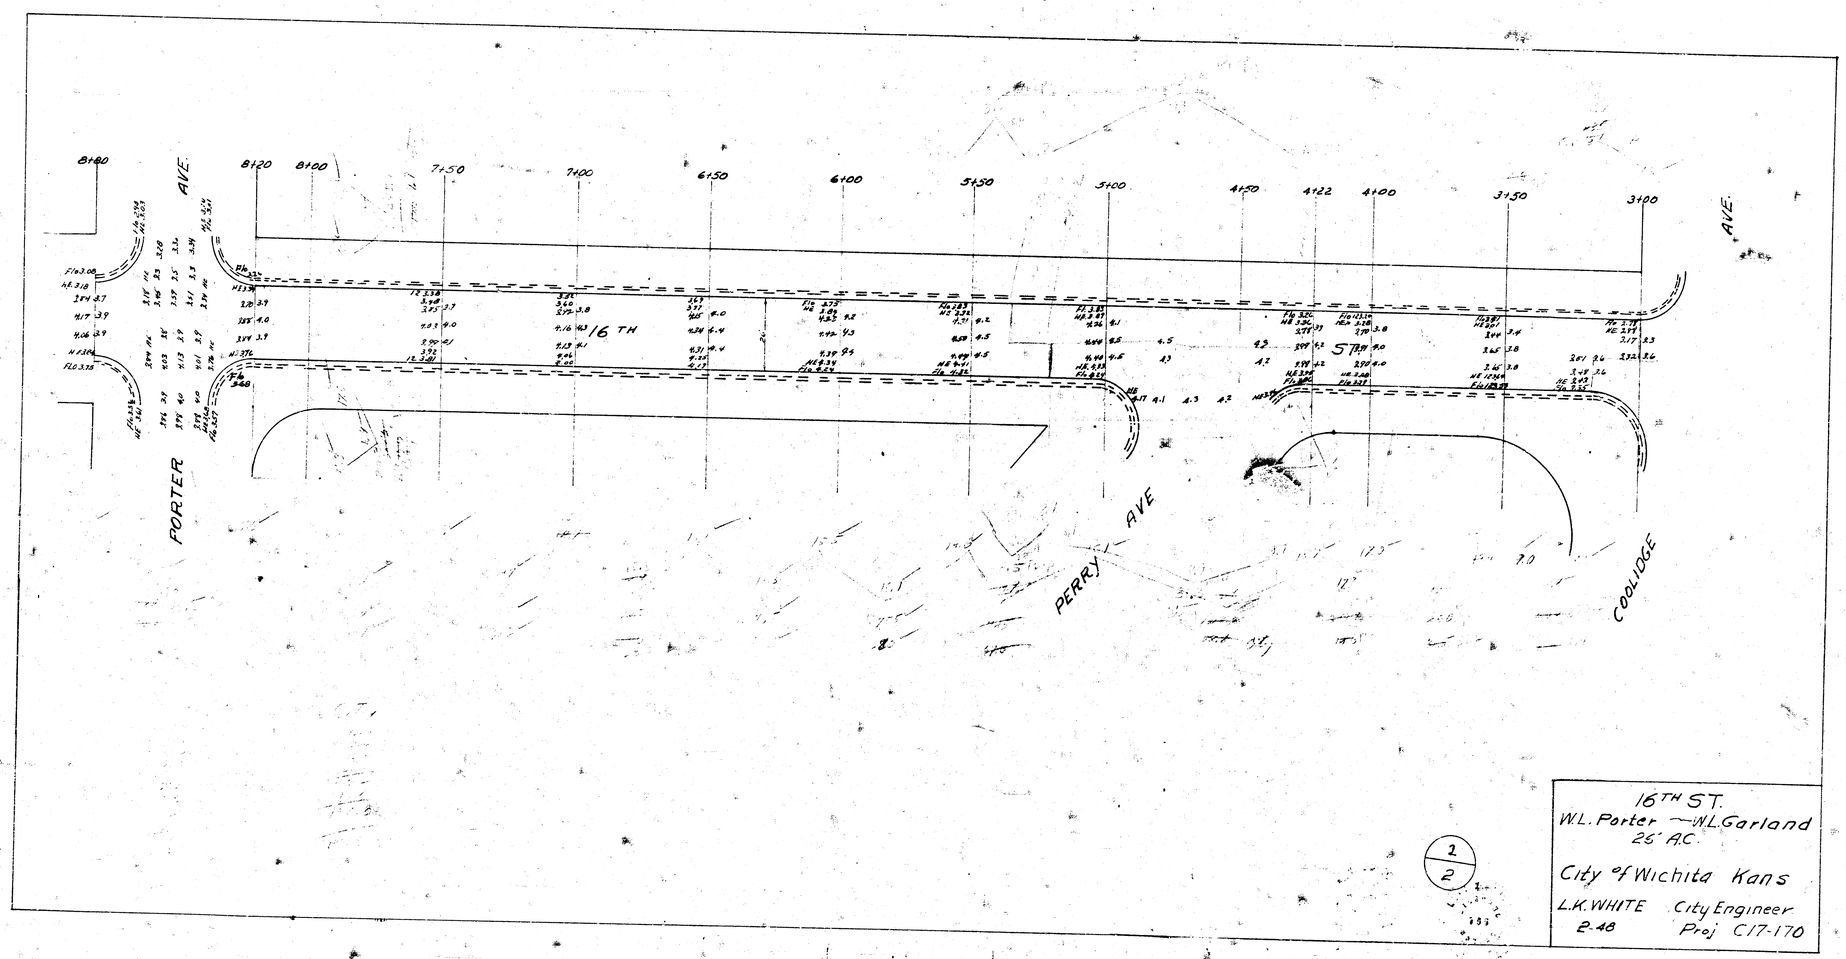

16TH ST.
W.L. Porter — W.L. Garland
26' A.C.

City of Wichita Kans
L.K. WHITE City Engineer
2-48 Proj C17-170

2/2

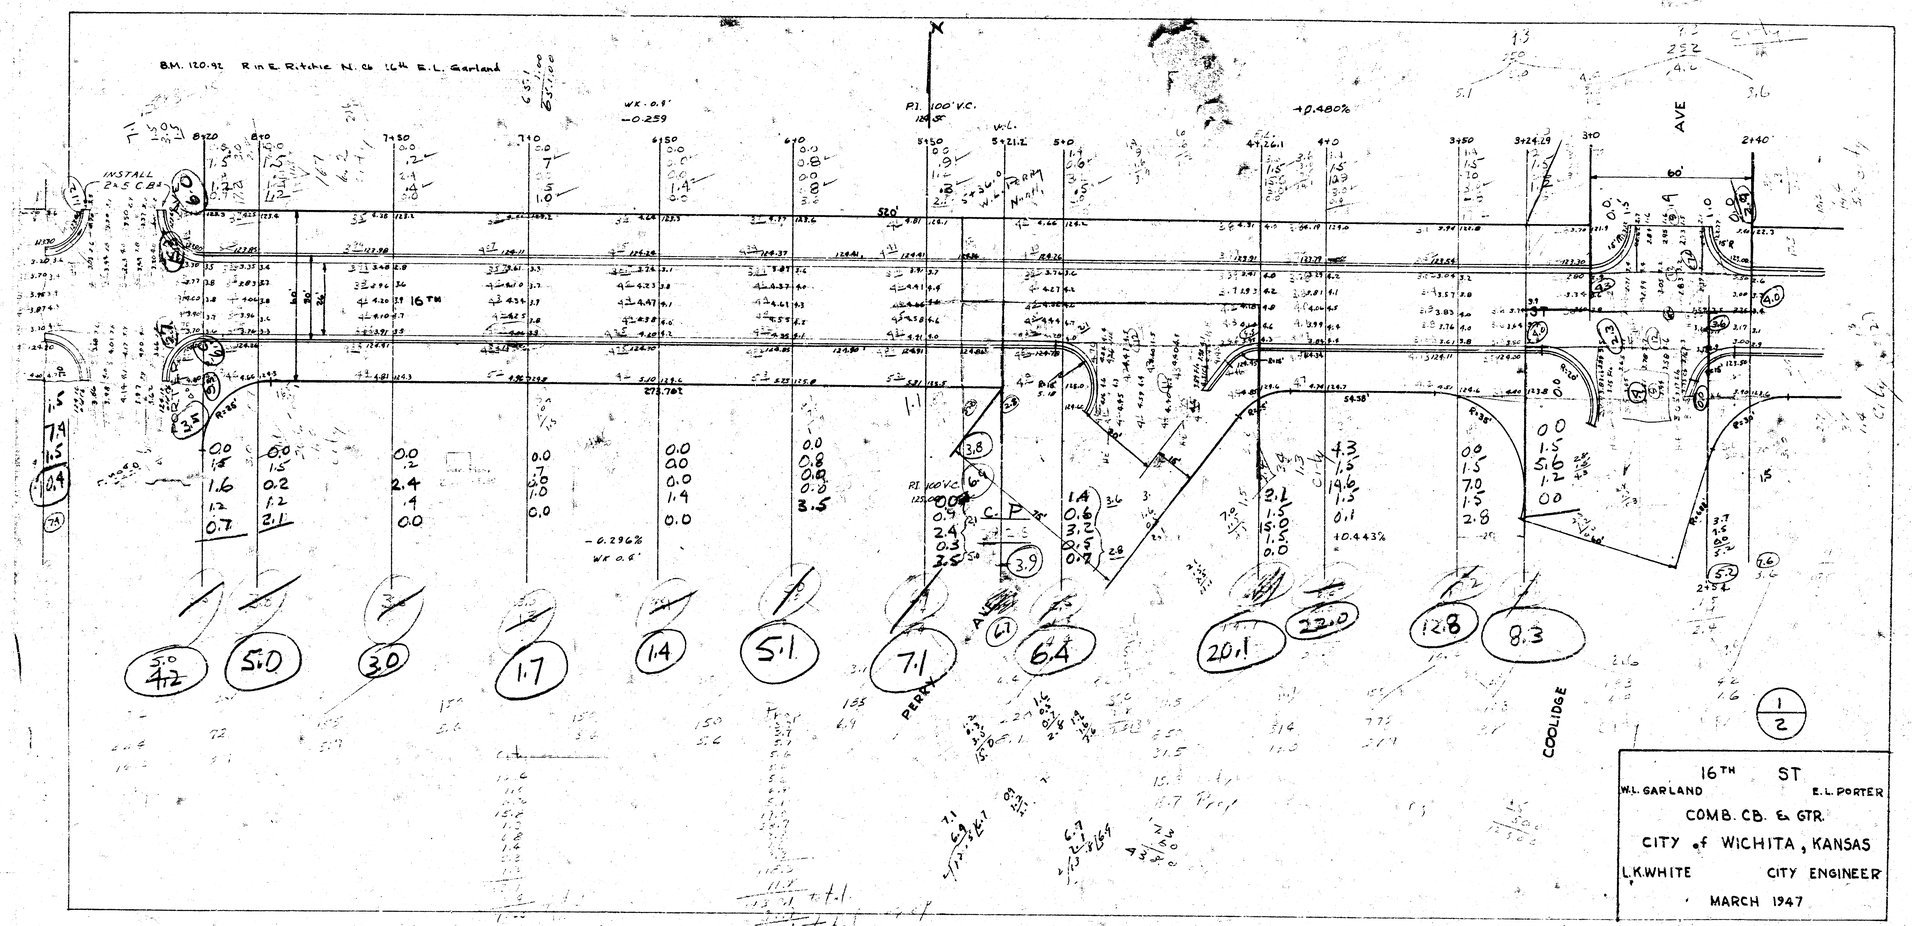
B.M. 120.92 R in E. Ritchie N. 06 16th E.L. Garland
INSTALL 2-5' C.B.'s
16TH
PERRY
AVE
COOLIDGE
60'
520'
+0.480%
-0.296%
16 TM
16TH ST
W.L. GARLAND
E.L. PORTER
COMB. C.B. & GTR.
CITY of WICHITA, KANSAS
L.K. WHITE CITY ENGINEER
MARCH 1947

N

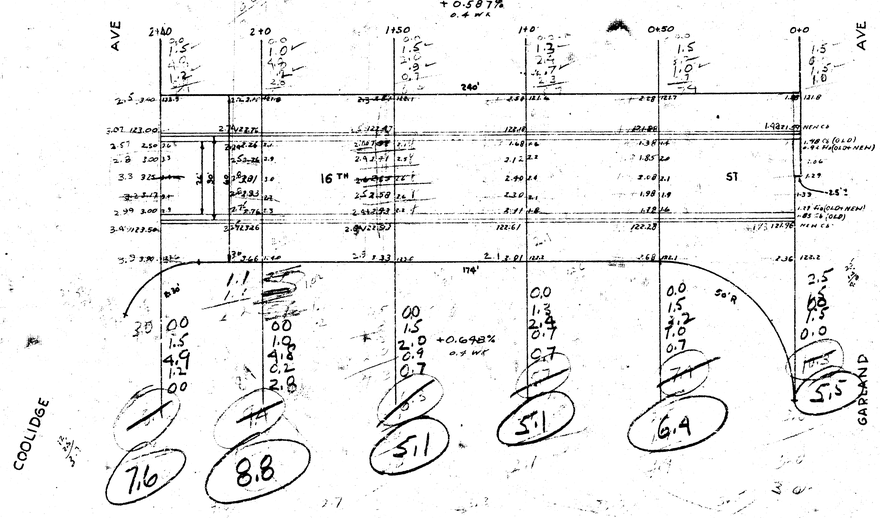
AVE
2+40
2+0
1+50
1+0
0+50
0+0
AVE
240'
16TH
ST
174'
+0.587%
0.4 WE
+0.648%
0.4 WE
COOLIDGE
GARLAND
7.6
8.8
5.1
5.1
6.9
5.5

2/2