


RM = 130.559 Standard SE cor West St & 17th.

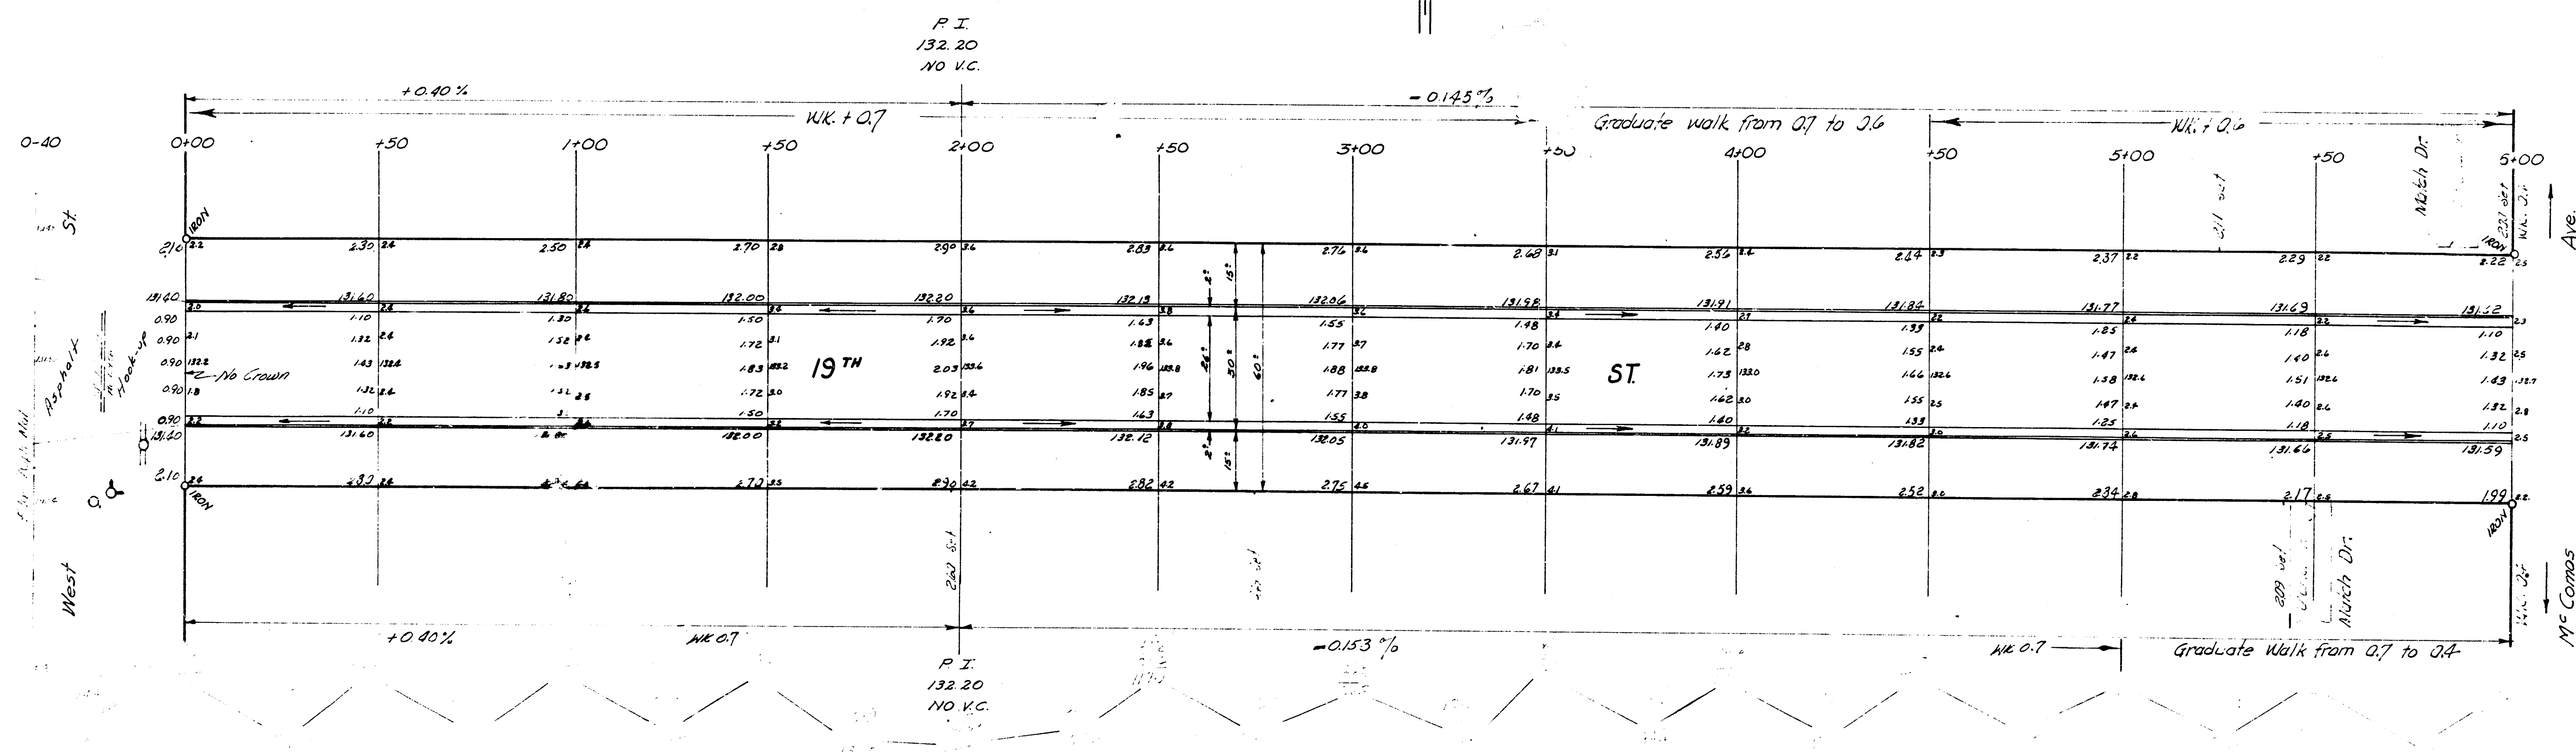

NOTE TO FIELD ENGINEER:

Walk grade has been raised from 04 to 07 on S. side Sta. 0+00 to 6+00. Check if new walk grade will match existing construction.

Sheet 1 of 2.

19th ST.

EL West St to WL Westridge Dr

26-2-30AC

CITY OF WICHITA, KANSAS

B.E. SMITH CITY ENGINEER

SEPT 1958, PROJ. NO C15-148

