


Final Notes
 Put Section (Book 10)

B.M. 121.46 - "X" front of walk S.W. cor. Woodland & 19th.
 B.M. 119.82 - Top of elm. ckn. 18th. & Woodland.


Prop.	City
38.0	7.0
37.6	78.6
27.1	20.7
9.8	21.3
15.6	58.9
37.8	19.2
16.6 + 10%	20.1
182.5	5
	22.8 - 10%
	25.5

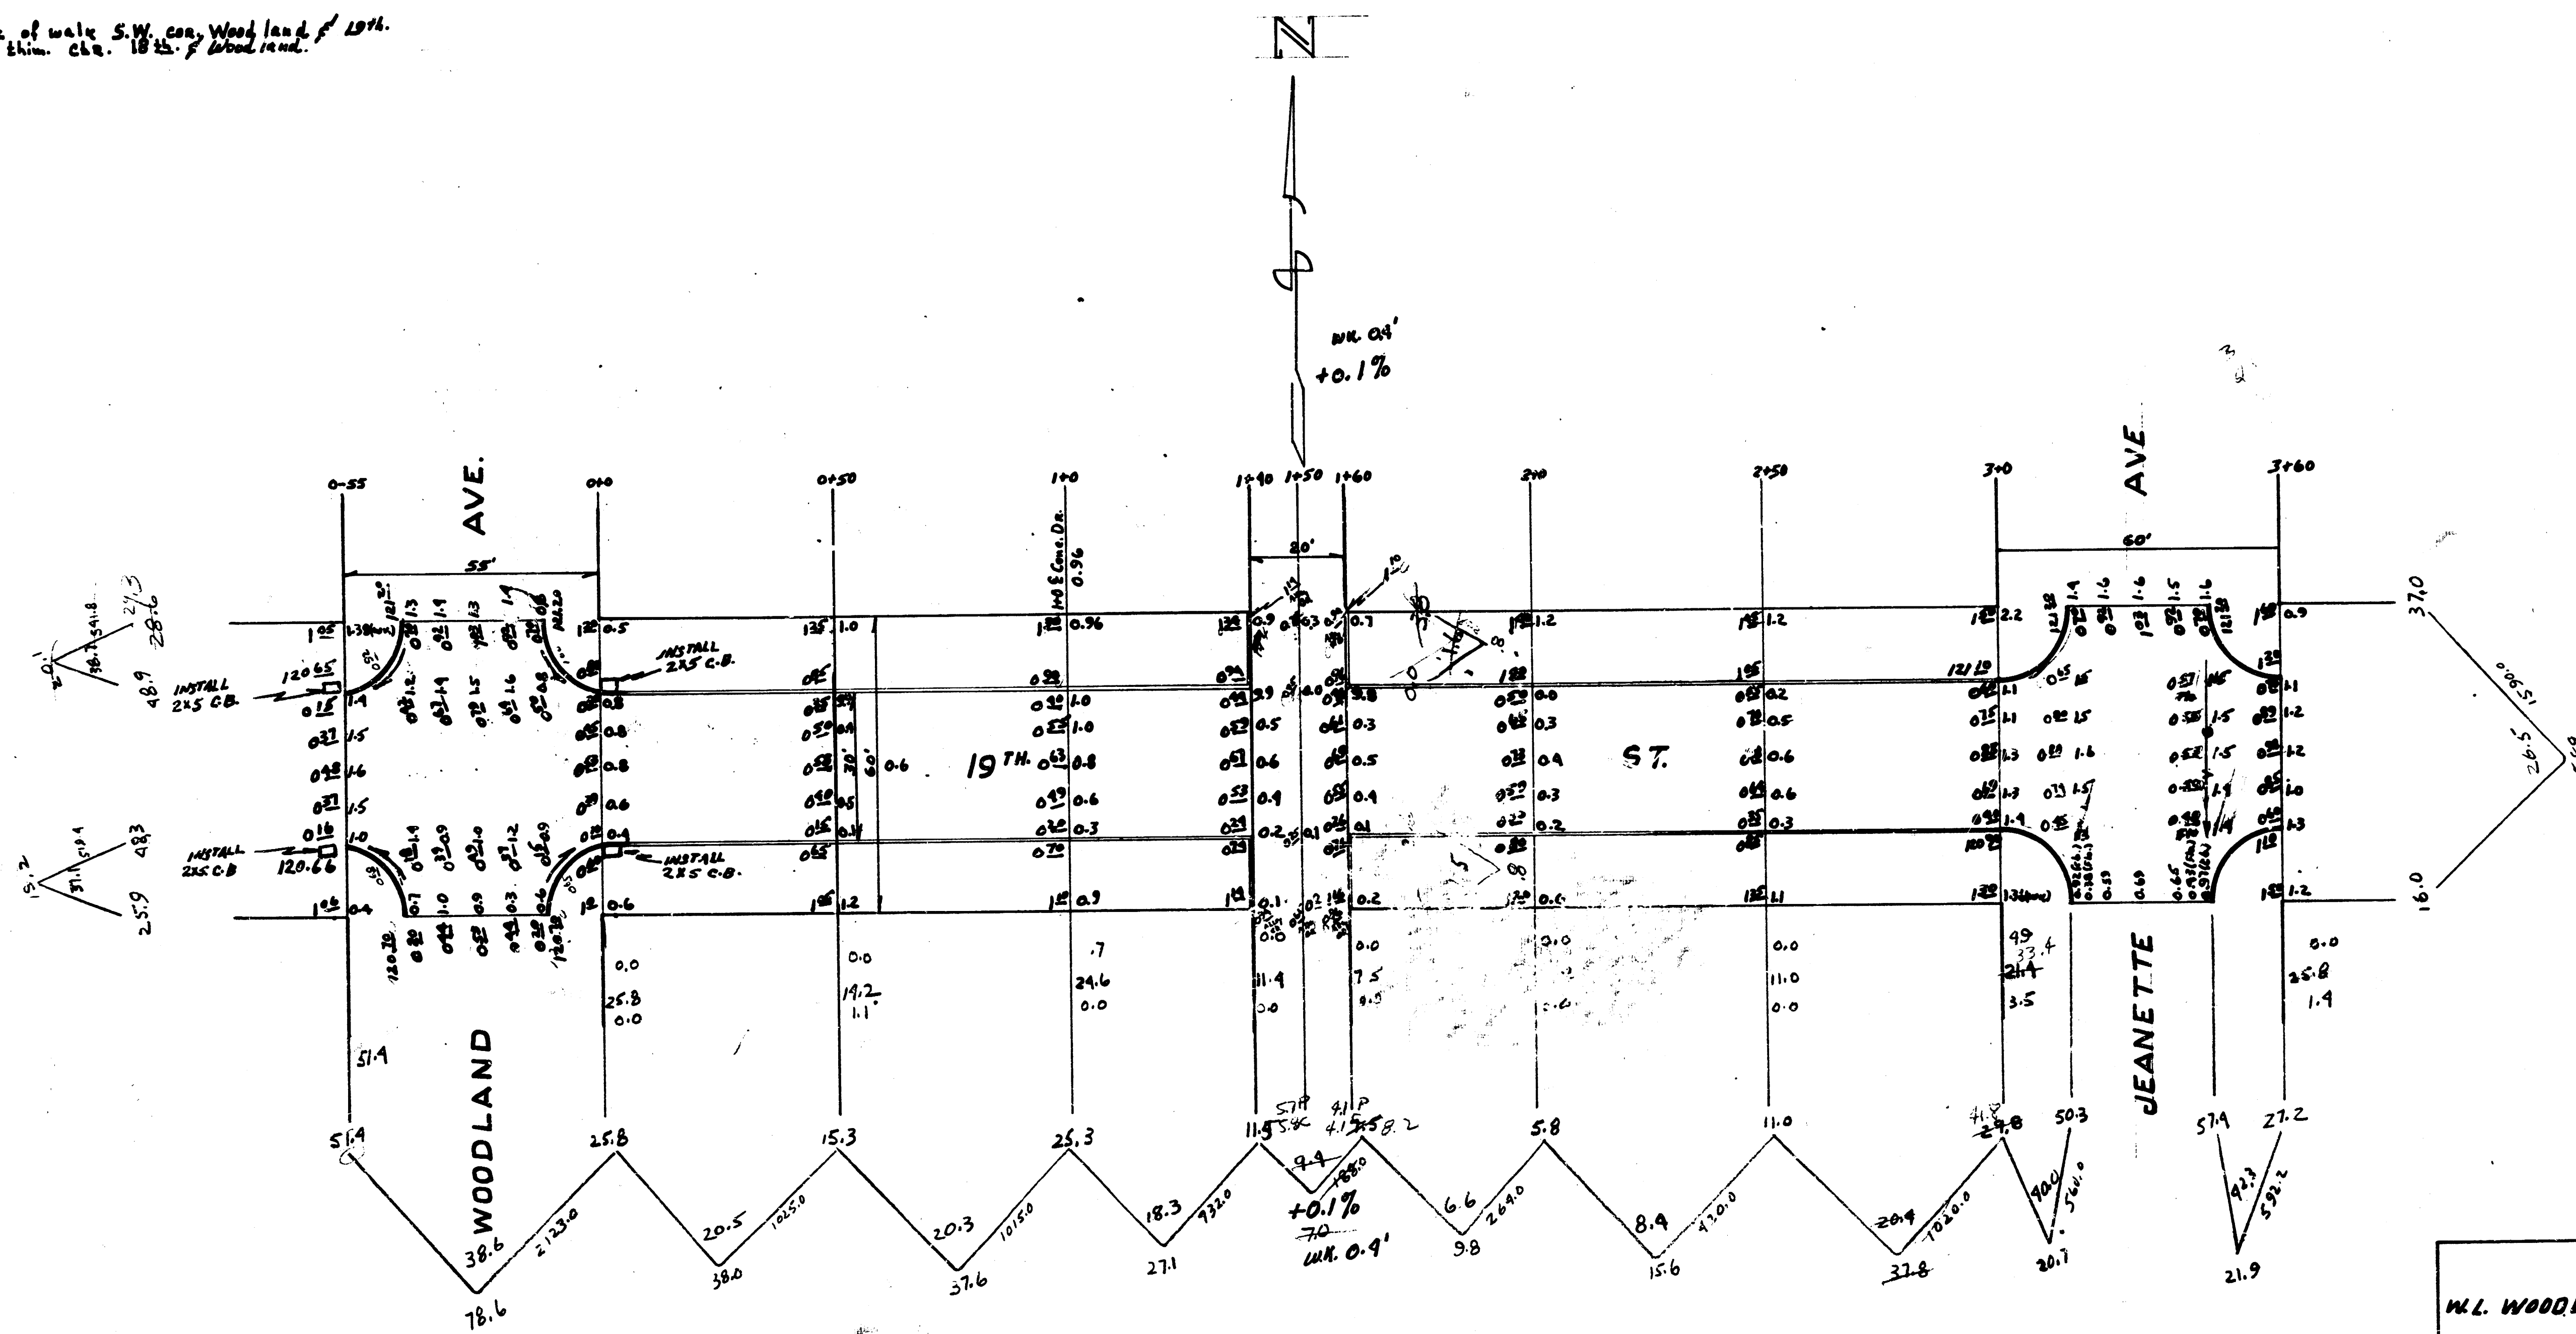

19TH ST.
 W.L. WOODLAND W.L. JEANETTE
 30' CONC. / CB
 CITY OF WICHITA, KANSAS
 L.K. WHITE CITY ENGINEER
 JULY, 1947

15 4 5


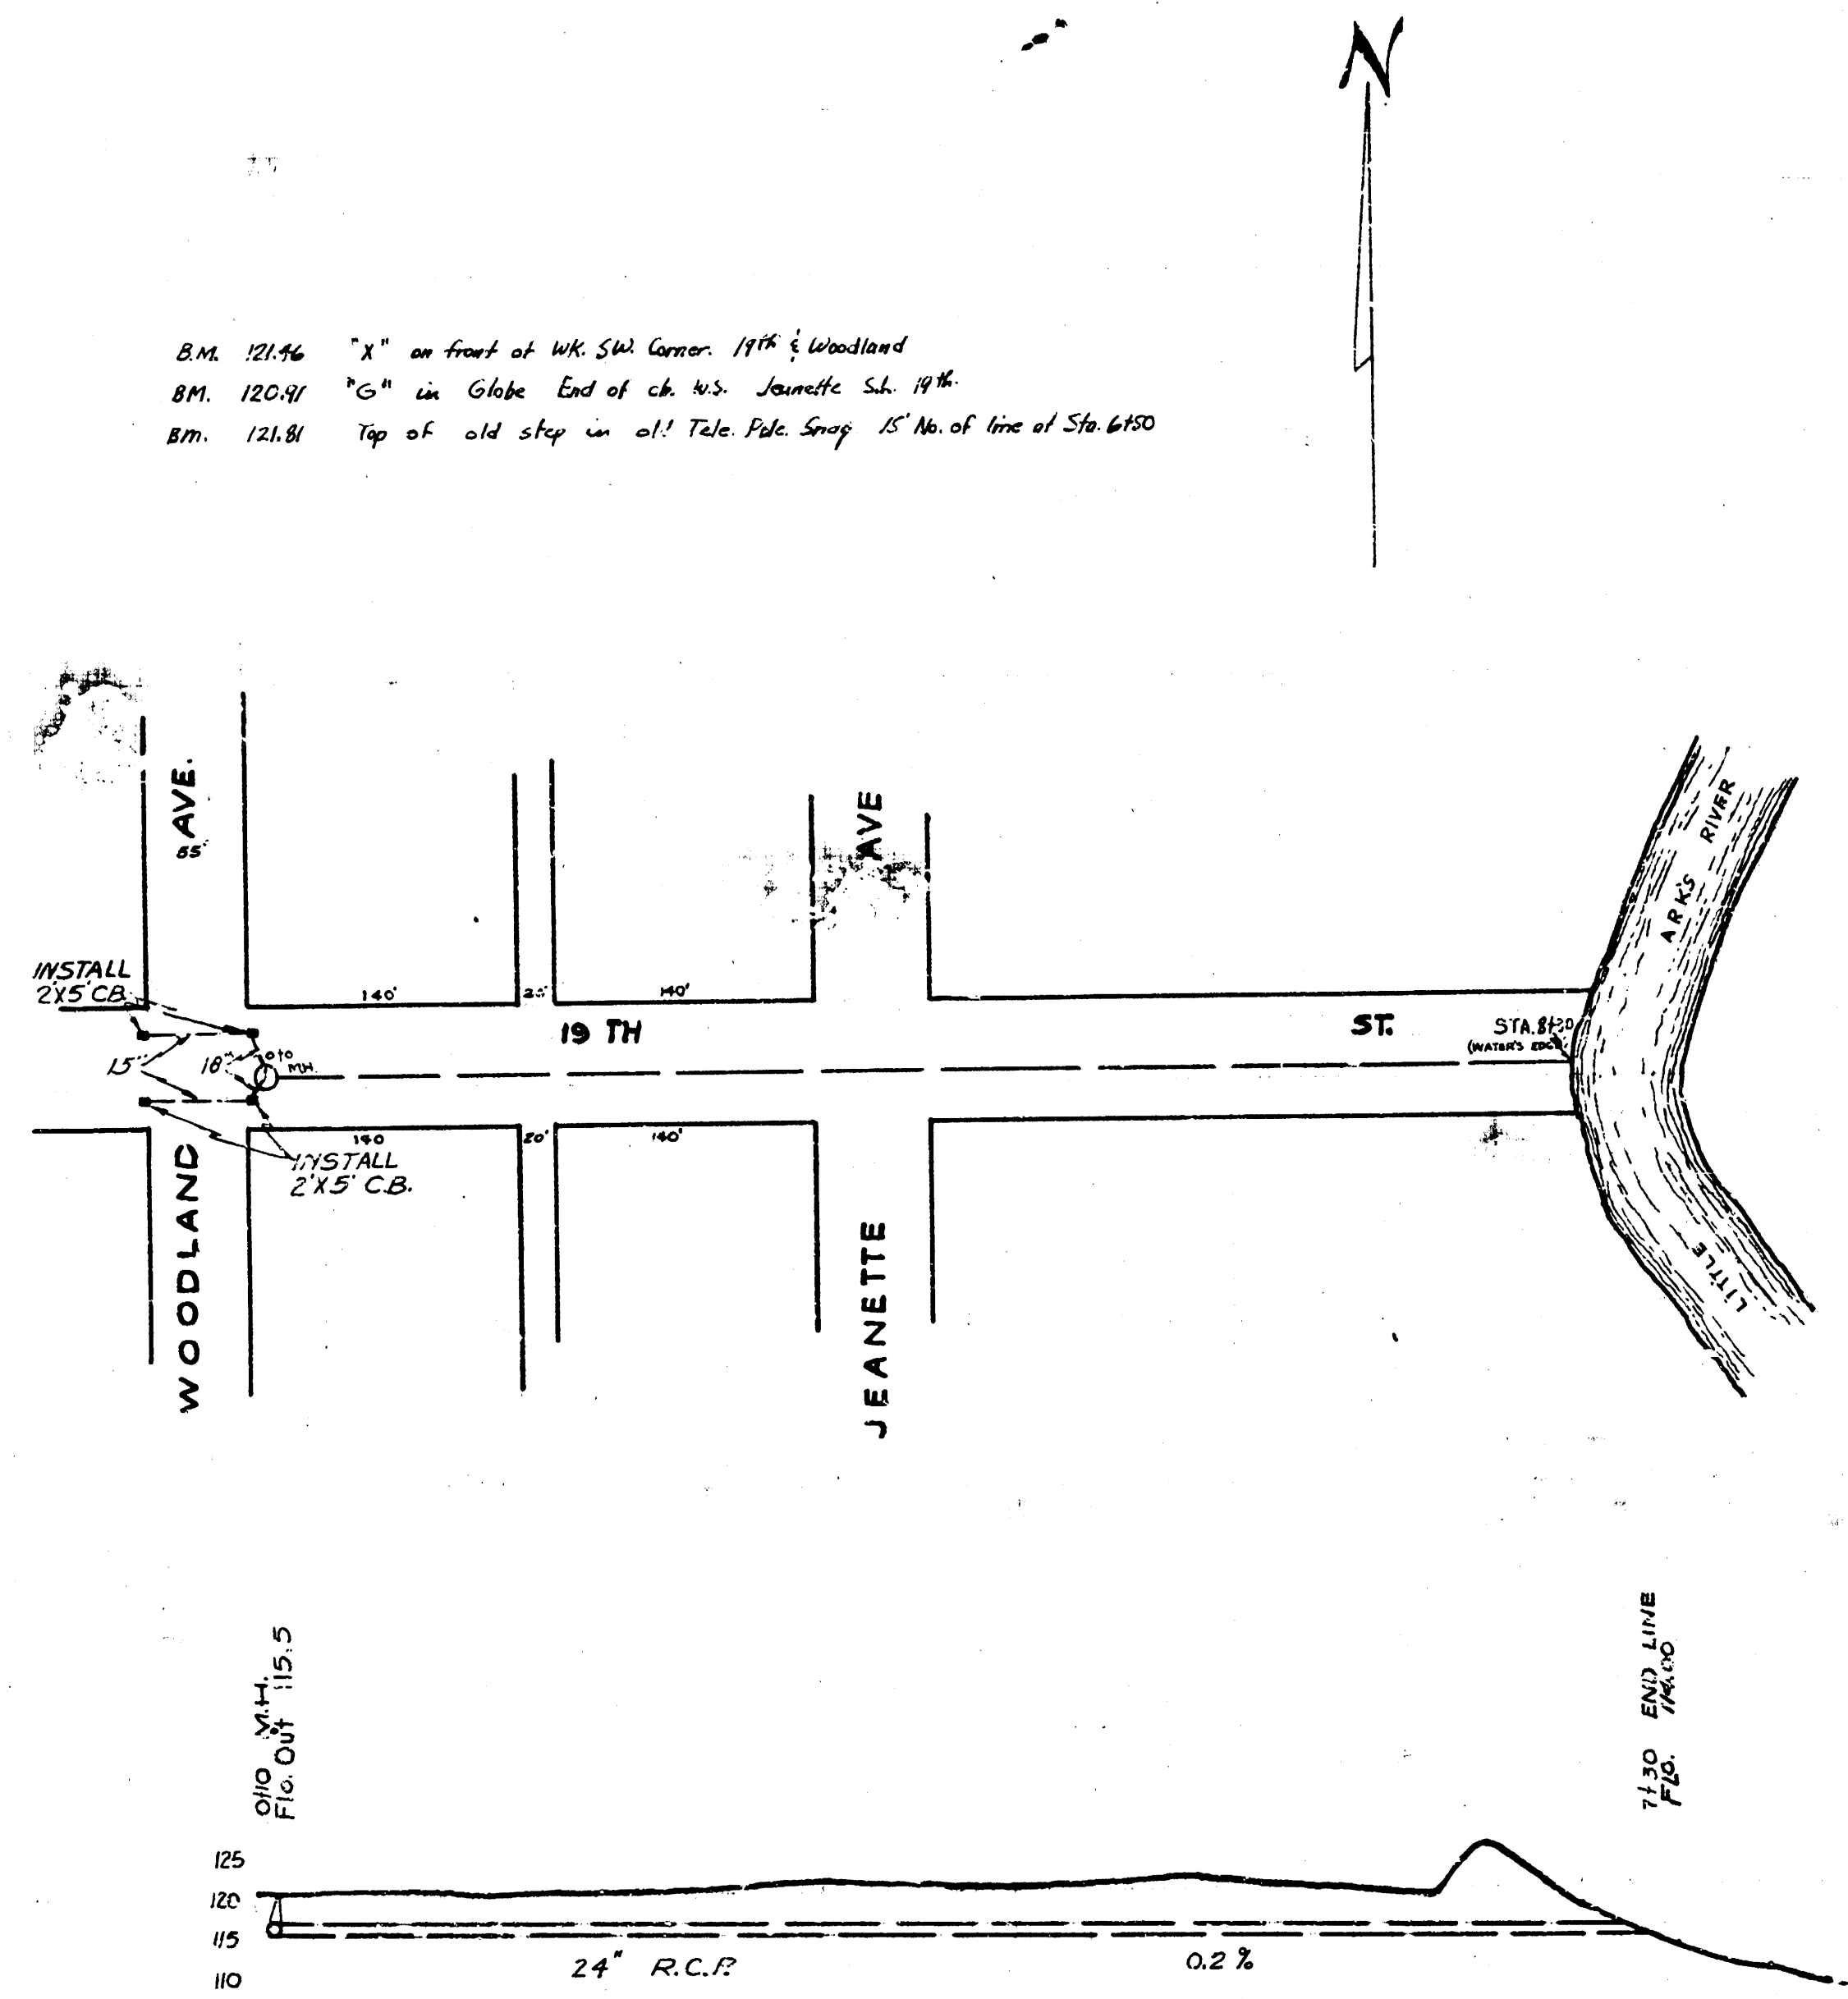

INCIDENTAL DRAINAGE
 IN CONNECTION WITH PAVEMENT
 19th ST - WOODLAND TO JEANETTE