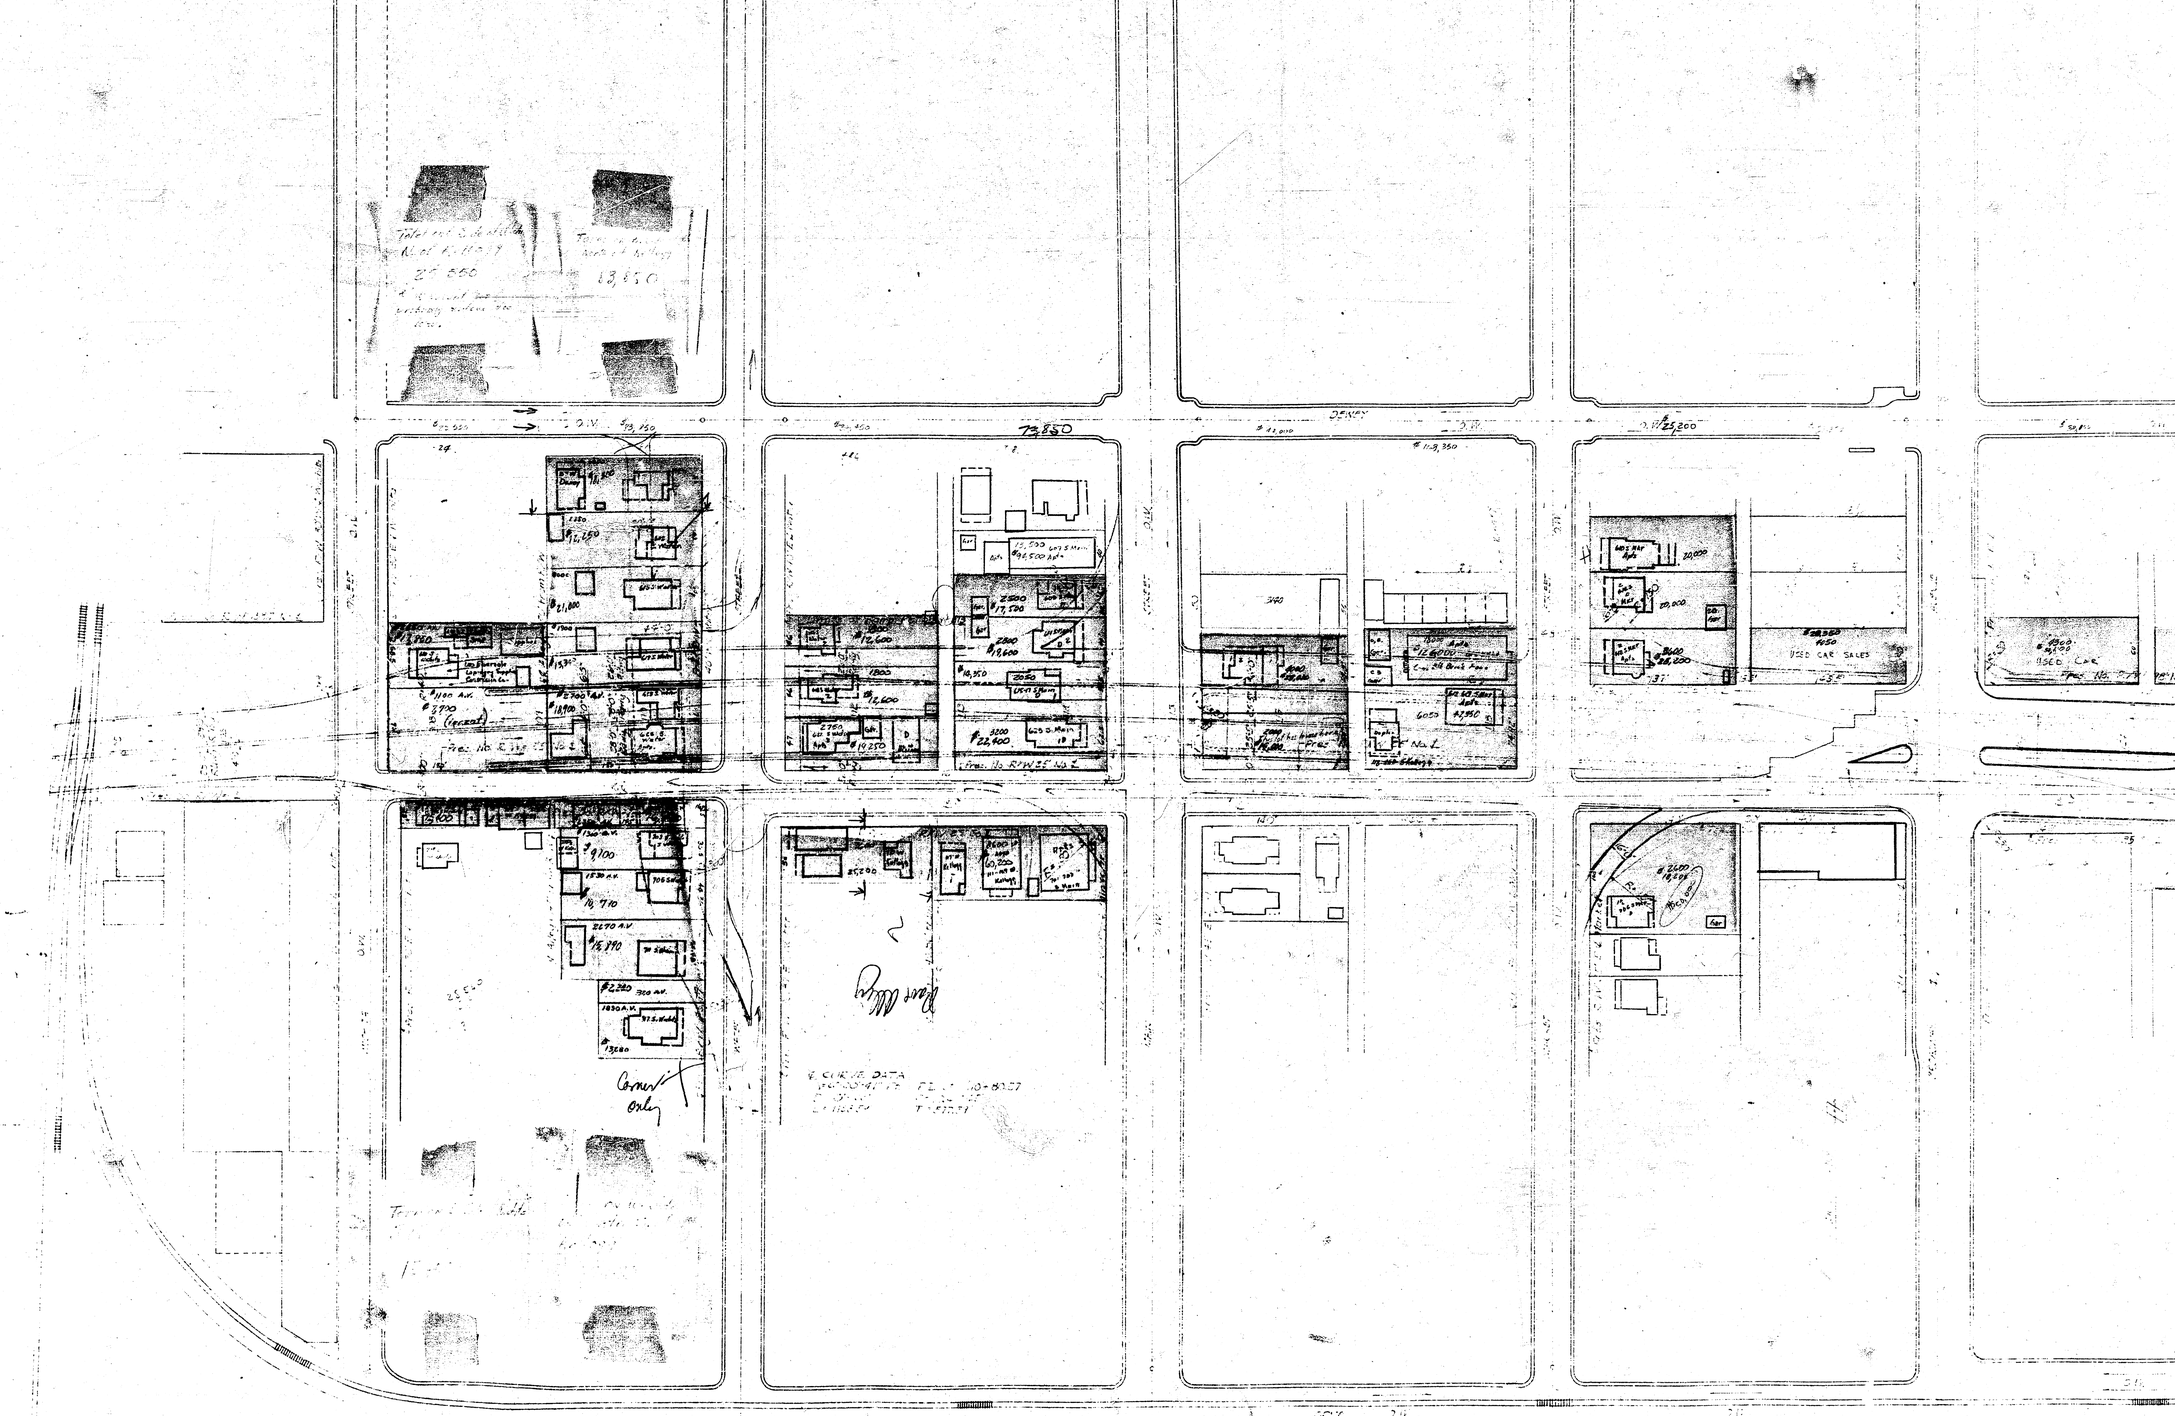


73,850
Corner Only


USED CAR SALES
137550