


B.M. 12454 C in Center S.S. of 24 S.W. Cor. Park Place & 22nd

Prop	Sta
29.4	9.4
29.8	9.1
35.1	11.8
35.0	6.1
14.1	7.7
46.4	7.6
48.0	13.9
40.6	18.0
40.0	15.2
38.5	152.9
	1000
393.6	183.2
109%	183.2
433.0 cu yds	

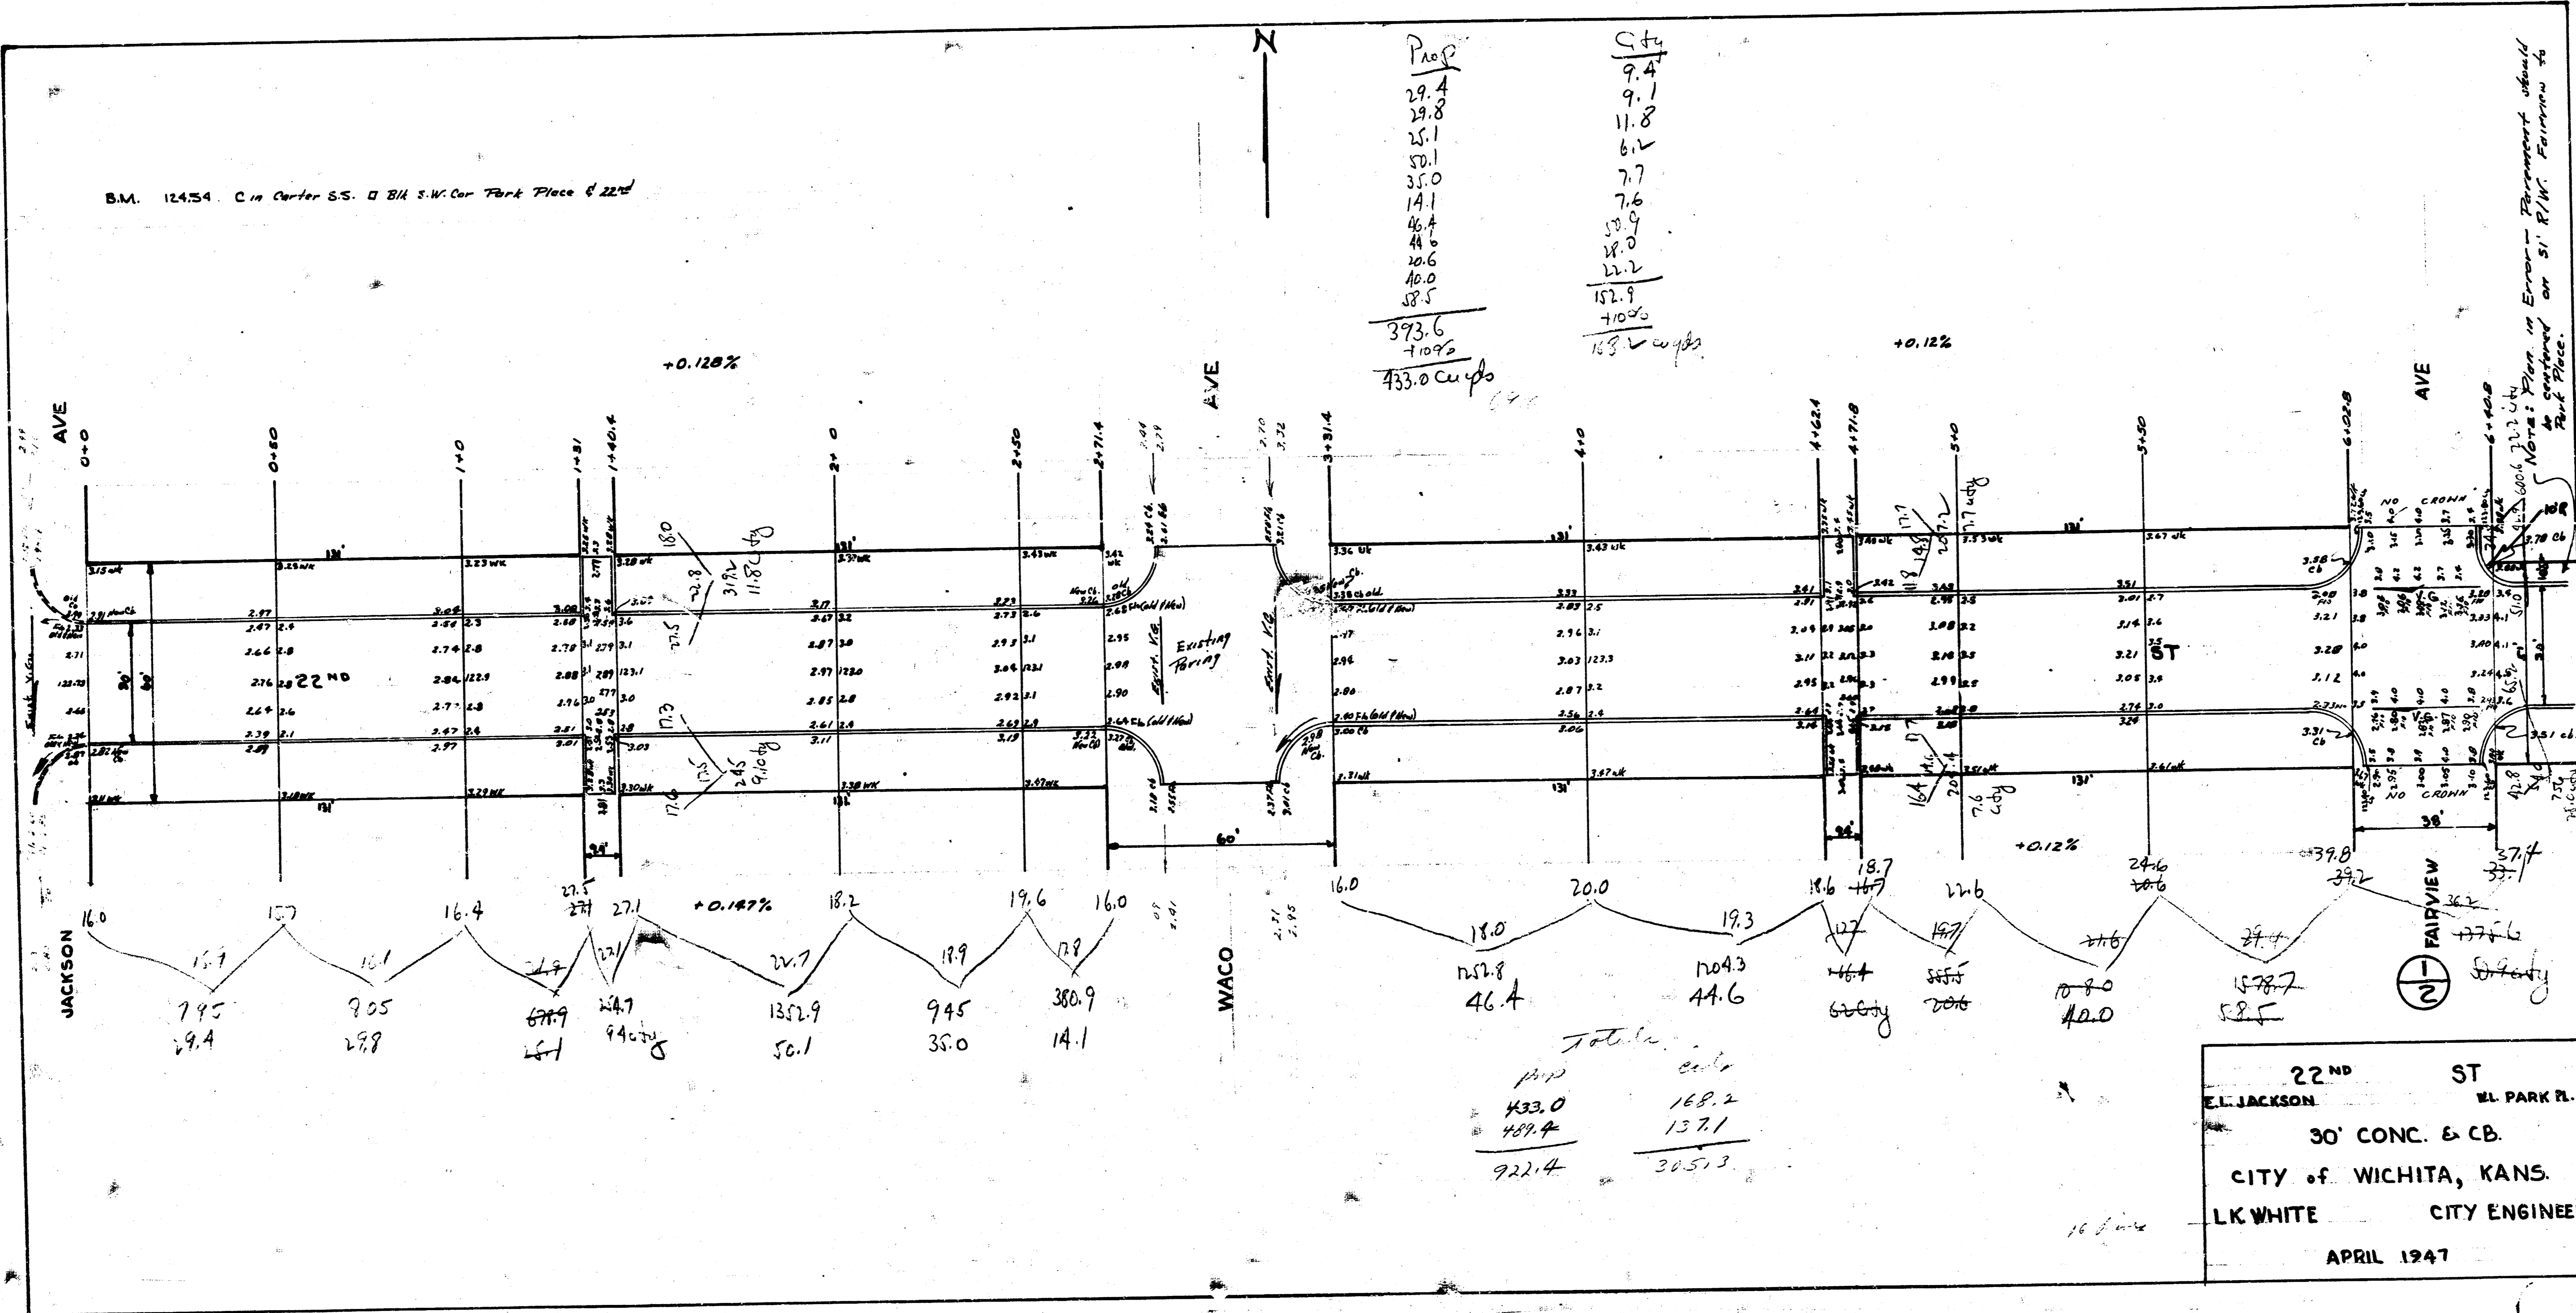

22ND ST
 E.L. JACKSON BL. PARK PL.
 30' CONC. & CB.
 CITY of WICHITA, KANS.
 L.K. WHITE CITY ENGINEER
 APRIL 1947

Total


Prop	Sta
433.0	168.2
922.4	305.3


B.M. 124.54 C. in Carter S.S. □ Bit S.W. Cor. Park Place & 22nd

NOTE:

PLAN IN ERROR - PAVEMENT IS TO BE CENTERED ON S1'R/W.

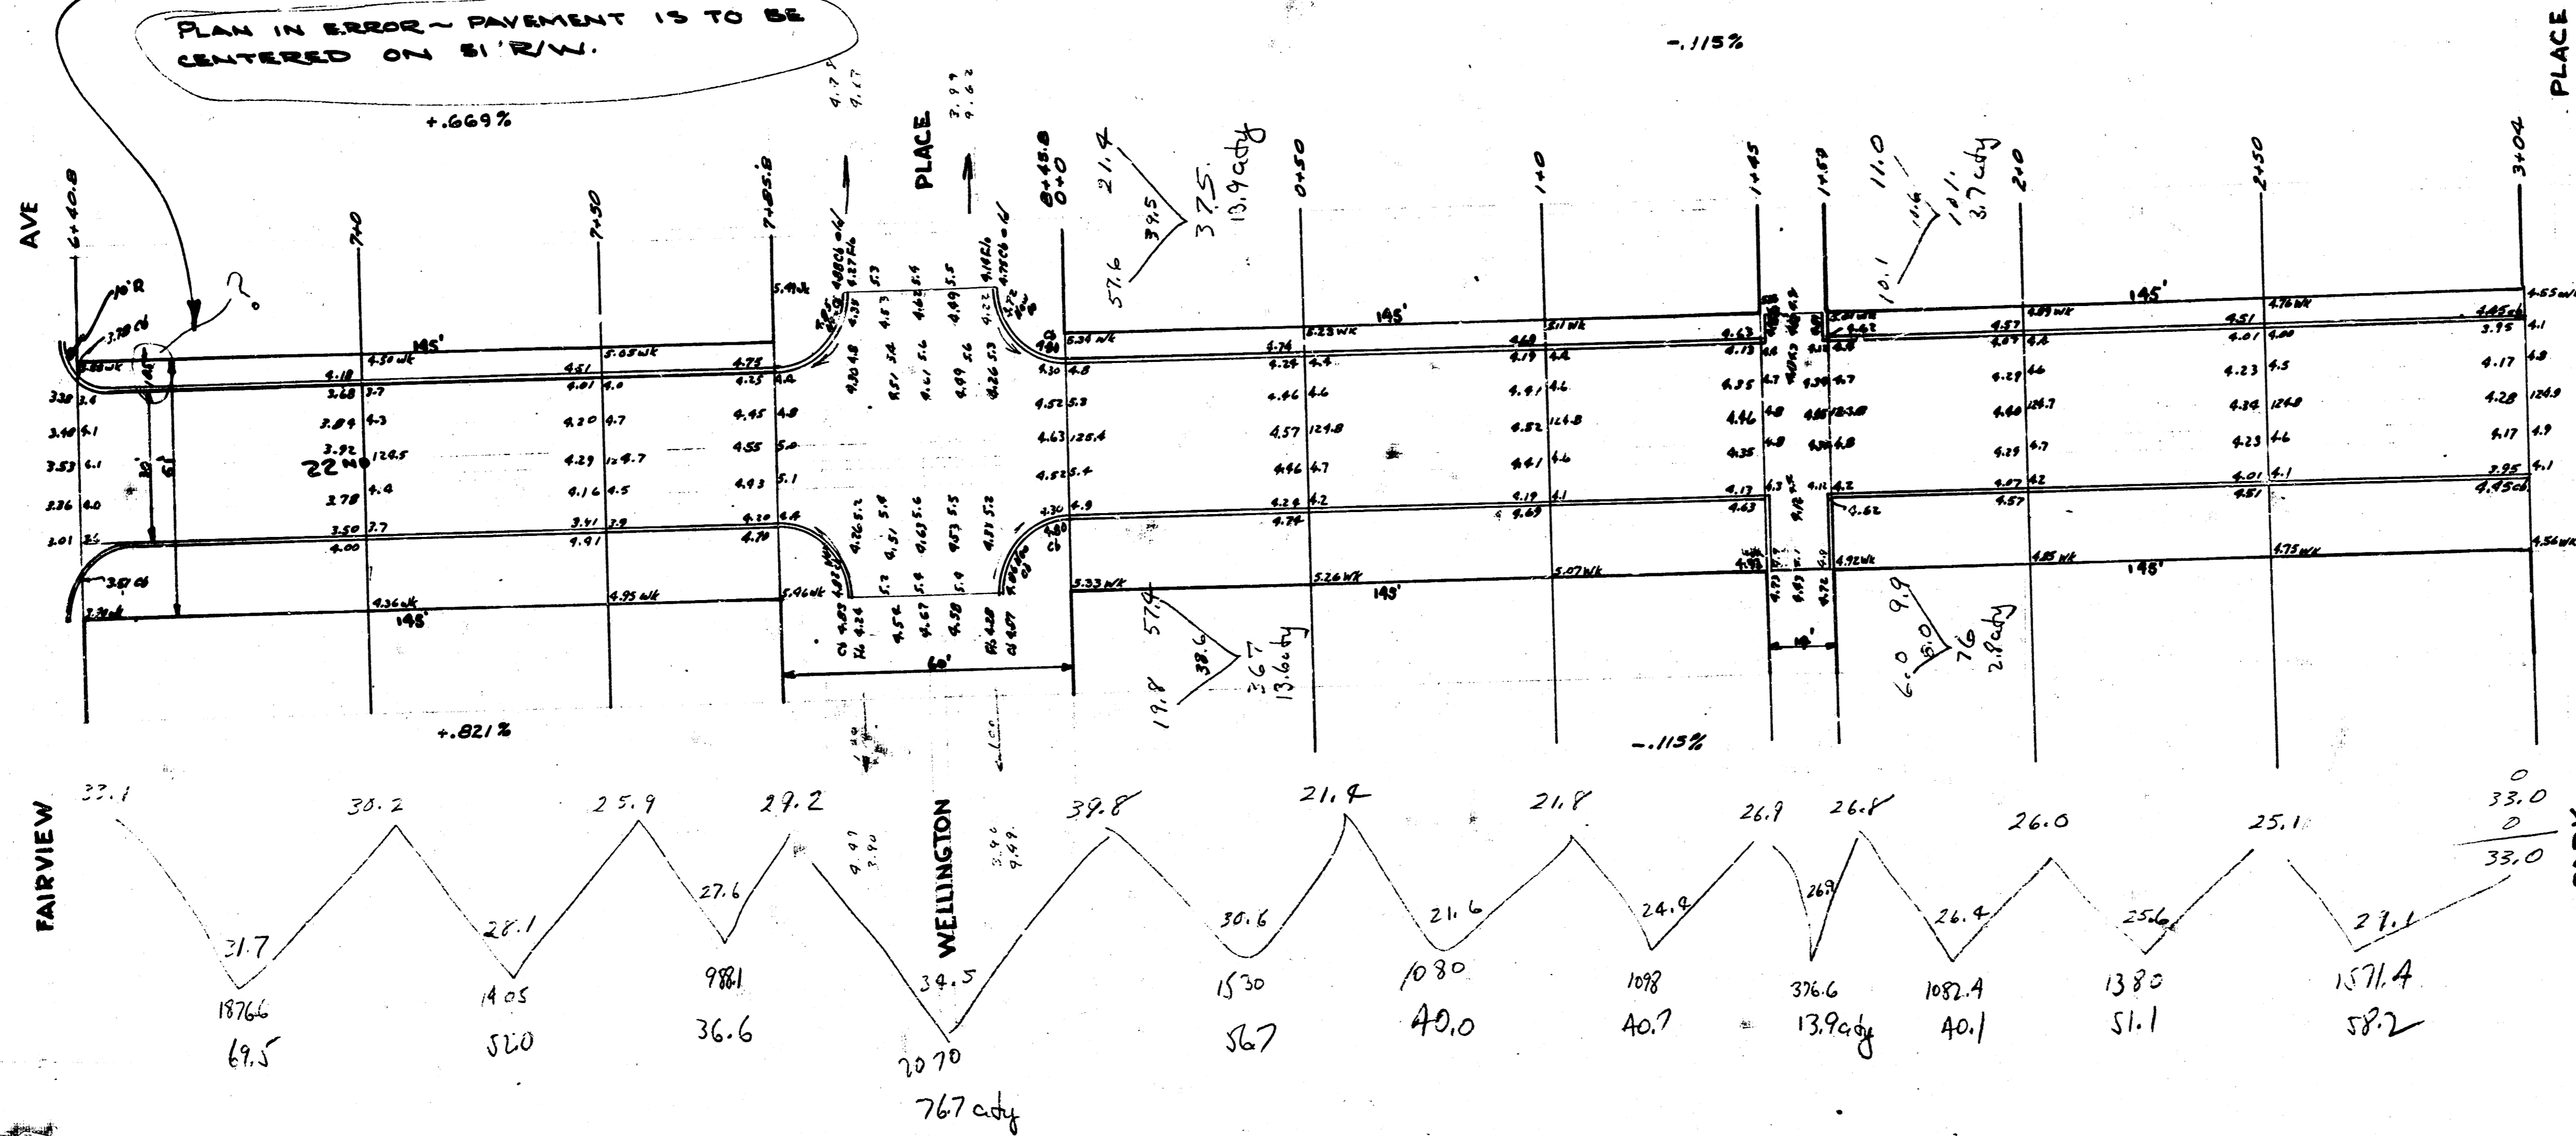

PAV	CH
686	76.7
510	13.9
366	13.6
36.7	2.8
40.0	3.7
40.7	12.6
40.1	71.0%
51.1	137.1 ady
58.2	
444.9	
710%	
489.4 w/pts	

2/2

101 12