


B71 12383 NE COR WALK 6' N. HOUSE "1701 SE HYDRAULIC - 22nd
 8" H. 126.14" T IN TROY TOP FIRE HYDRANT SE. KANSAS + 22nd

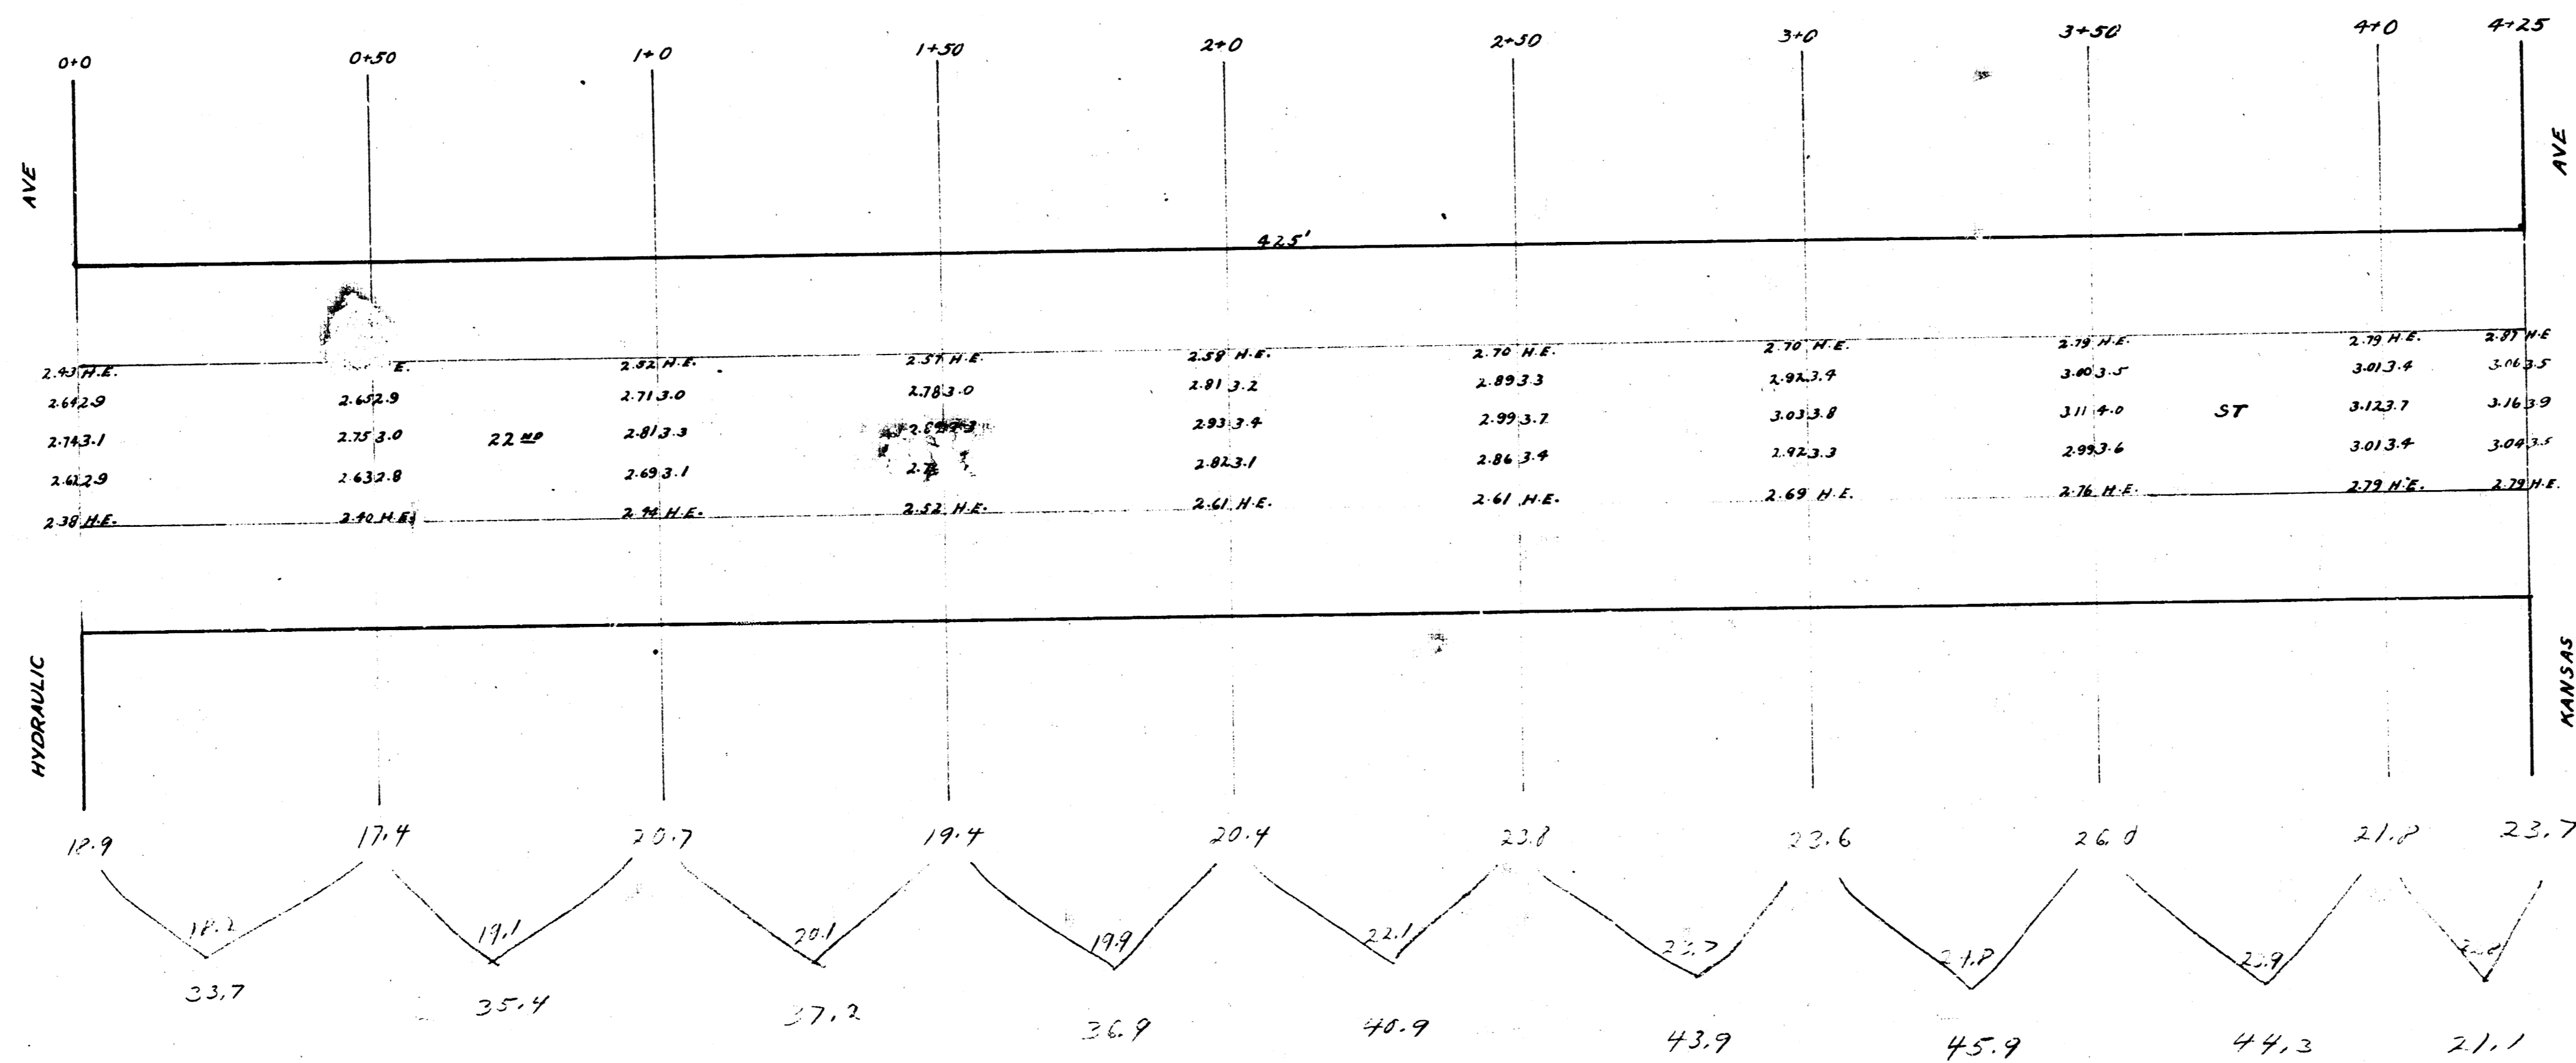


INTERSECTION ON
KANSAS PLAN

33.7
 35.4
 37.2
 36.9
 48.9
 43.9
 45.9
 44.2
 21.1
 339.3
 22.7
 573.2

22nd ST.
 E.L. HYDRAULIC W.L. MINNESOTA
 26' CONC.
 CITY OF WICHITA, KANS.
 L.K. WHITE, CITY ENGINEER
 APRIL 1946

B.P. 125.41 T IN TROY TOP FIRE HYDRANT S.E. COR. 22ND + MINNESOTA

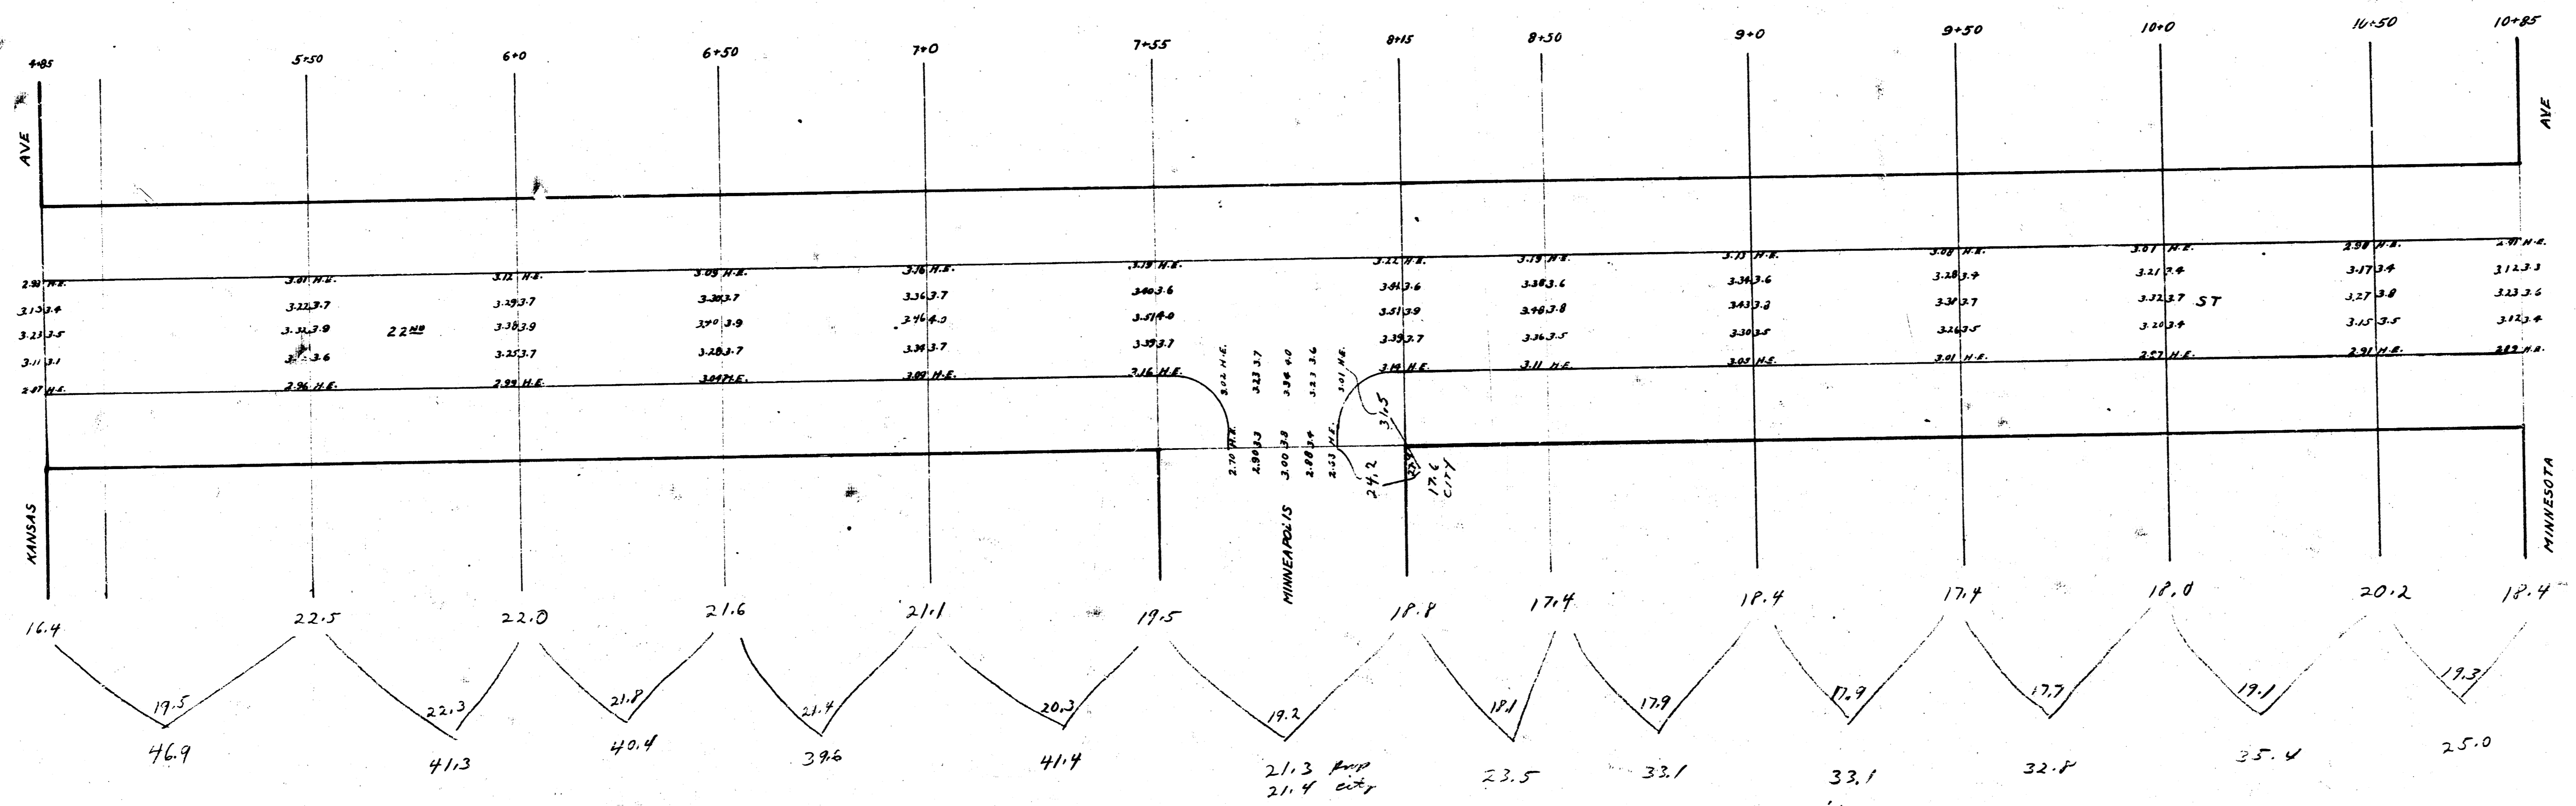

46.9
 41.3
 40.4
 39.6
 41.4
 21.3
 21.4
 23.5
 33.1
 33.1
 32.4
 35.4
 25.0
 41.3
 45.5