



B. M. 97.605 U. S. G. S. Standard SW 1st of Meridian  
 Stationing and base line on North 12.

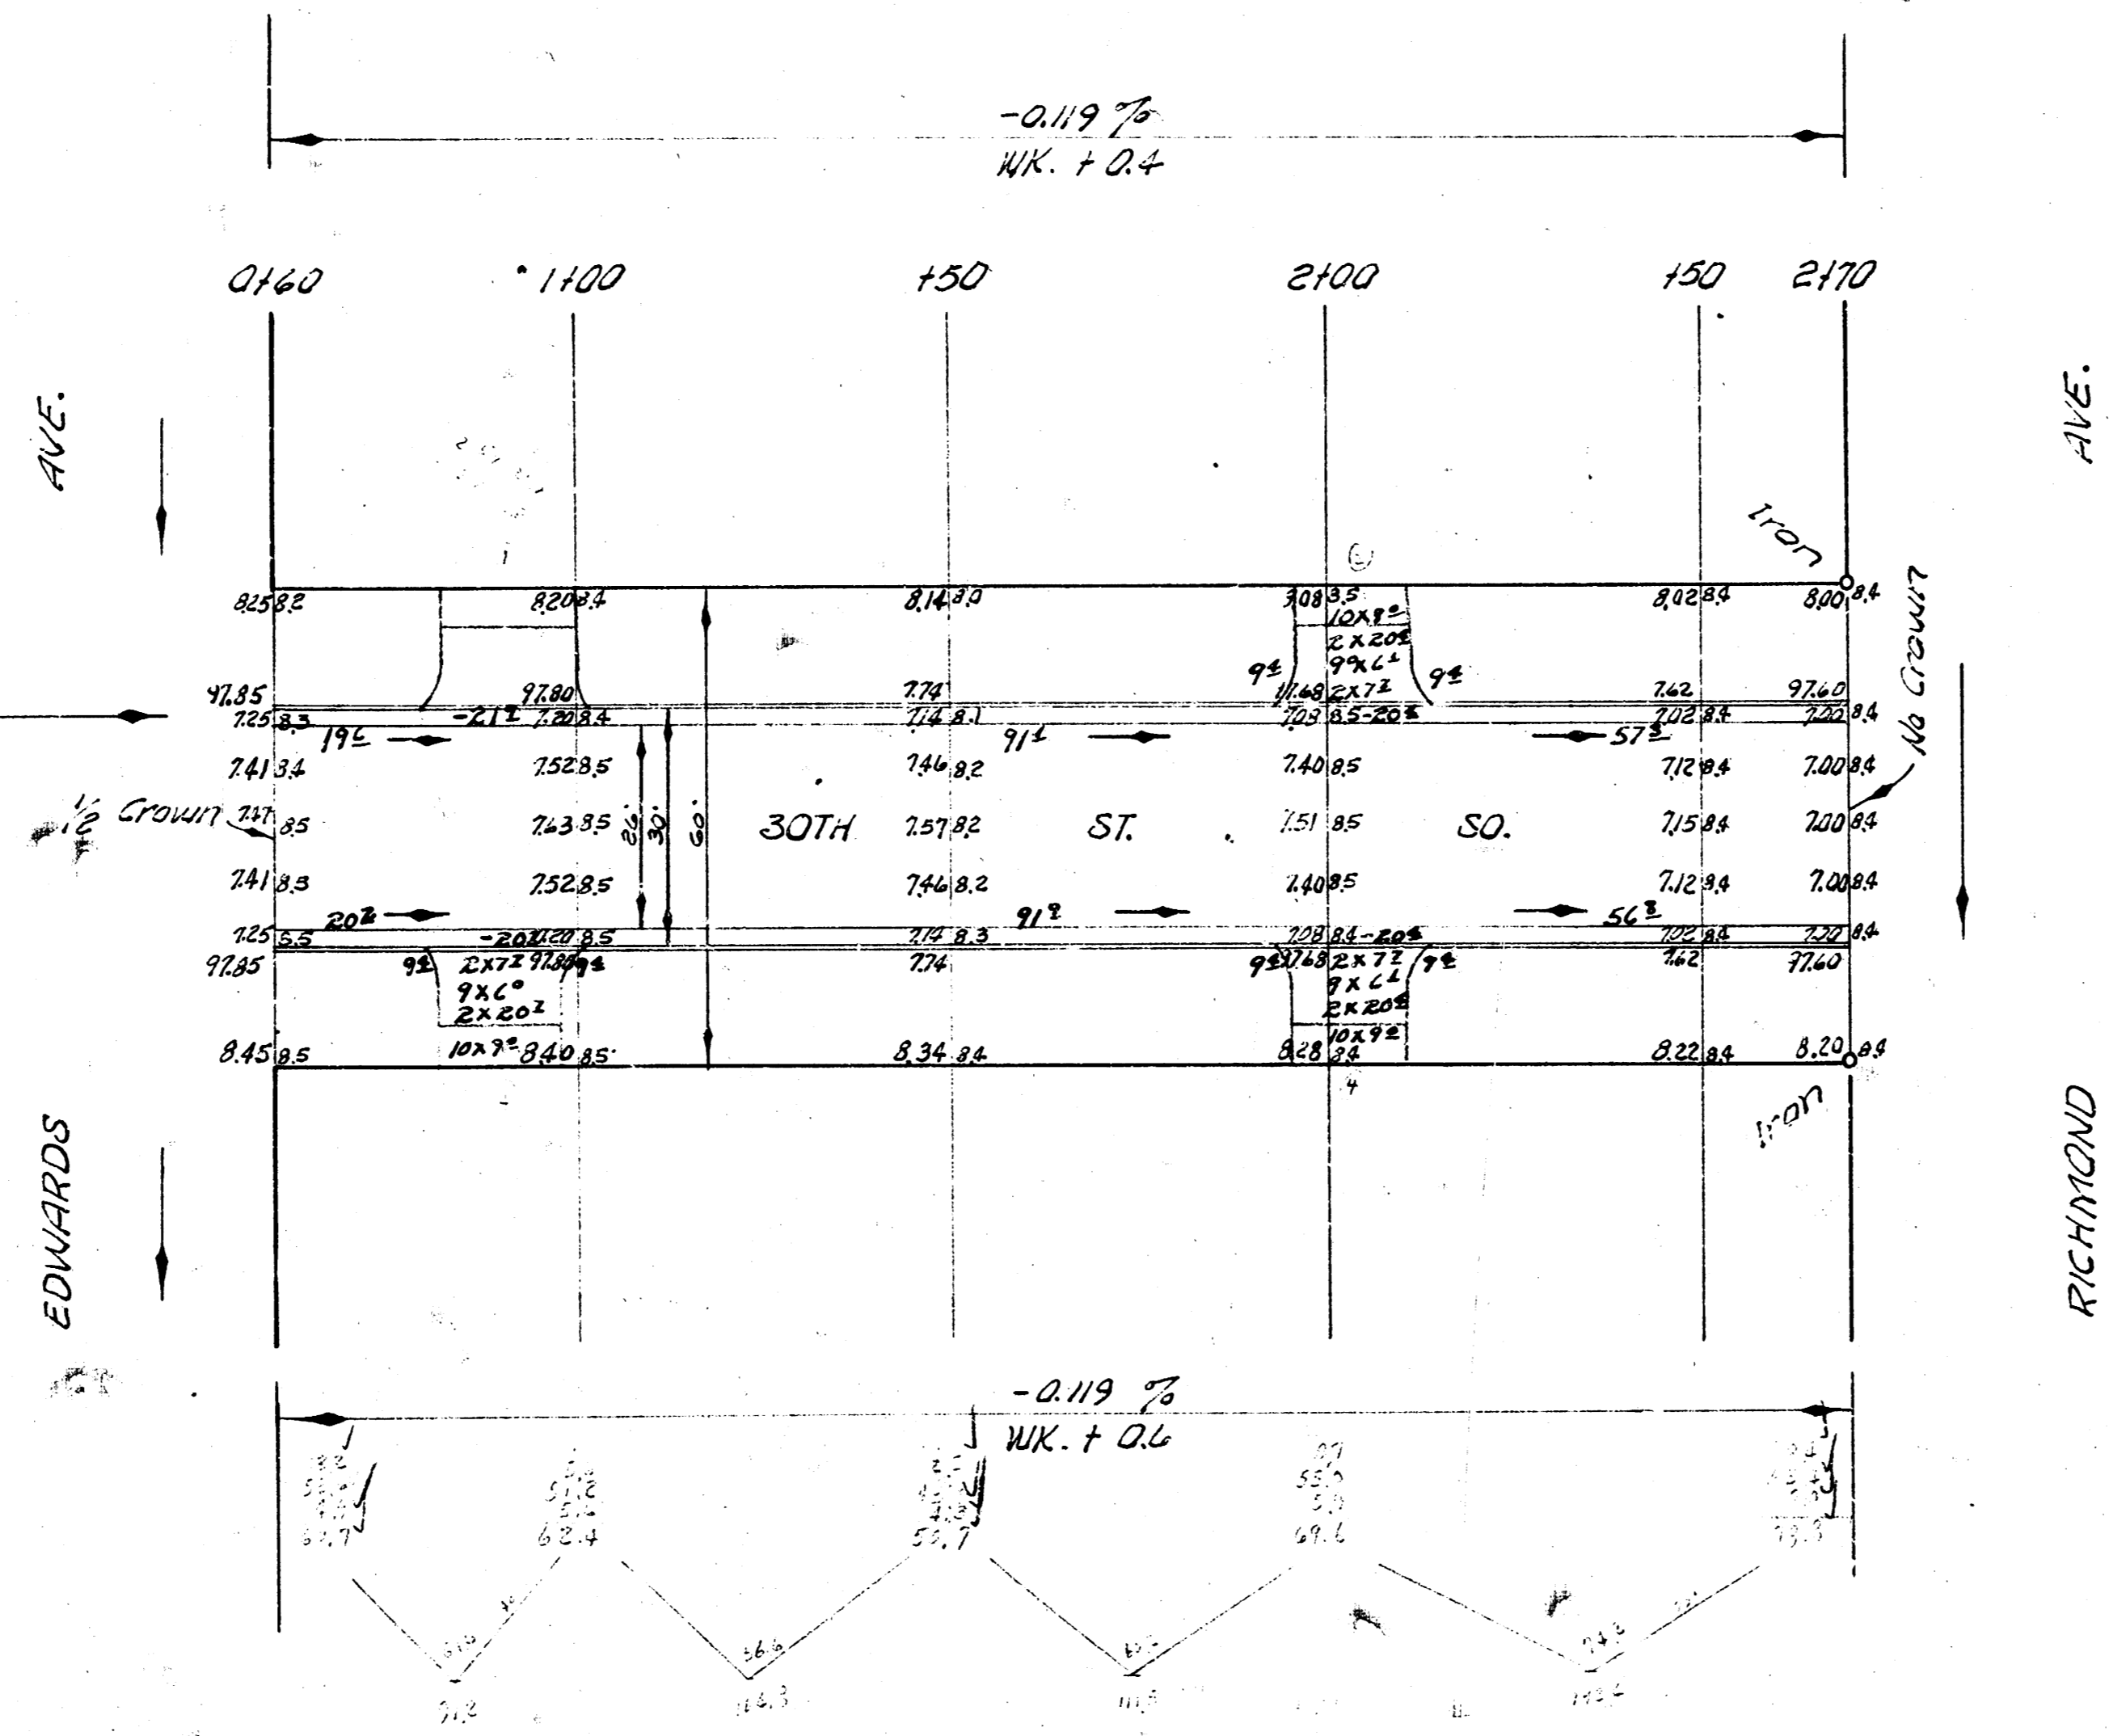

ESTIMATE OF QUANTITIES			
QUANTITY	UNIT	ITEM	FINAL
2345.8	Sq. Yds.	Asphalt CONC.	2346.5
1545.7	Lin. Ft.	Comb. ch. & gtr.	1134.8
6382.8	Lbs.	Rein. Steel	6470
1809.6	Cu. Yds.	Excavation	1845.8
	Sq. Ft.	GUTTER	
	Sq. Ft.	6" DRIVE	


NOTE TO CONTRACTOR  
 This sheet will be furnished under  
 the supervision of the CITY ENGINEER  
 and conforming to the SPECIFICATIONS  
 of the CITY OF WICHITA. THE CON-  
 TRACTOR will reimburse the City of  
 Wichita for all cost of Engineering, Plans,  
 and Inspection.

EARTH WORK  
 EXCAVATION  
 1809.6 Cu. Yds.

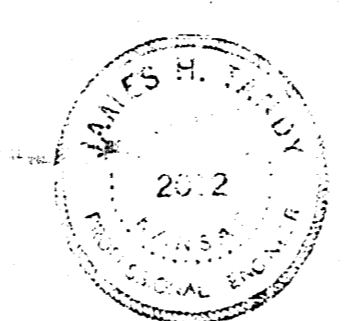

30TH ST. SO.  
 EL EDWARDS TO WL MERIDIAN  
 26' - 2" - 30' A. C.  
 CITY OF WICHITA, KANSAS  
 B. E. SMITH CITY ENGINEER  
 PRIVATE CONTRACT

B. M. 97.605 U. S. G. S. Standard SW 1st of Meridian.  
 Stationing and base line on South 1/2.

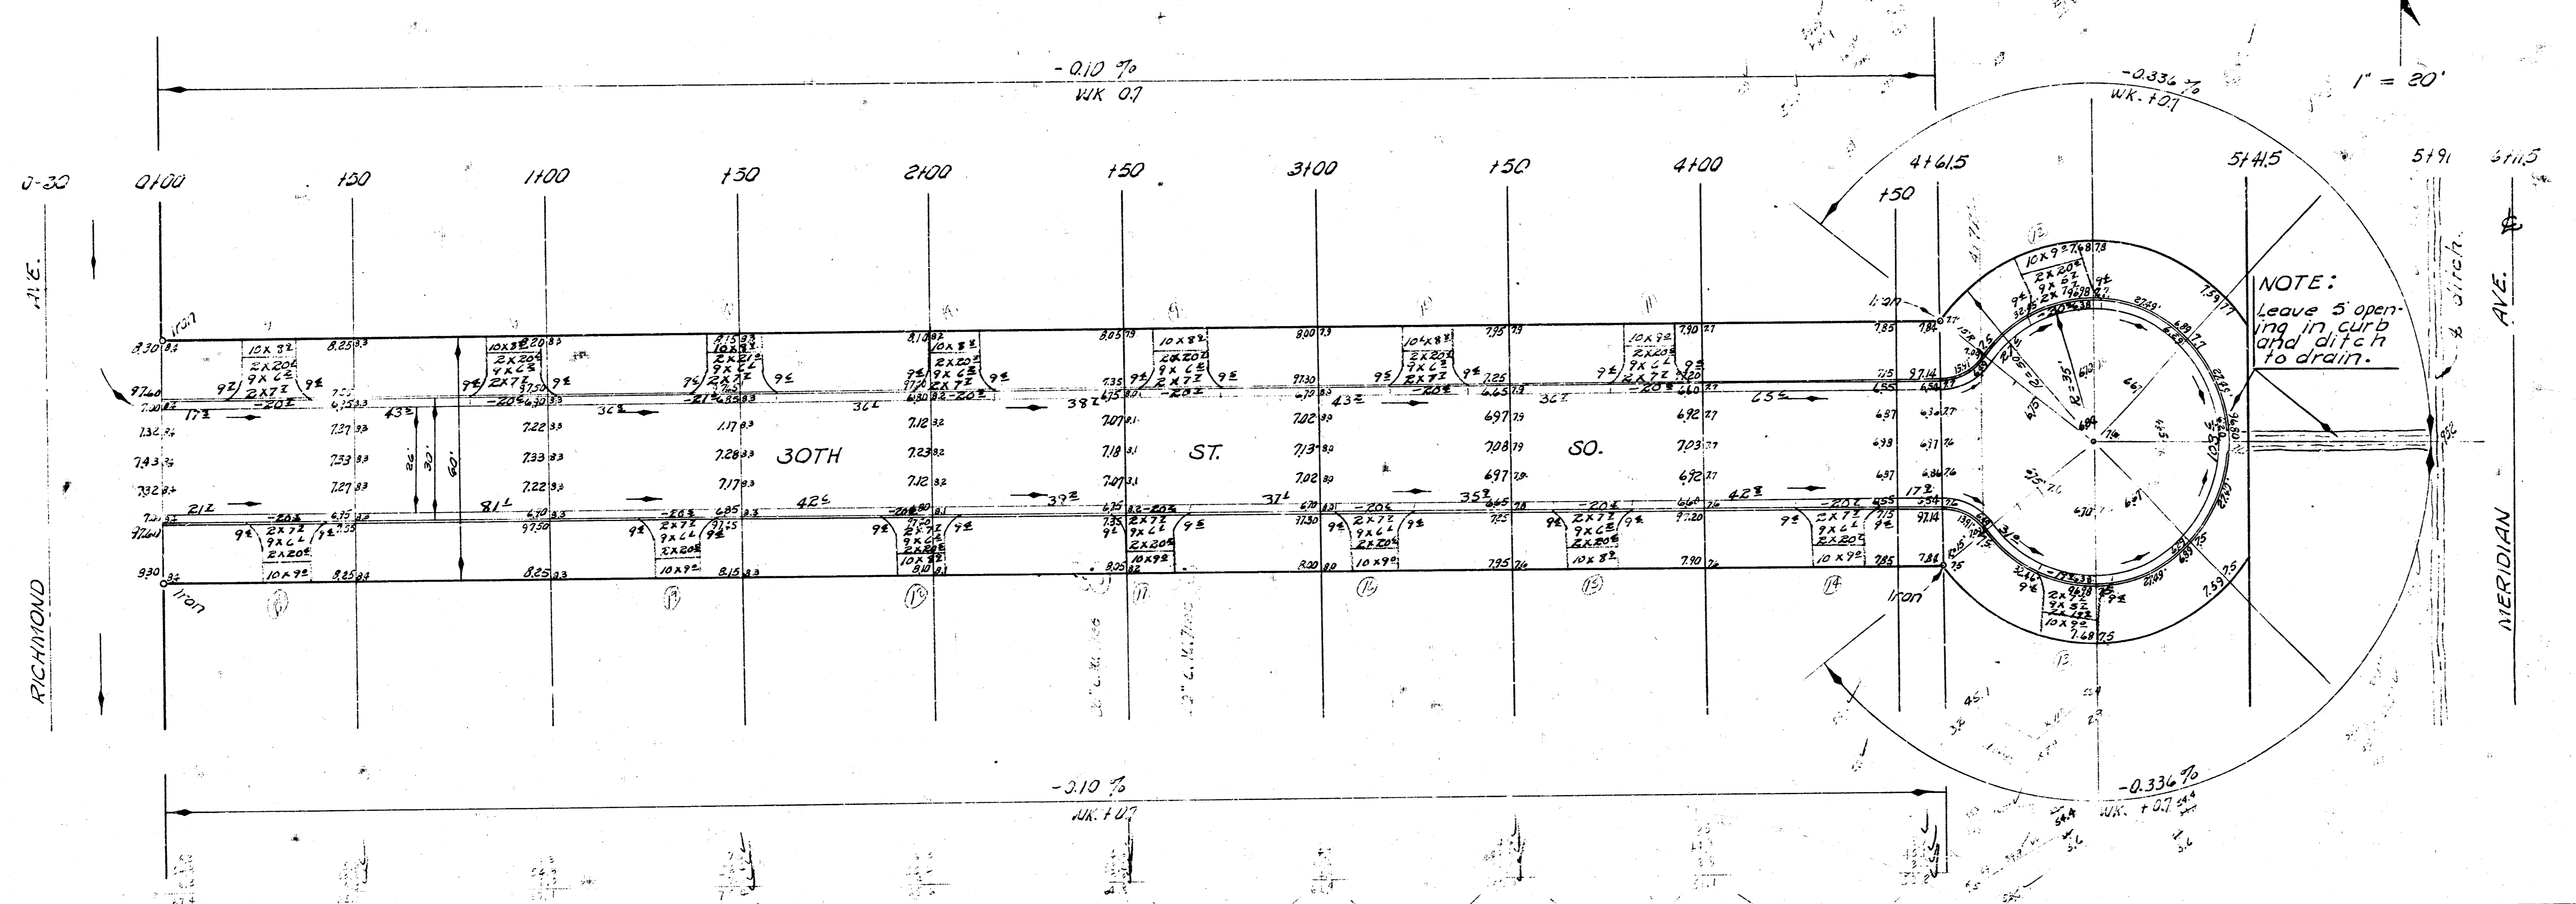

30TH ST. SO.  
 EDWARDS TO MERIDIAN  
 PRIVATE CONTRACT