
B.M. 98.10 "R" in Ritchie W. end Return NW cor. Mt. Carmel & 32nd St. So.
Bas. line of St. is N. 45° E.

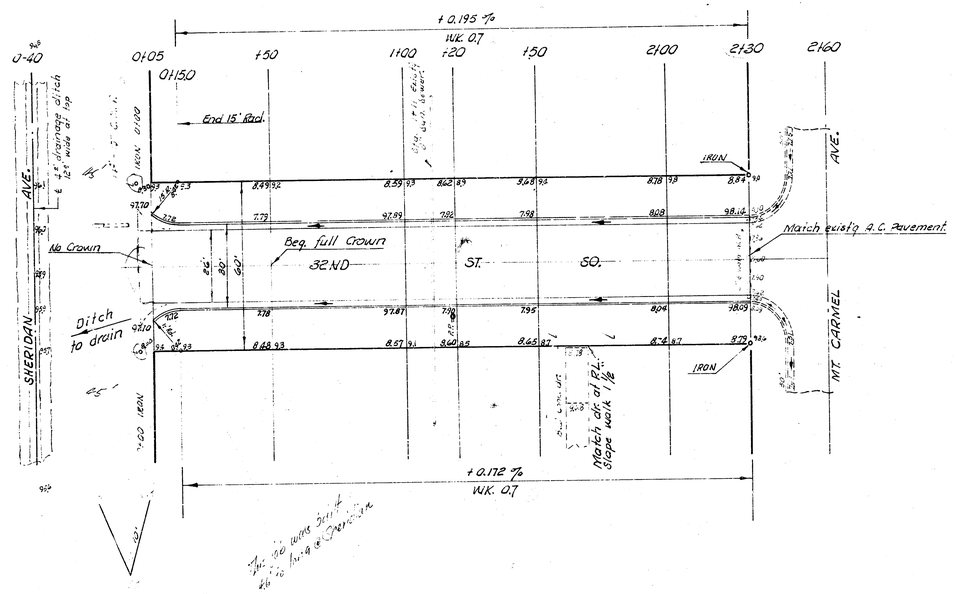

Earthwork
Excavation

Prop.	City
609.0	15.3
60.9	15
669.9 cu. yds.	16.8 cu. yds.

32ND. ST. SO.
EL. SHERIDAN TO W. MT. CARMEL
26'-2'-30' A.C.

1/2