B.M. 98.10 "R" in Ritchie W. end Return NW cor. Mt. Carmel & 32nd St. So.
Bas.line & Sta. on N. Rt.

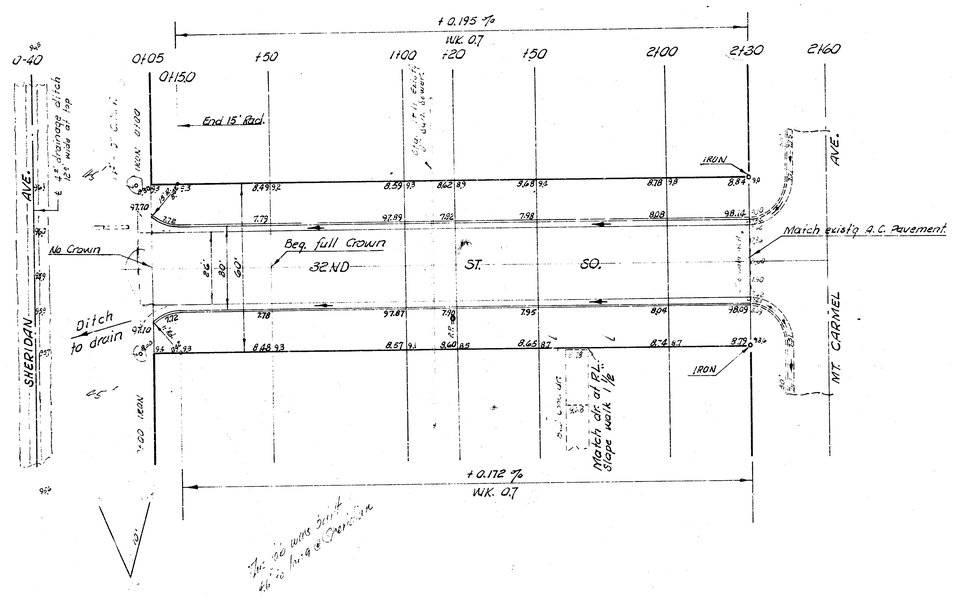

Earthwork
Excavation

Prop.	City
609.0	15.3
60.9	15
669.9 cu. yds	16.8 cu. yds.

32ND. ST. SO.
EL. SHERIDAN TO EL. MT. CARMEL
26'-2"-30' A.C.
B. E. SMITH CITY ENGINEER
SEPT. 1940, PROJ. 013-110

1/2