
AMARADO ESTATES
4TH ADDITION

WICHITA, SEDGWICK COUNTY, KANSAS

PART OF LOT 1, BLOCK 1, AMARADO ESTATES AN ADDITION TO WICHITA, SEDGWICK COUNTY, KANSAS.

R & S INVESTMENTS, A KANSAS PARTNERSHIP
LESLIE FUDD
2416 E 37TH ST NO
WICHITA, KS 67219
838-7707

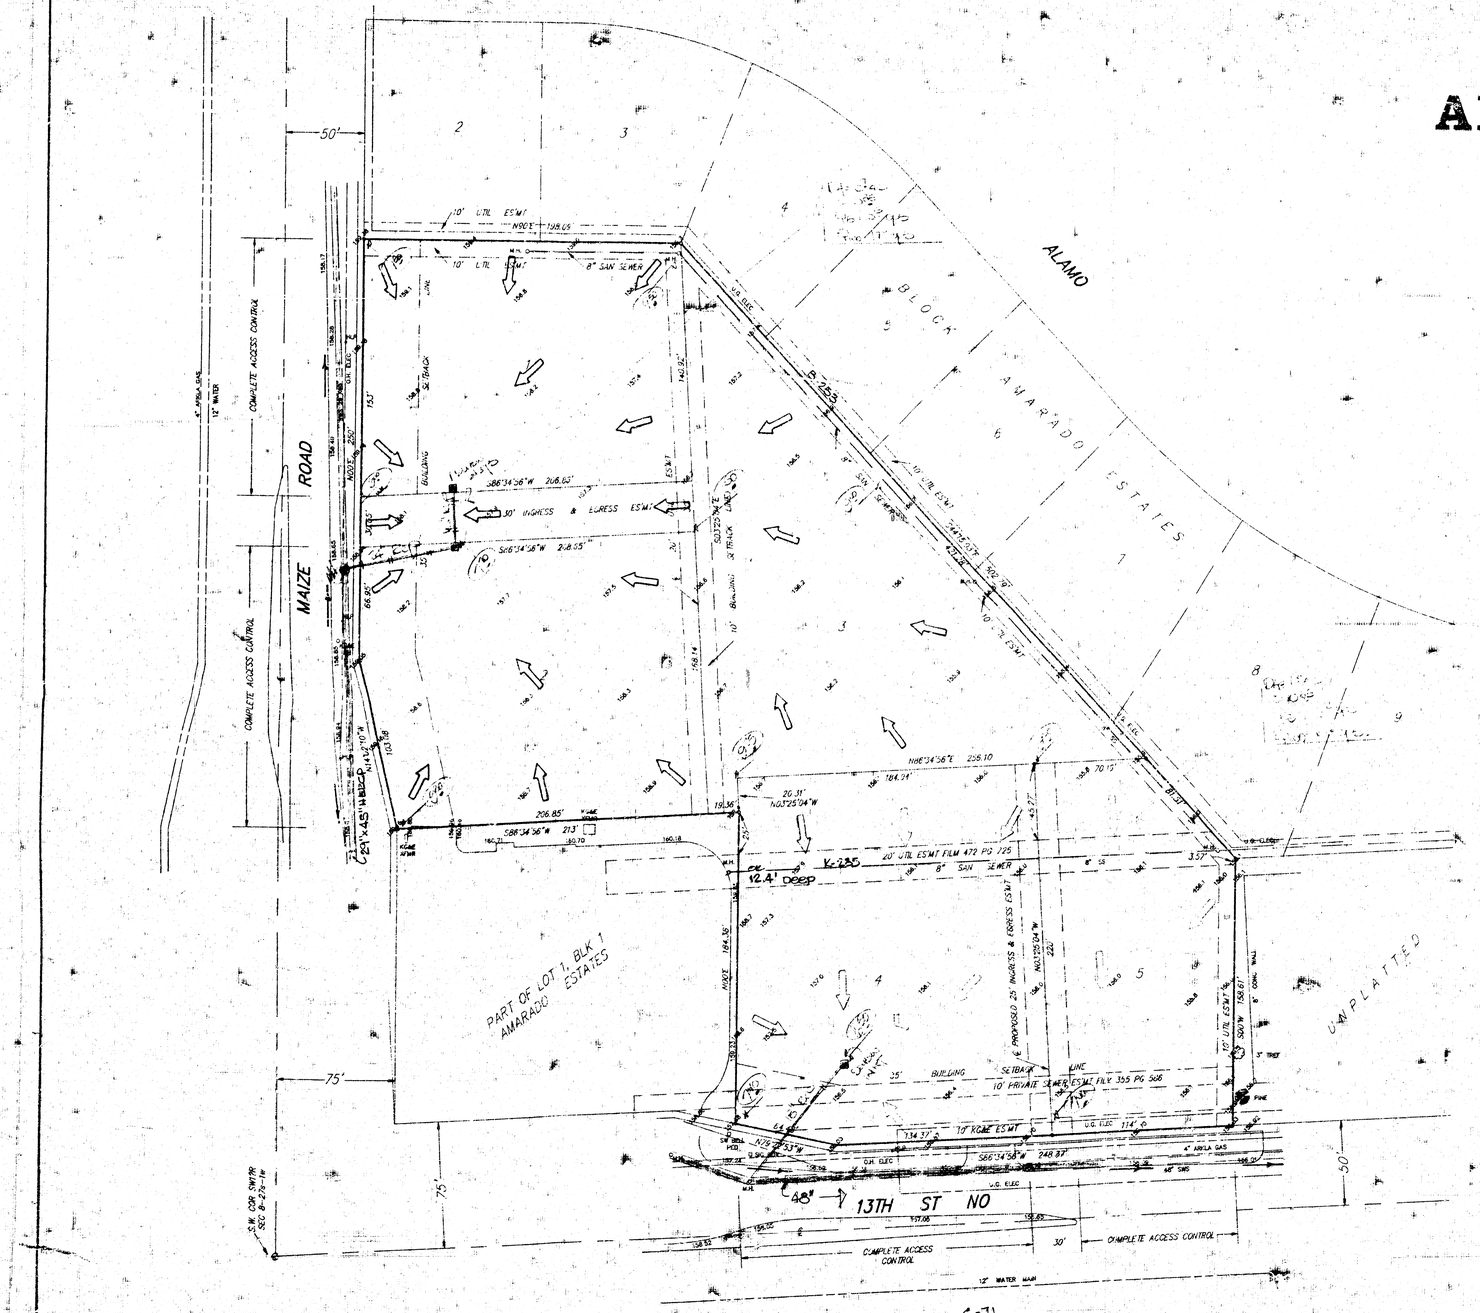

GENERAL NOTES

The proposed commercial lots will drain as indicated to private storm sewers which can be extended to serve the lots as development occurs on these lots. The proposed storm sewers can be co-ordinated to be installed with the site plan work in order to accomodate the developments.

All lots are presently served with public sanitary sewer and water lines.

DRAINAGE PLAN

BAUGHMAN COMPANY P. A.
ENGINEERING & SURVEYING
316/262-7271 • 315 ELLIS • WICHITA, KANSAS 67211

4 APRIL 1991

C-71
C-194 -10,15,17
MP 12 C 76 - 16 PM