


Ark Valley Christian Church Addition


# ARK VALLEY CHRISTIAN CHURCH ADDITION WICHITA, SEDGWICK COUNTY, KANSAS

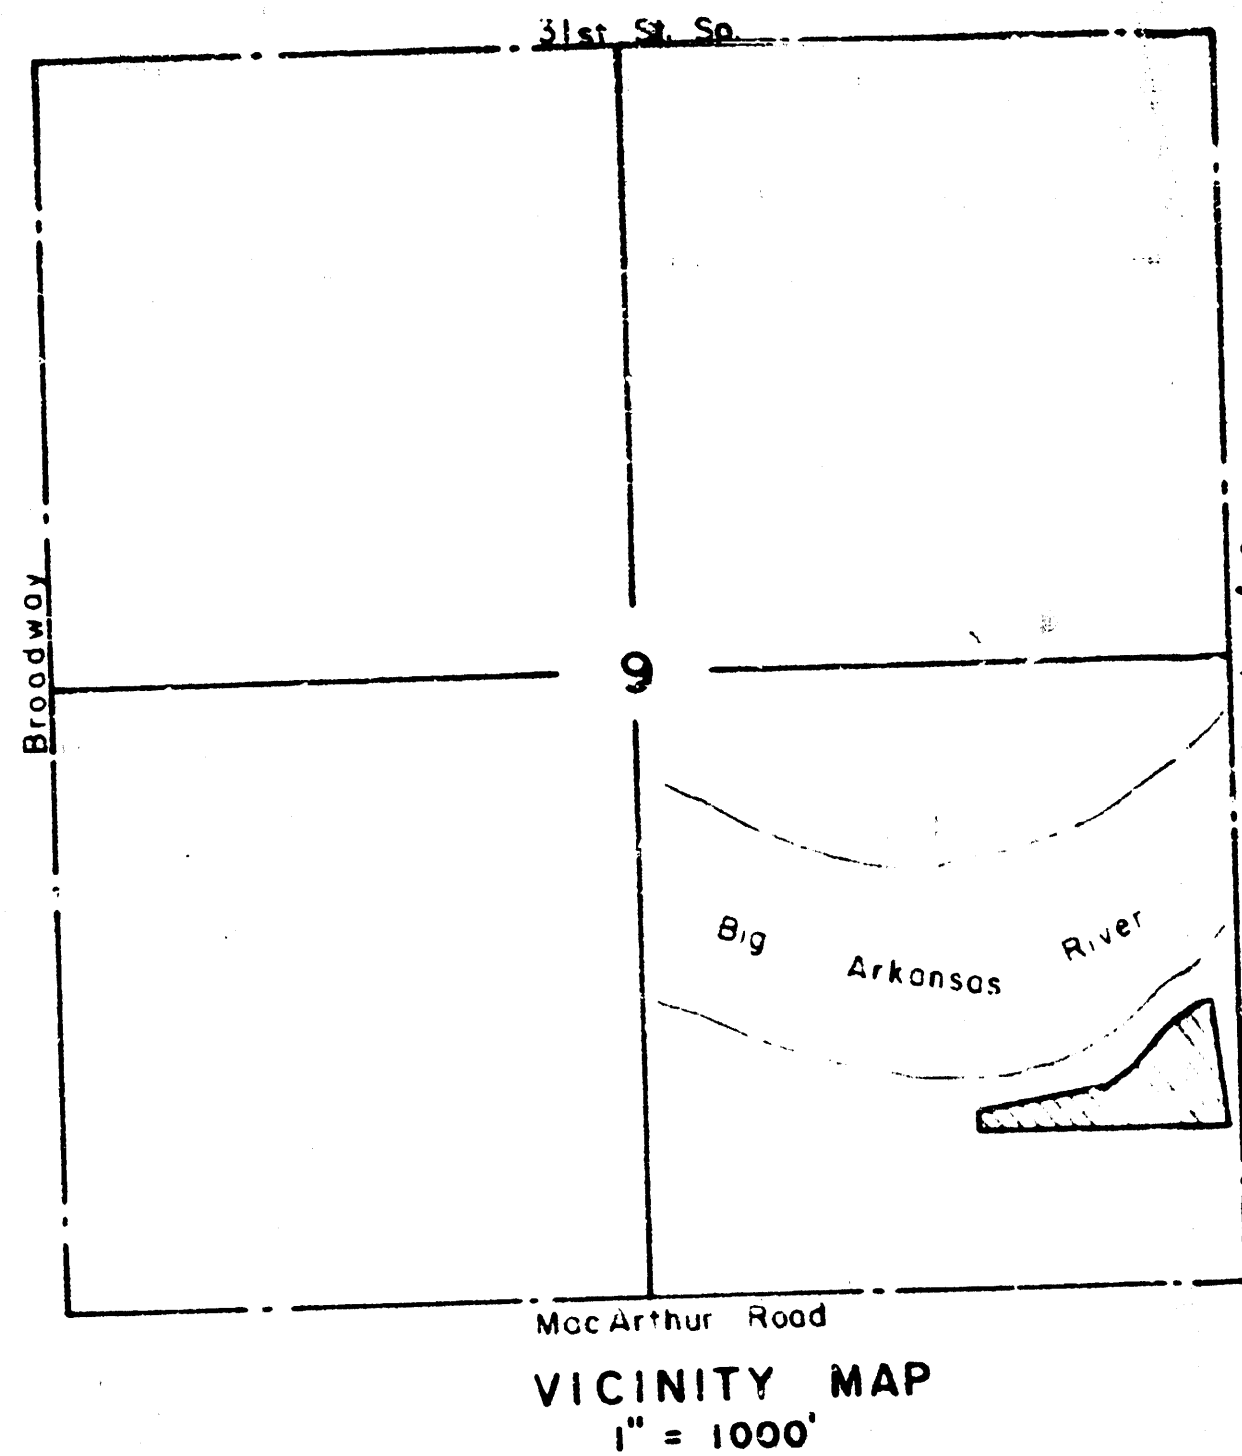


LOT = 0.2 ACRES

## DRAINAGE PLAN

GRADE LOT TO DRAIN TO EXISTING  
"BEE-HIVE" INLET 82' NORTH OF SE  
CORNER LOT 1.

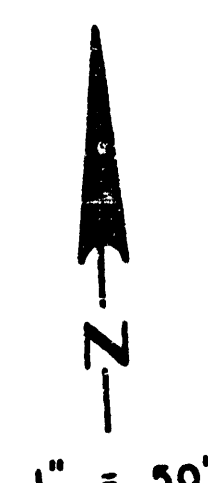

Min Pad. 1277  
City Data 89.6

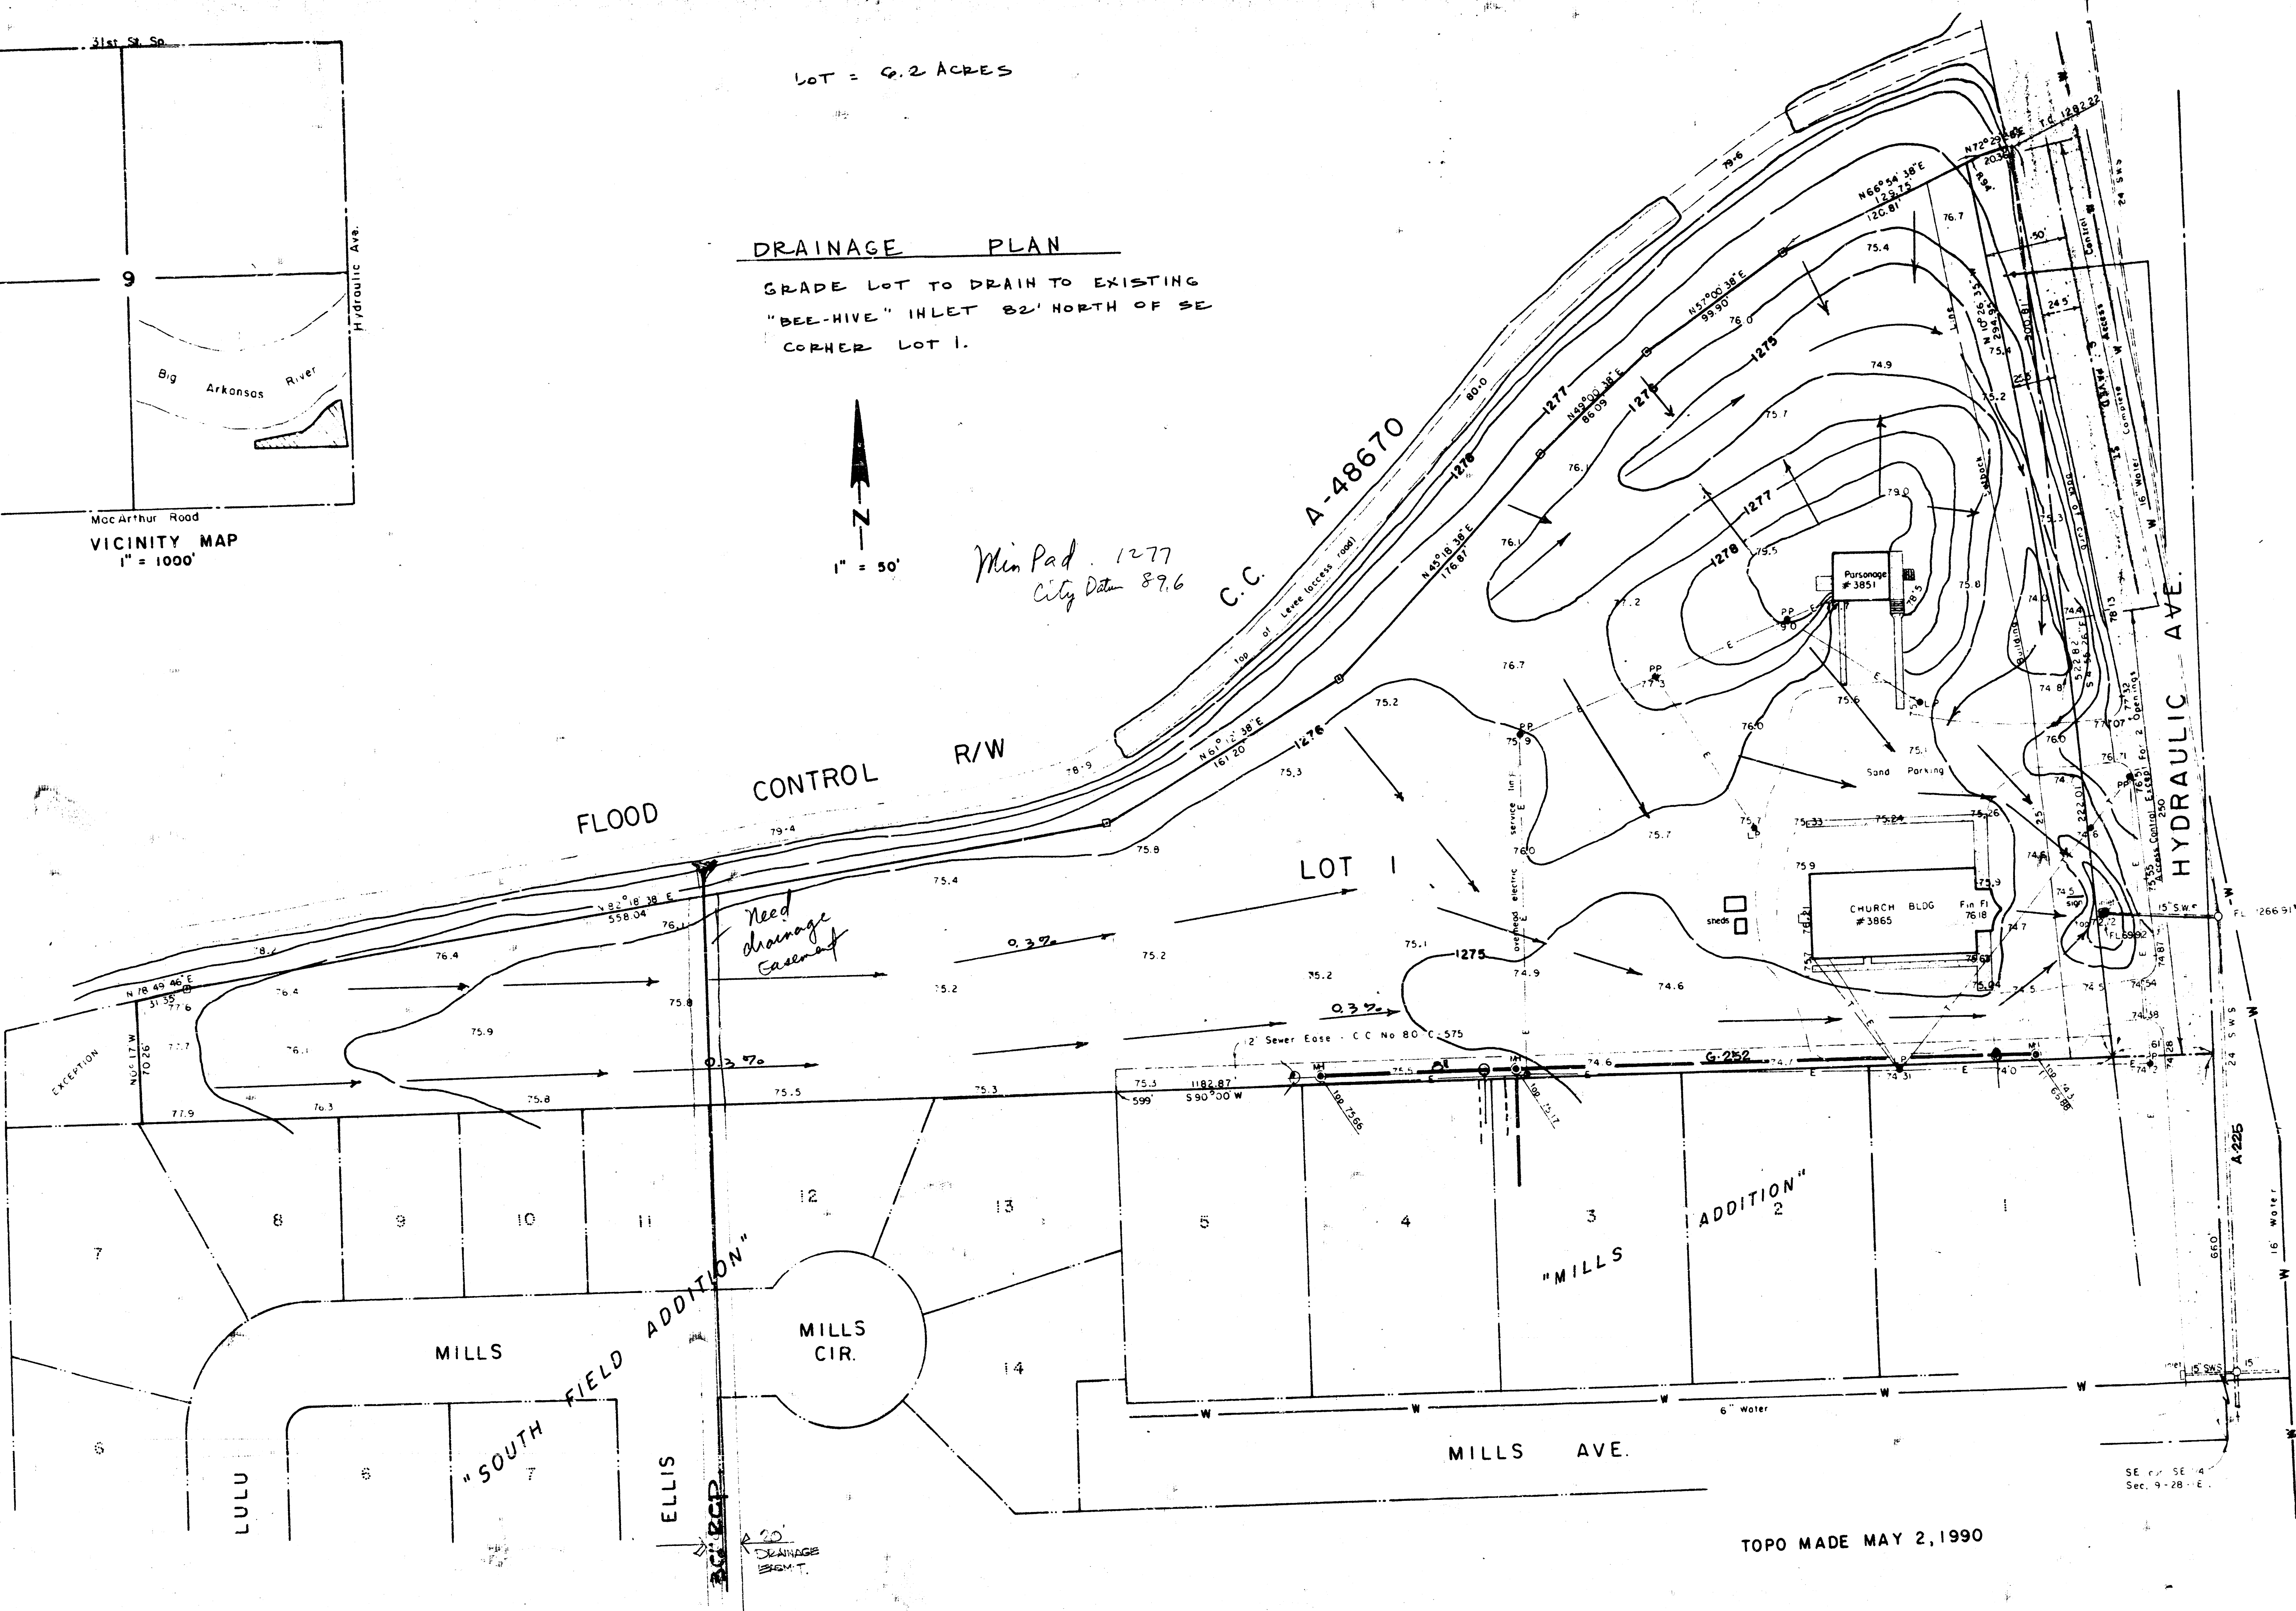

FOR:  
ARK VALLEY CHRISTIAN CHURCH  
3865 S. HYDRAULIC  
WICHITA, KANSAS

HI-TECH SURVEYORS, INC.  
334 S. LAURA  
WICHITA, KANSAS

B.M. - ELEV. 1274.28 - "□" on top of curb at SE  
cor. of property.