


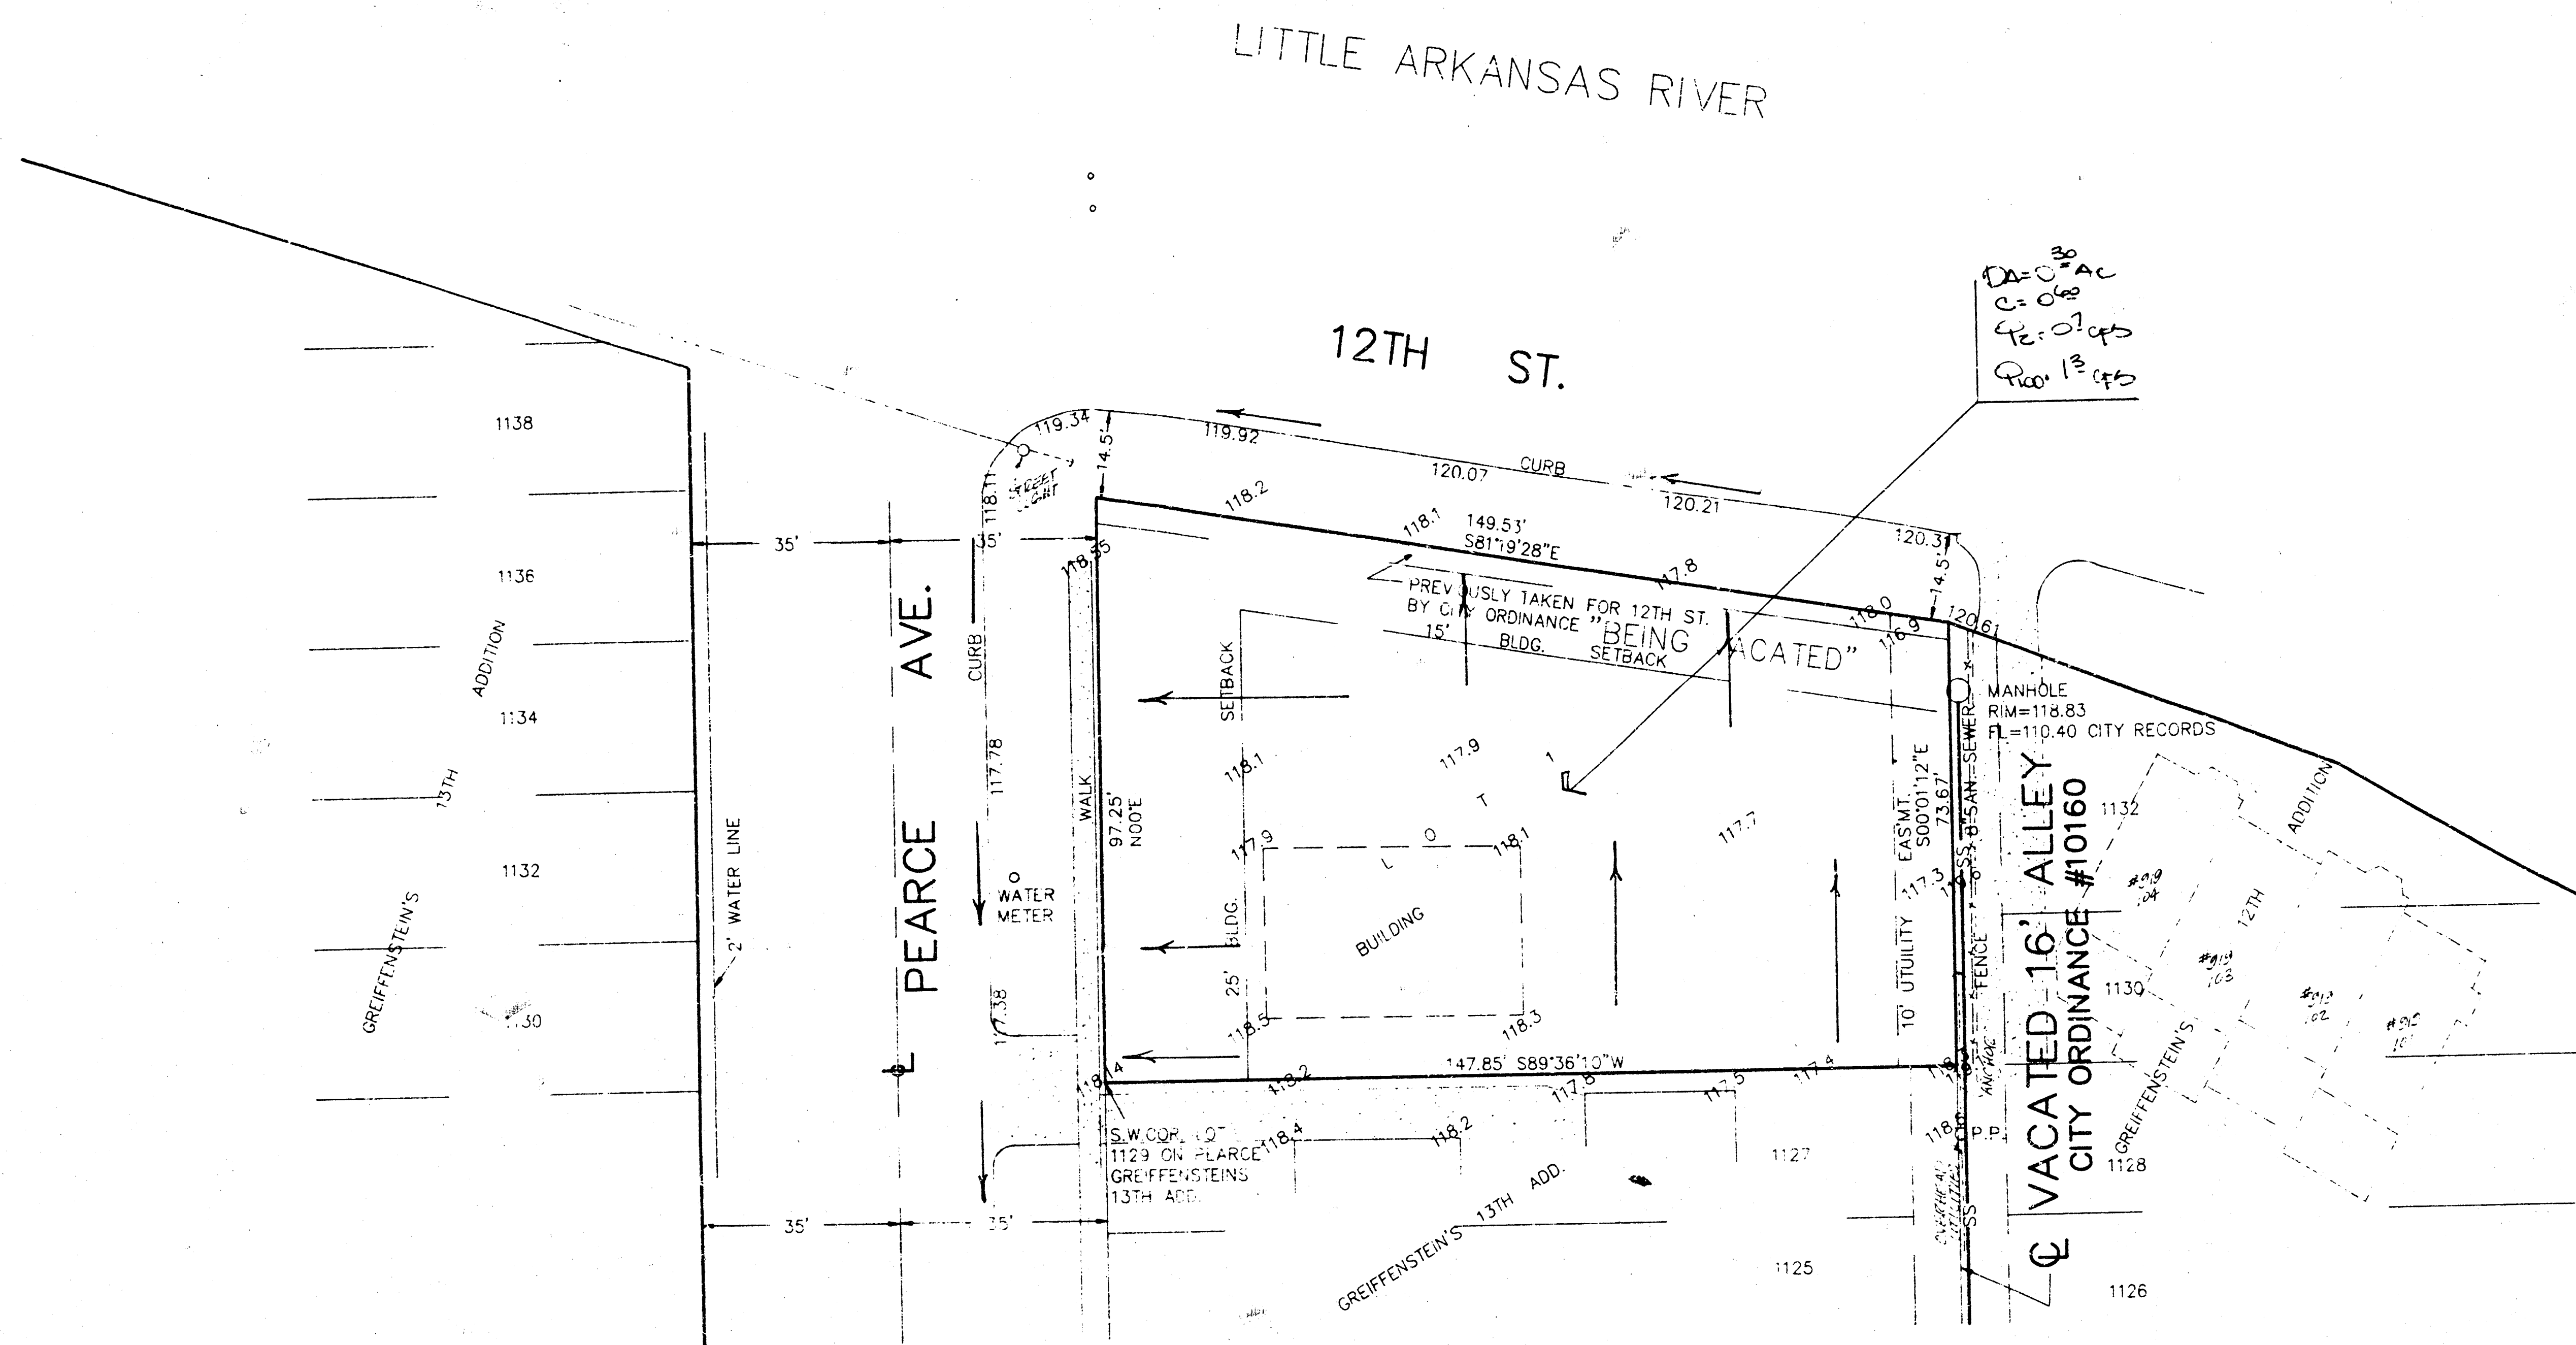

All of Lots 1129, 1131, 1133, and Lot 1135 except that part taken for 12th St. City Ordinance, all on Pearce Ave. together with the W 1/4 of vacated Alley adjacent on the east, all in Graffenstein's Thirteenth Addition to the City of Wichita, Sedgewick County, Kansas, and together with a portion of 12 St. 

The above described portion of street and alley are hereby vacated by virtue of K.S.A. 12-512 (b).

# DRAINAGE plan

**APPROVED  
DRAINAGE PLAN**



BAUGHMAN COMPANY P.  
SURVEYING & ENGINEERING  
316/262-7271 • 315 ELLIS • WICHITA, KANSAS 67211

MAY 17 1964

FILMED FROM THE BEST