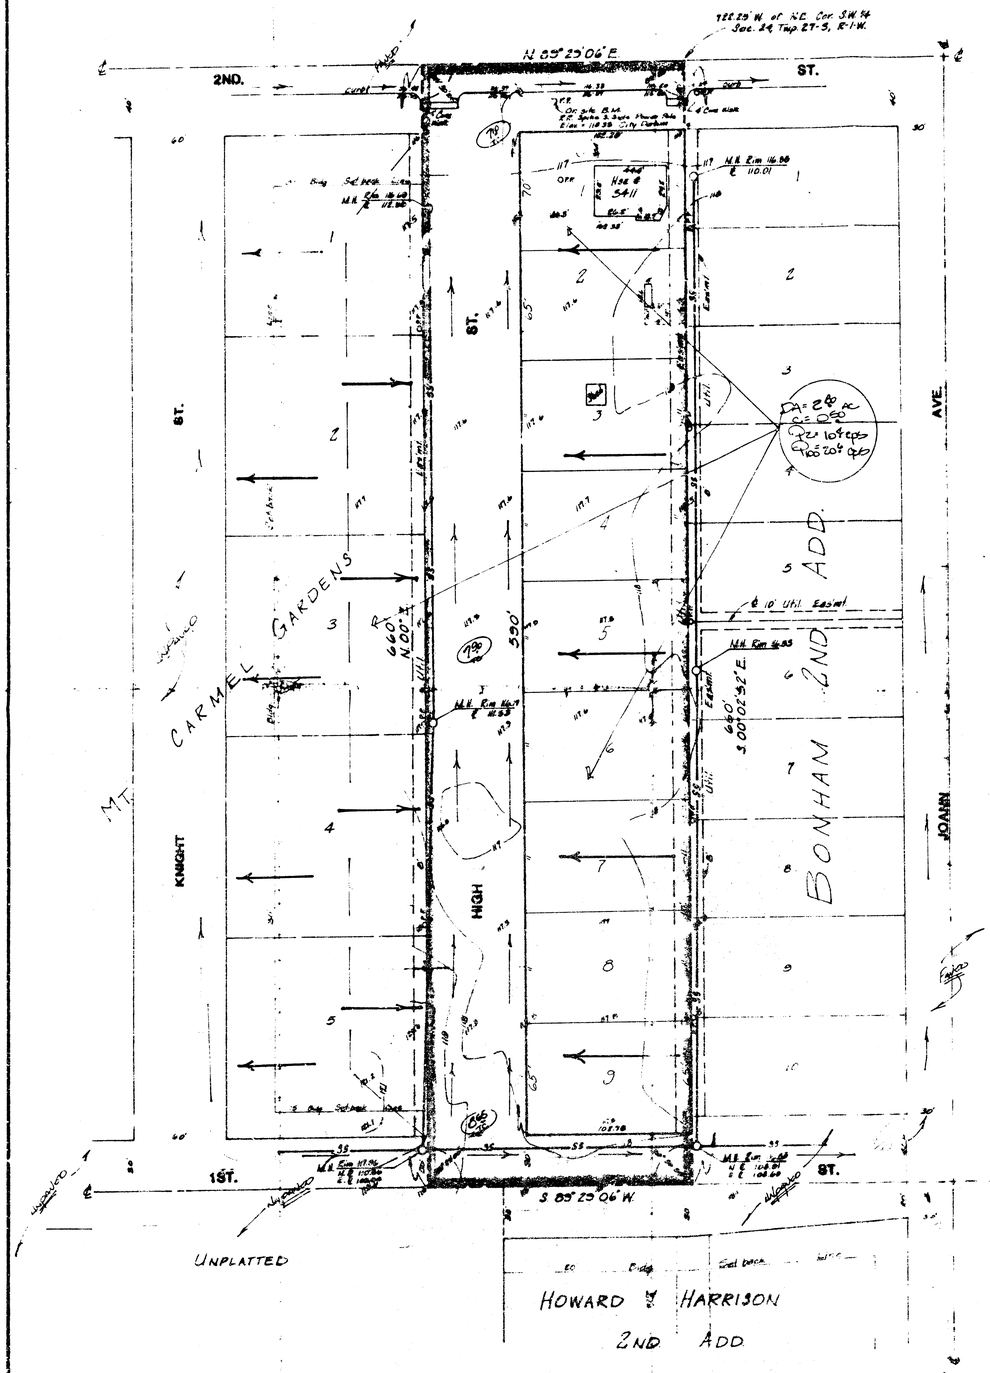


PRELIMINARY PLAT

BADER 3RD ADDITION


PART OF THE S.W. 1/4
SEC. 24, TWP. 27-S, R-1-w W.

GERALD BADER

N

Scale: 1" = 40'
Elevation - City Datum

BENCH MARK
City Standard Disc 34' N
& 8' S of Q West St
and 2nd St.
Elevation - 118.87 City Datum

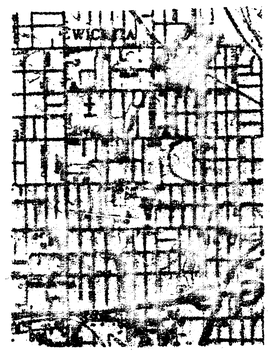

VICINITY MAP
1" = 2000'

General Notes


The lots are residential and will drain to the streets discharging thru driveways. High Street when paved will drain as the proposed grades will allow. Joann and 2nd streets are paved and drain north and east respectfully. Knight is unpaved and drains north to 2nd Street. 1st street is unpaved and will drain east to Joann when paved.

Revised
7-26-87 Revised.
6-10-86

DRAINAGE PLAN

BAUMAN COMPANY, P.A.
SURVEYING & ENGINEERING
June 86

FILMED FROM THE BEST AVAILABLE COPY

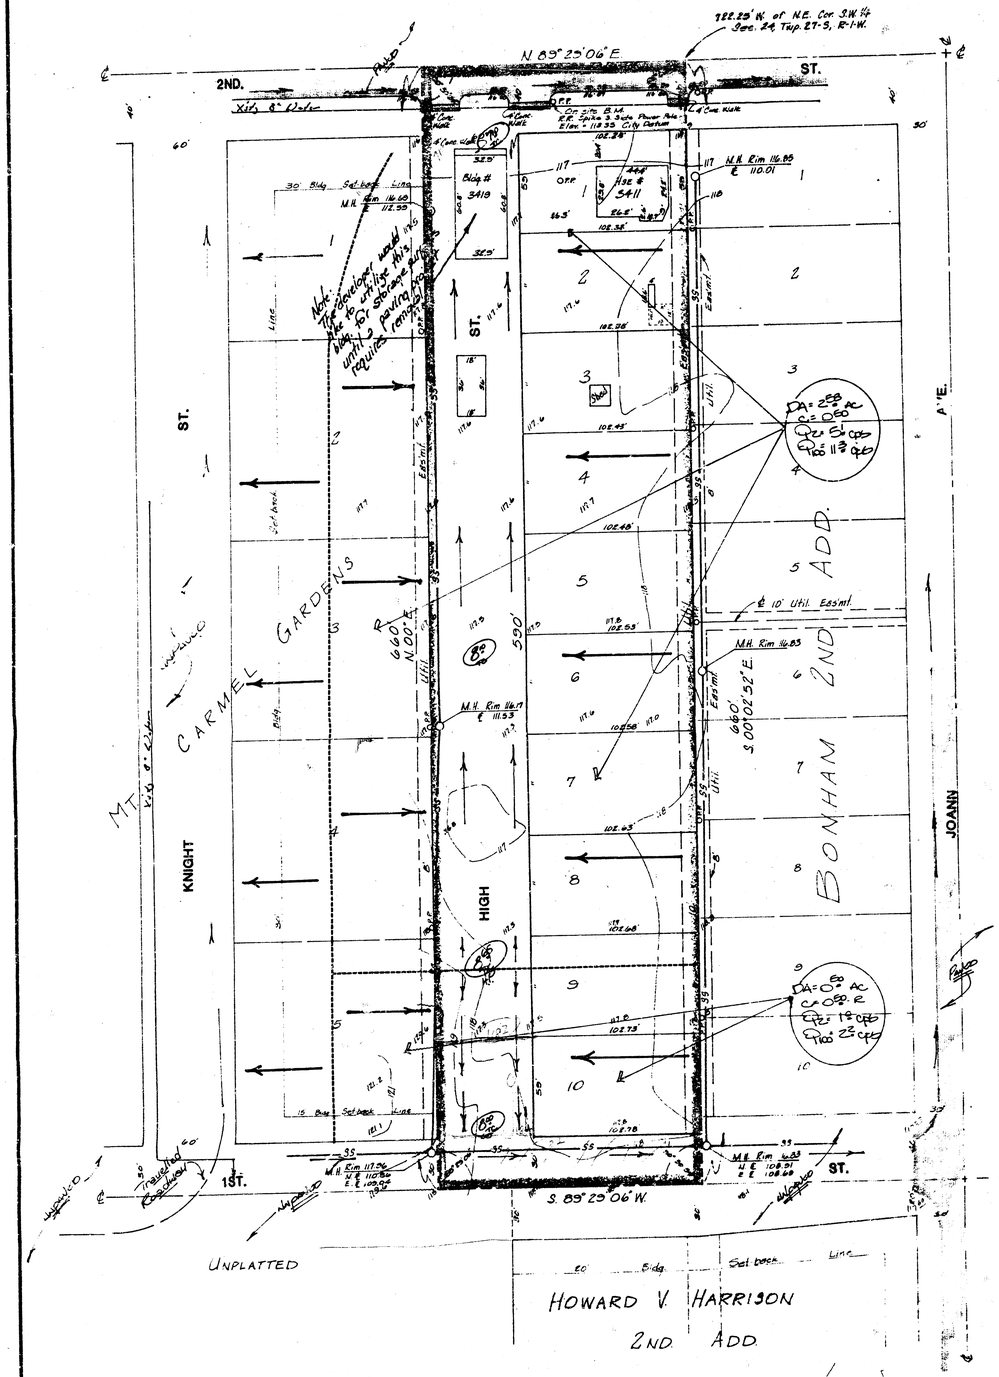


PRELIMINARY PLAT

BADER 3RD ADDITION


PART OF THE S.W. 1/4
SEC. 24, TWP. 27-S., R-1-w W.

GERALD BADER

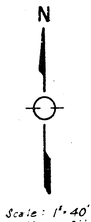

Scale: 1"=40'
Elevation = City Datum

BENCH MARK
City Standard Disc 34 W
± 18' S of ℄ West St
and 2nd St.
Elevation = 118.87 City Datum

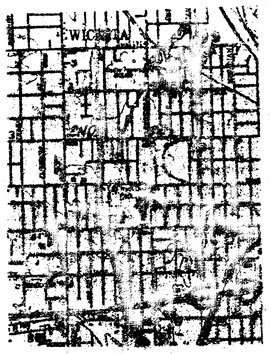

VICINITY MAP
1"=2000'

General Notes

The lots are residential and will drain o the streets dis-
charging thru driveways. High Street whe p- ed will drain as
the proposed grades will allow. Joann and 2 Streets are paved and
drain north and east respectfully. Knight i- npaved and drains
north to 2nd Street. 1st Street is unpaved l unopened presently
and will drain east to Joann when paved and ned to traffic.

Void

DRAINAGE PLAN

6-10-85

BAUKMAN COMPANY, P.A. June 85
SURVEYING & ENGINEERING

FILMED FROM THE BEST AVAILABLE COPY