


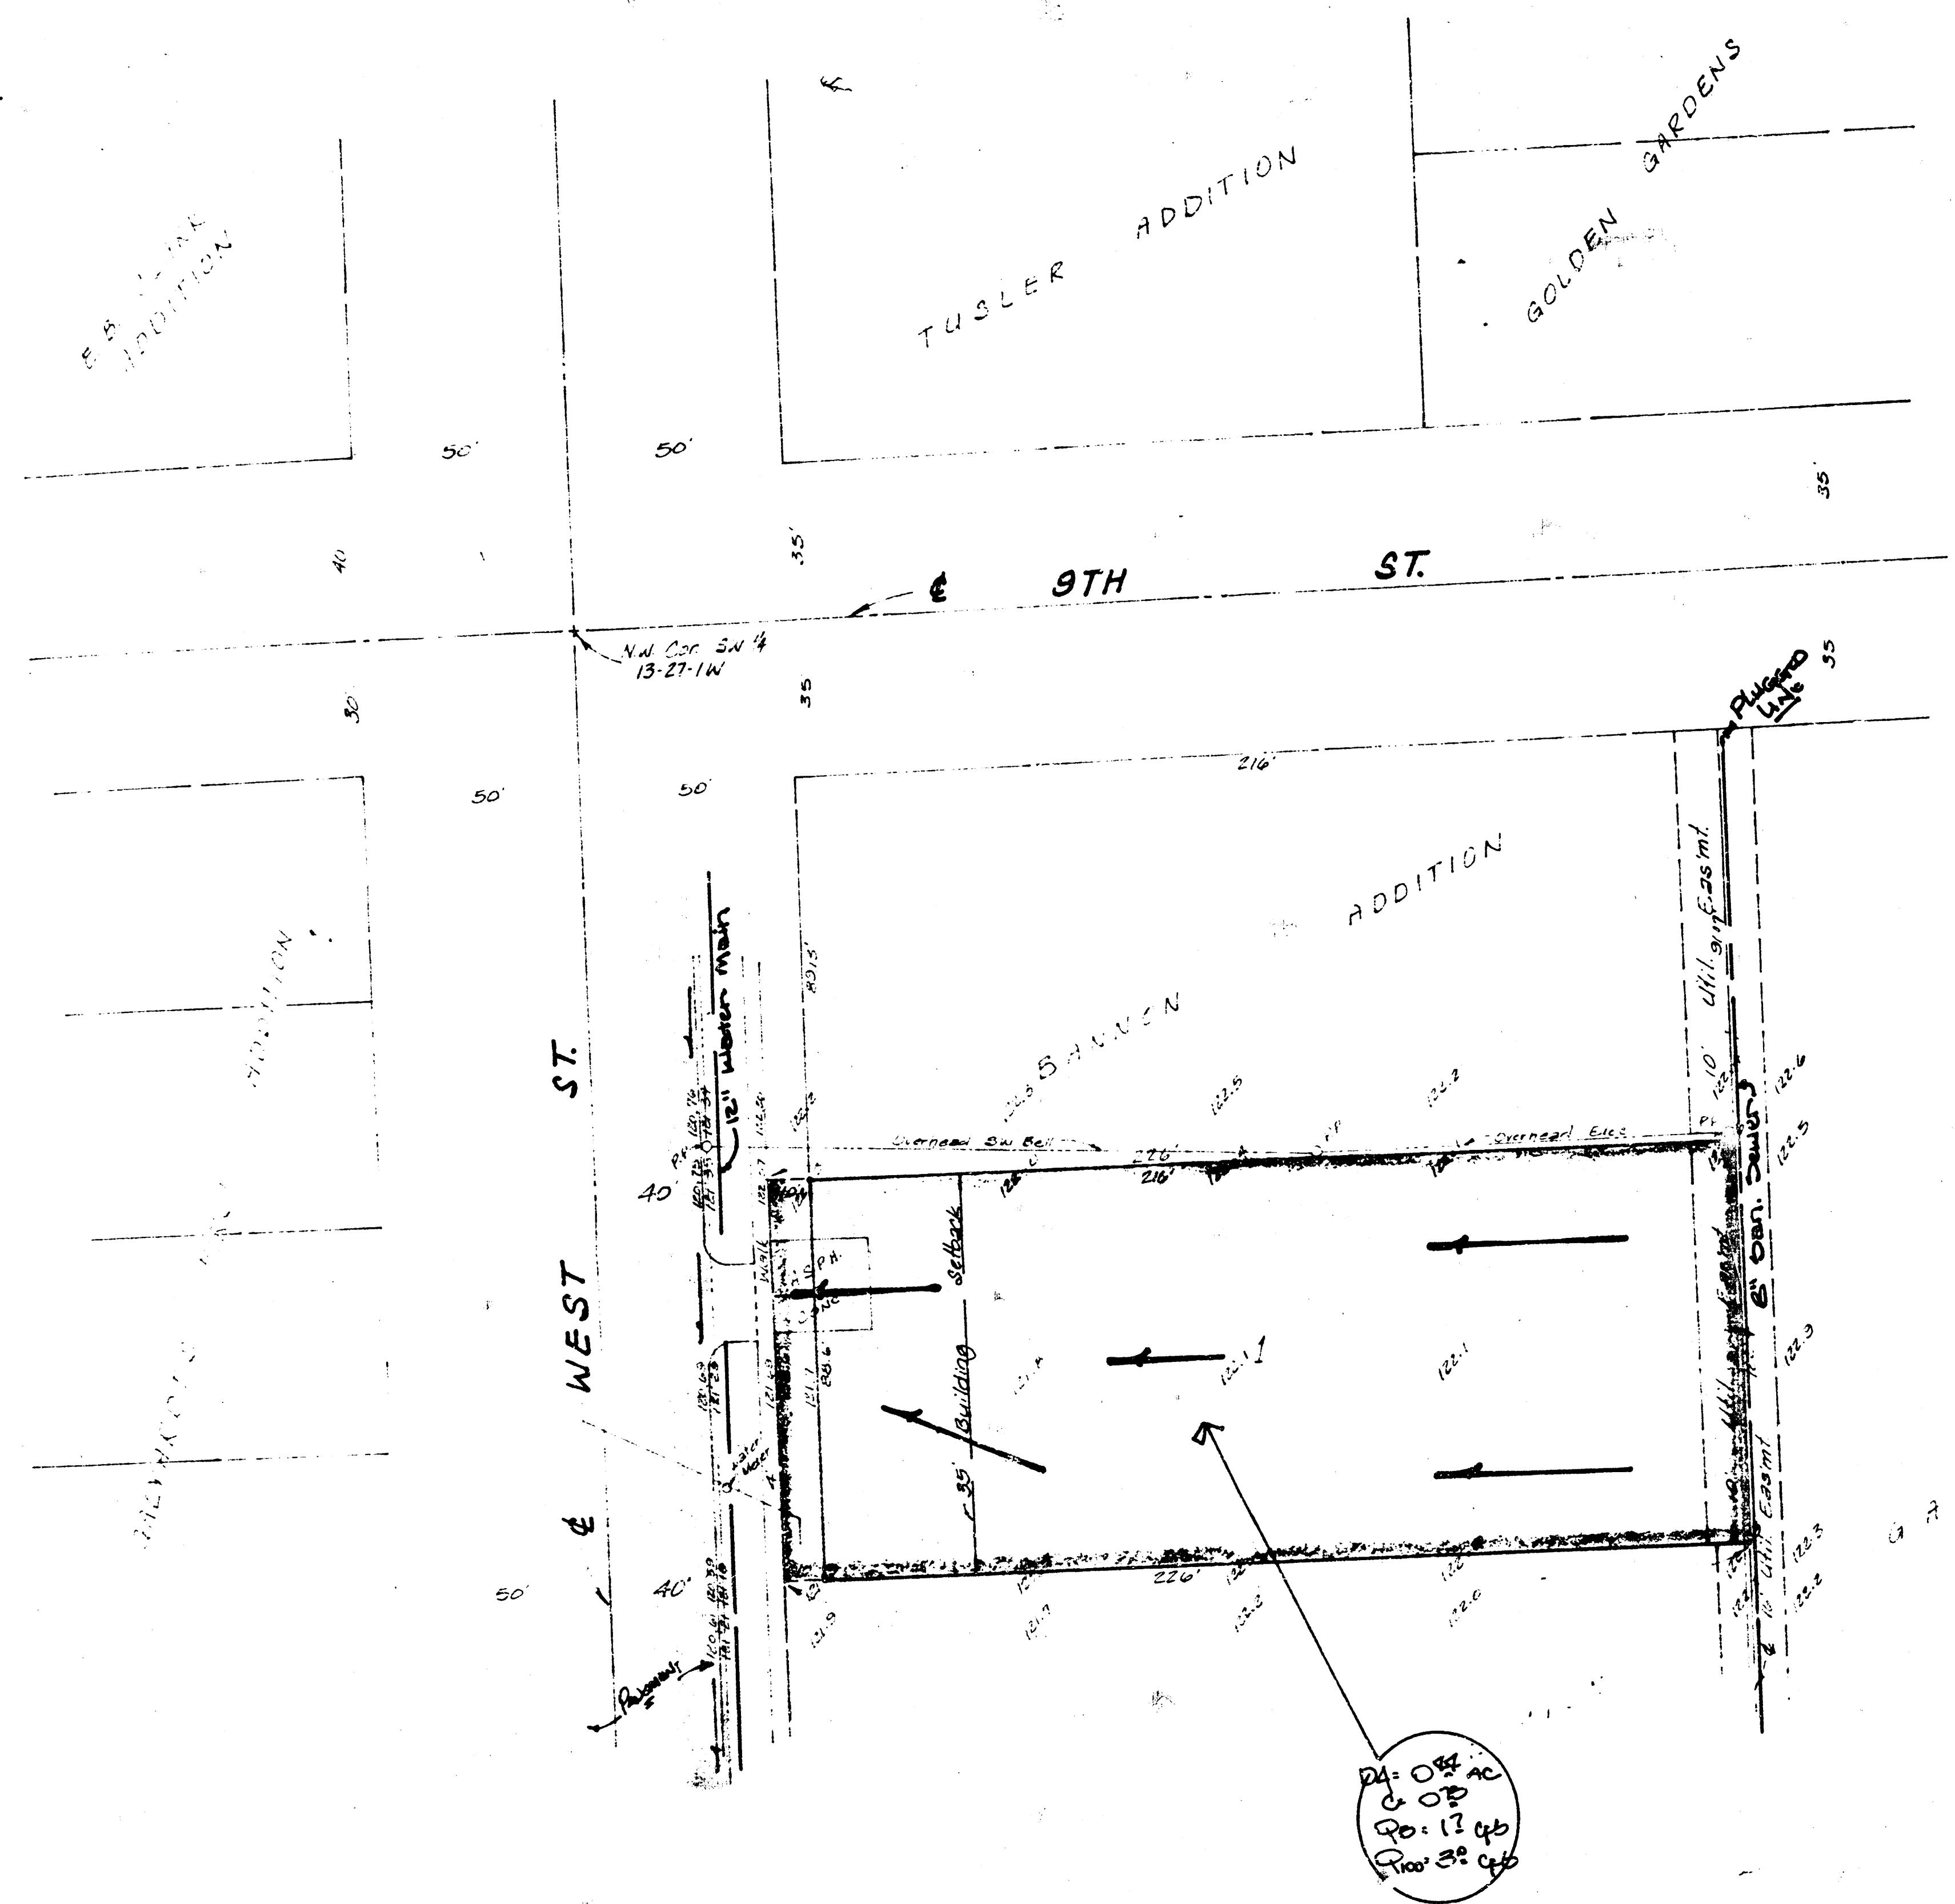

SKETCH PLAT

BANNON 2ND ADDITION

REPLAT OF LOT 2 NEWTON GARDENS SEDGWICK COUNTY, KANSAS

General Notes:
The commercial lot when developed shall drain West to West St. and discharge to the street thru the driveway. West St. drains south and into an inlet & storm sewer approx. 100' S. of this property.

OWNER: JEFF BANNON

DRAINAGE PLAN

BAUGHMAN COMPANY, P.A.
SURVEYING & ENGINEERING
316/263-7271 • 330 LAURA • WICHITA, KANSAS 67211

14 NOVEMBER 1985

FILMED FROM THE BEST
AVAILABLE COPY.....