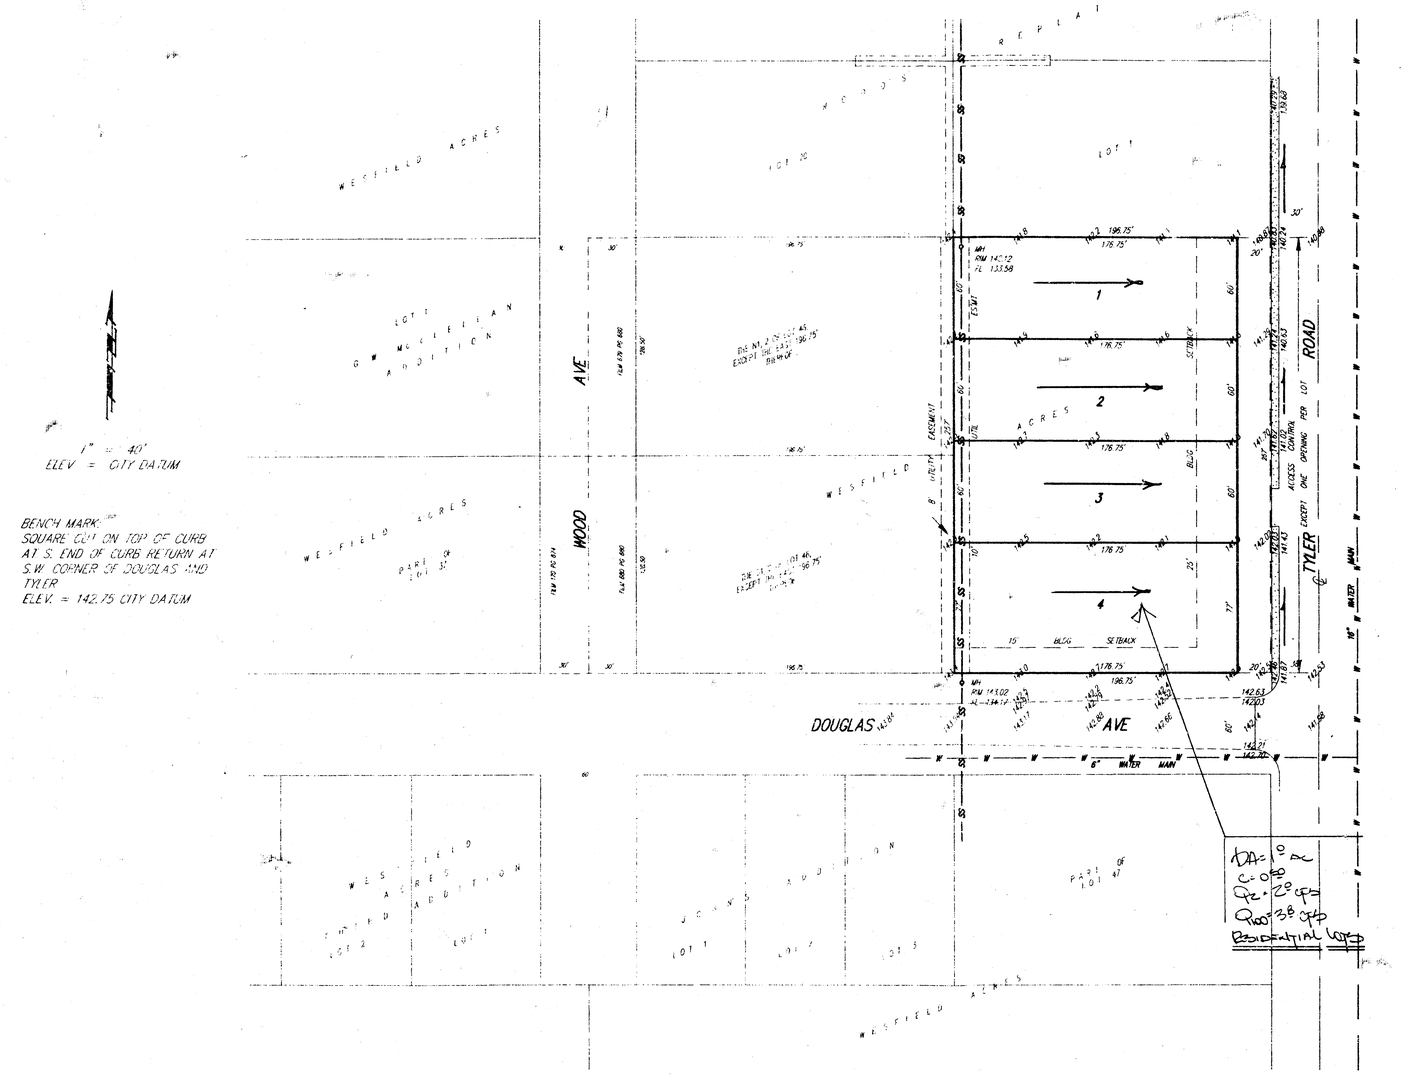

SKETCH PLAT

R. BEARD ADDITION

WICHITA, SEDGWICK COUNTY, KANSAS

THE EAST 196.75 FEET OF LOT 46, WESTFIELD ACRES, SEDGWICK COUNTY, KANSAS.

RONNIE BEARD
7617 W. NANTUCKET
WICHITA, KS 67212

PH. 722-4894

DRAINAGE PLAN

BAUGHMAN COMPANY P. A.
SURVEYING & ENGINEERING
316/262-7271 • 315 ELLIS • WICHITA, KANSAS 67211

1 SEP 92