


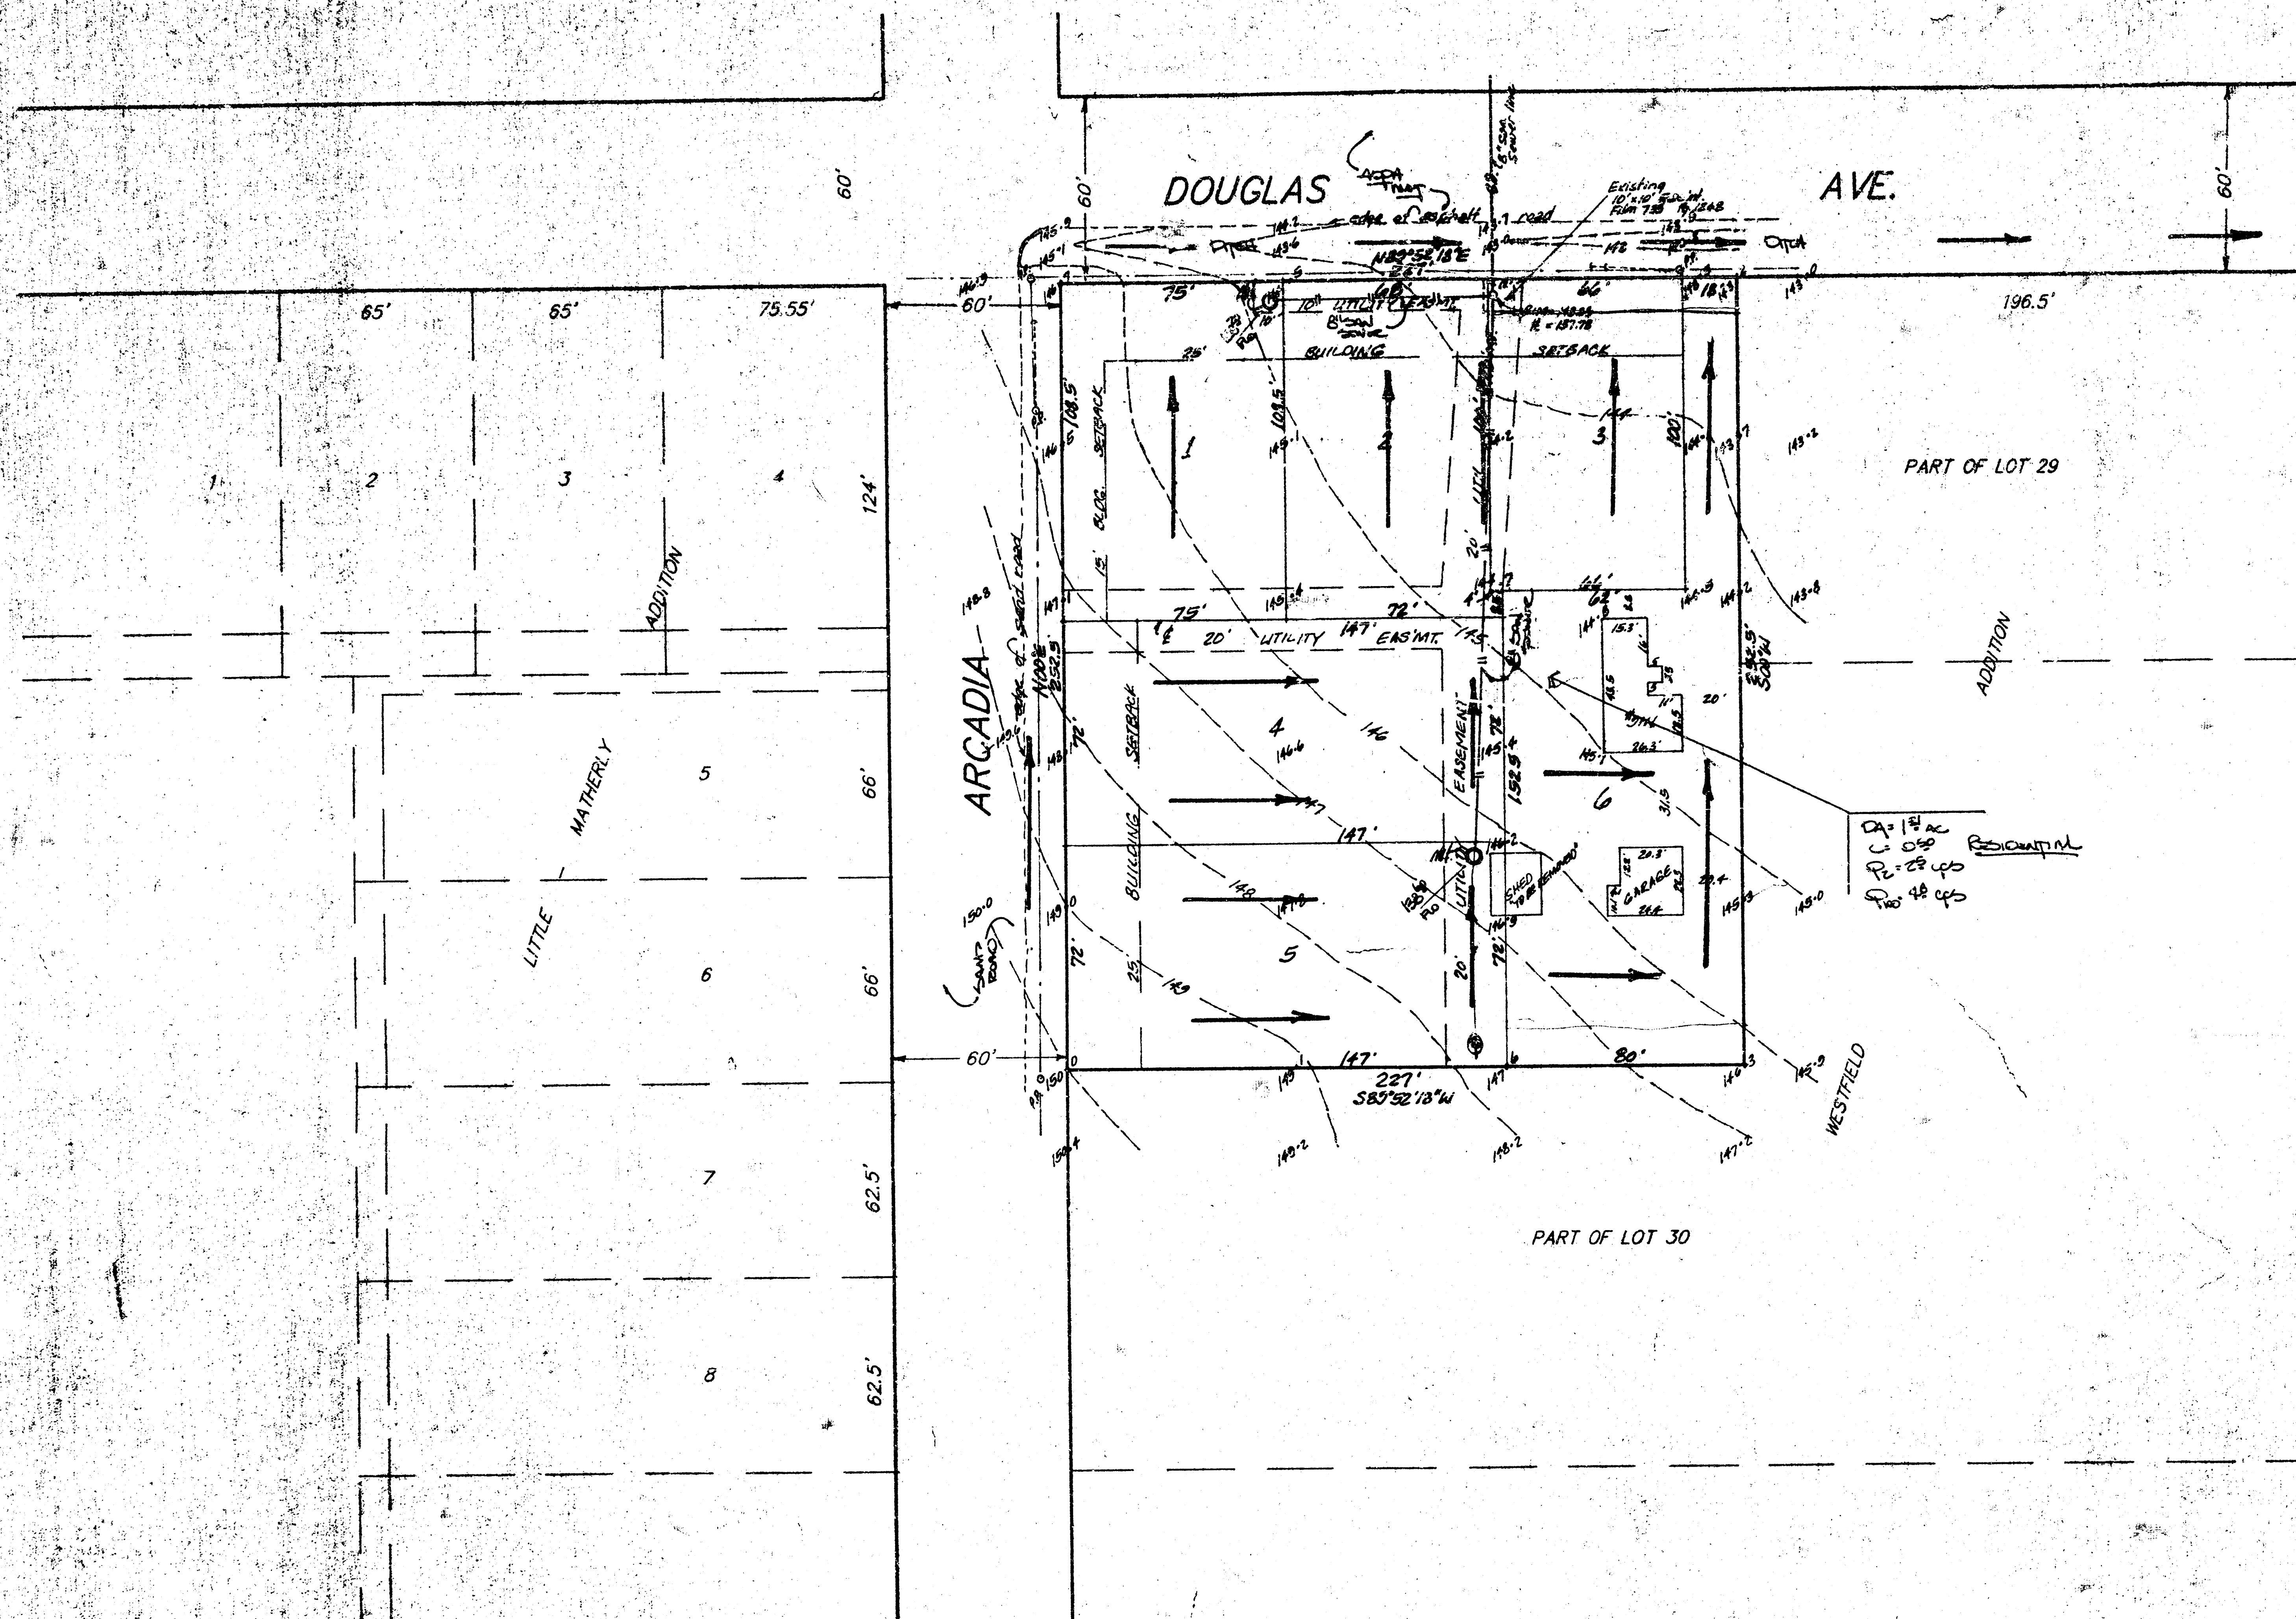

SKETCH PLAT **BERLIN ADDITION**

A REPLAT OF THE WEST 227 FEET OF LOT 29, AND THE WEST 227 FEET OF THE N. 1/2 OF LOT 30, WESTFIELD ACRES, SEDGWICK COUNTY, KANSAS

OWNER: JESSE BERLIN

DRAINAGE & UTILITY PLAN

BAUGHMAN COMPANY P. A.
 SURVEYING & ENGINEERING
 314/252-7271 • 215 MAIN • WICHITA, KANSAS 67201

ALC 25 1291